




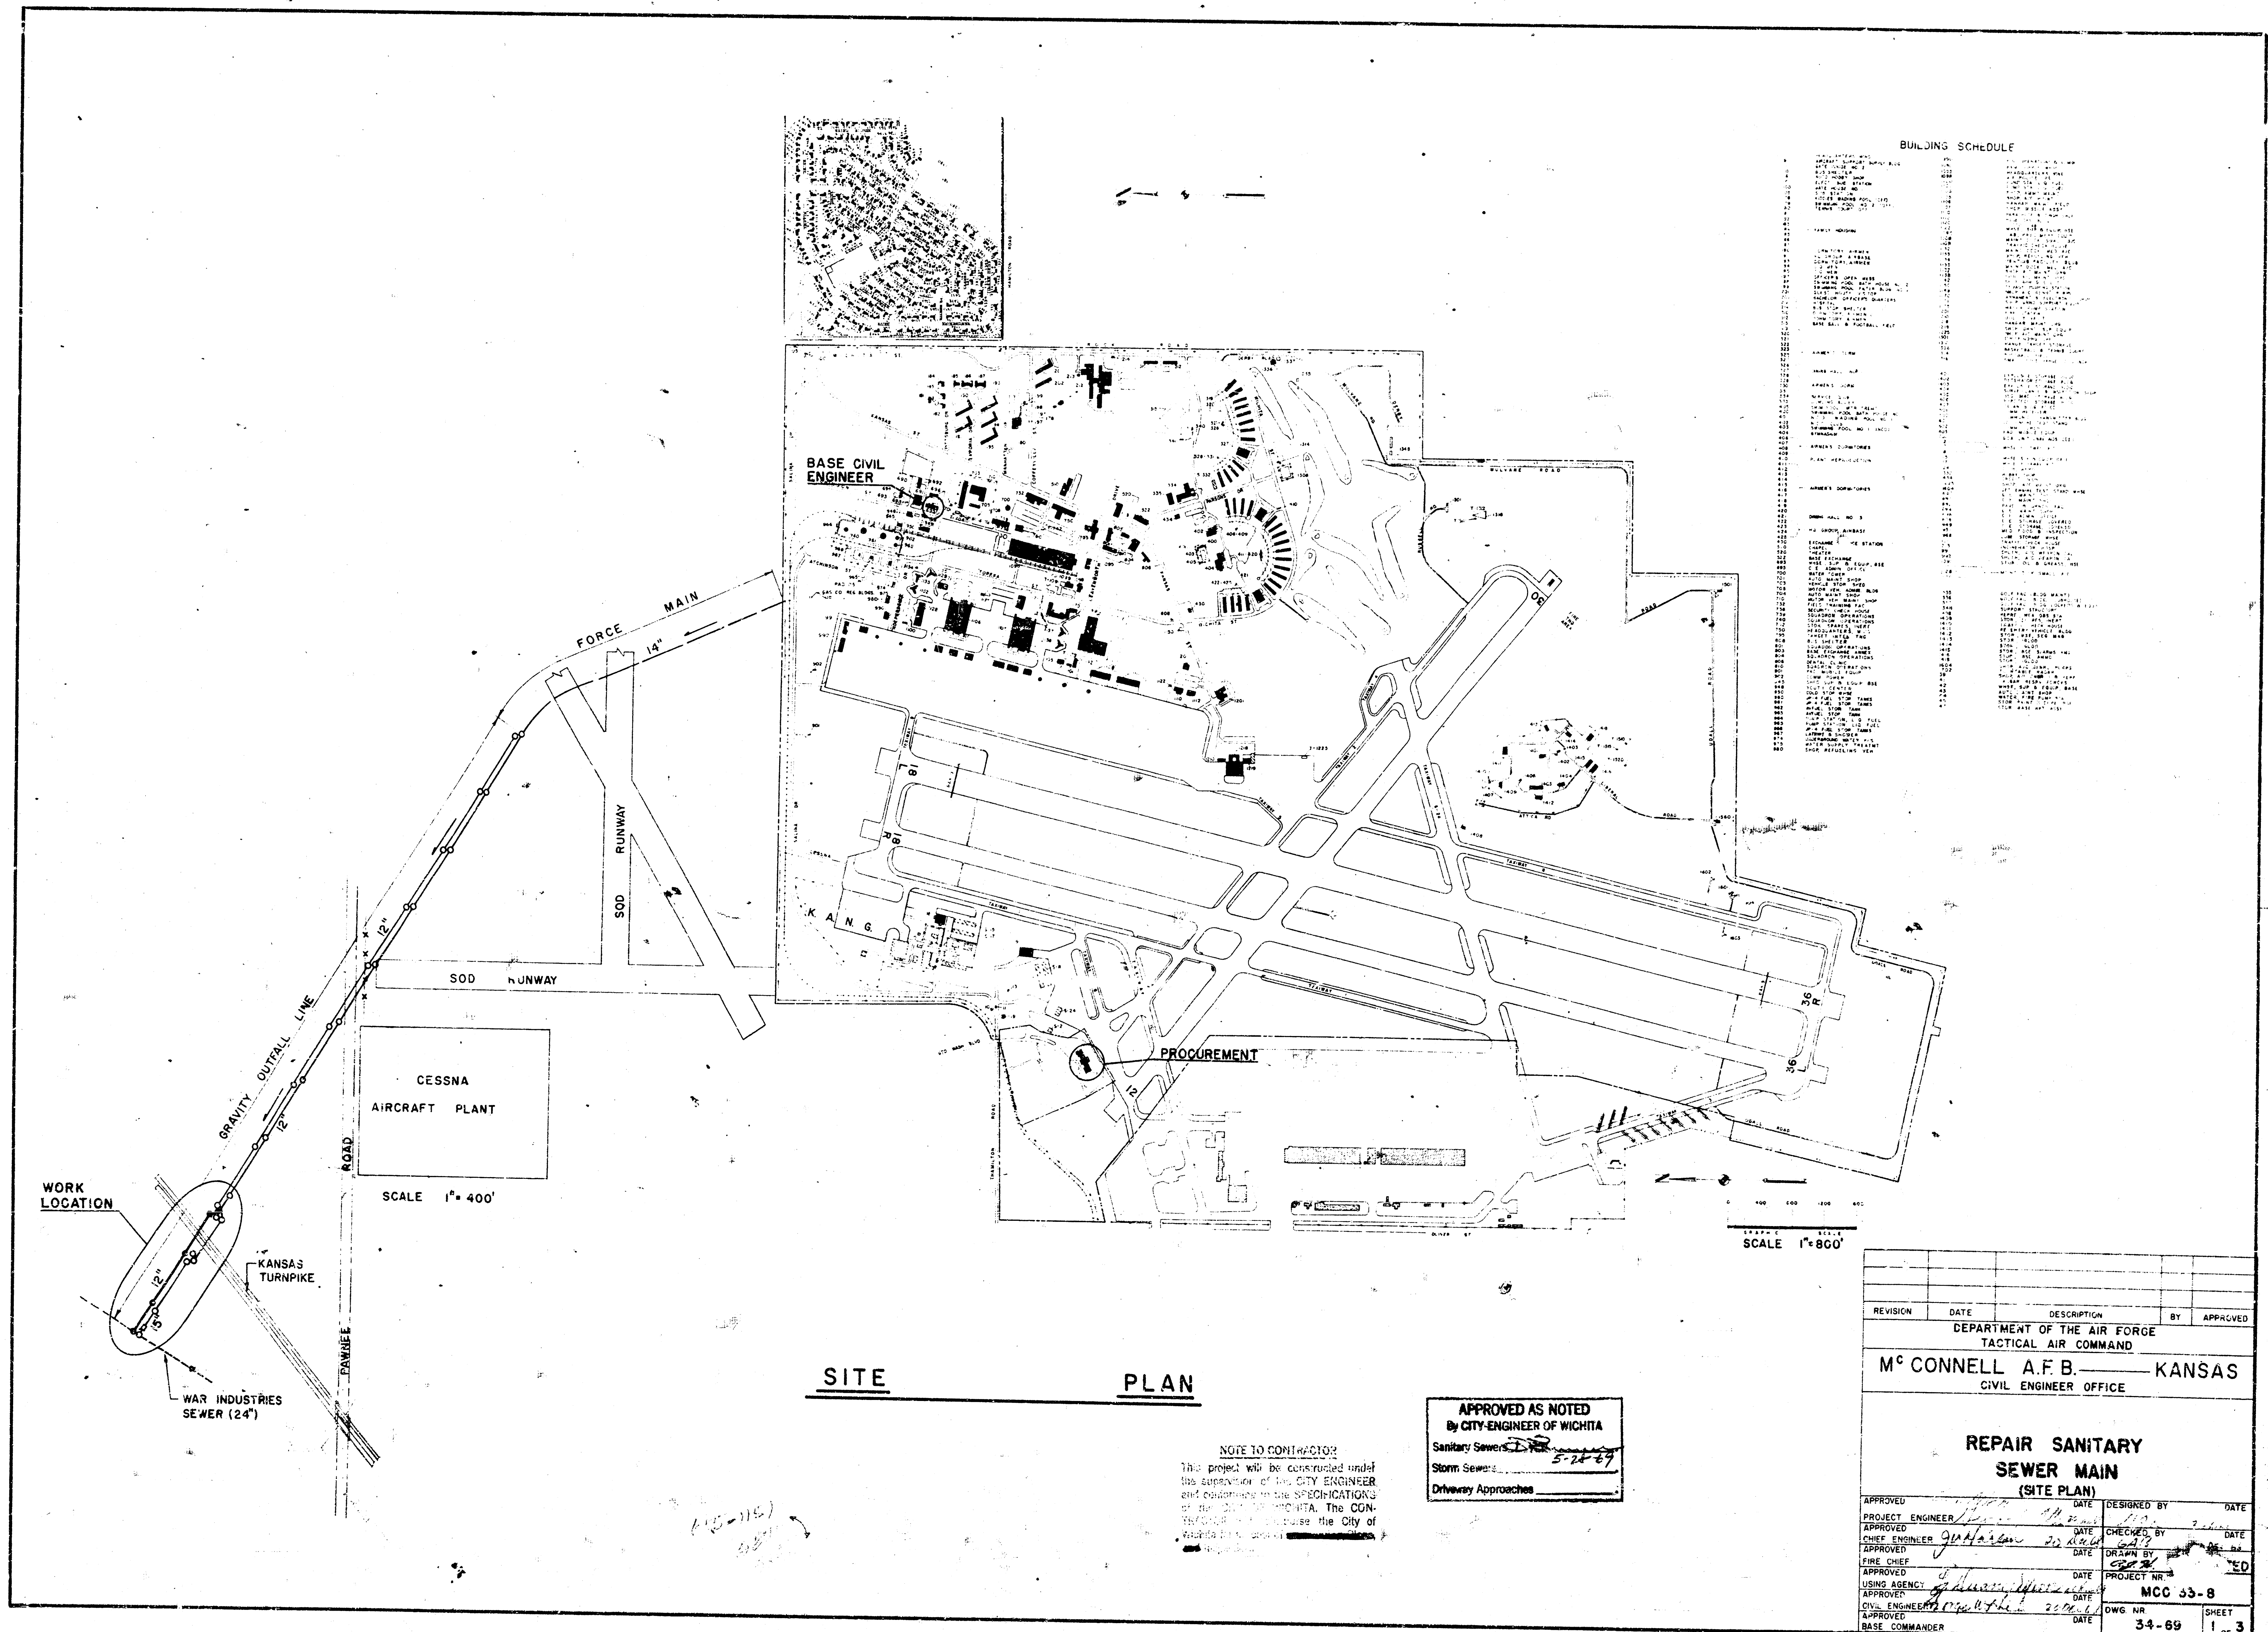

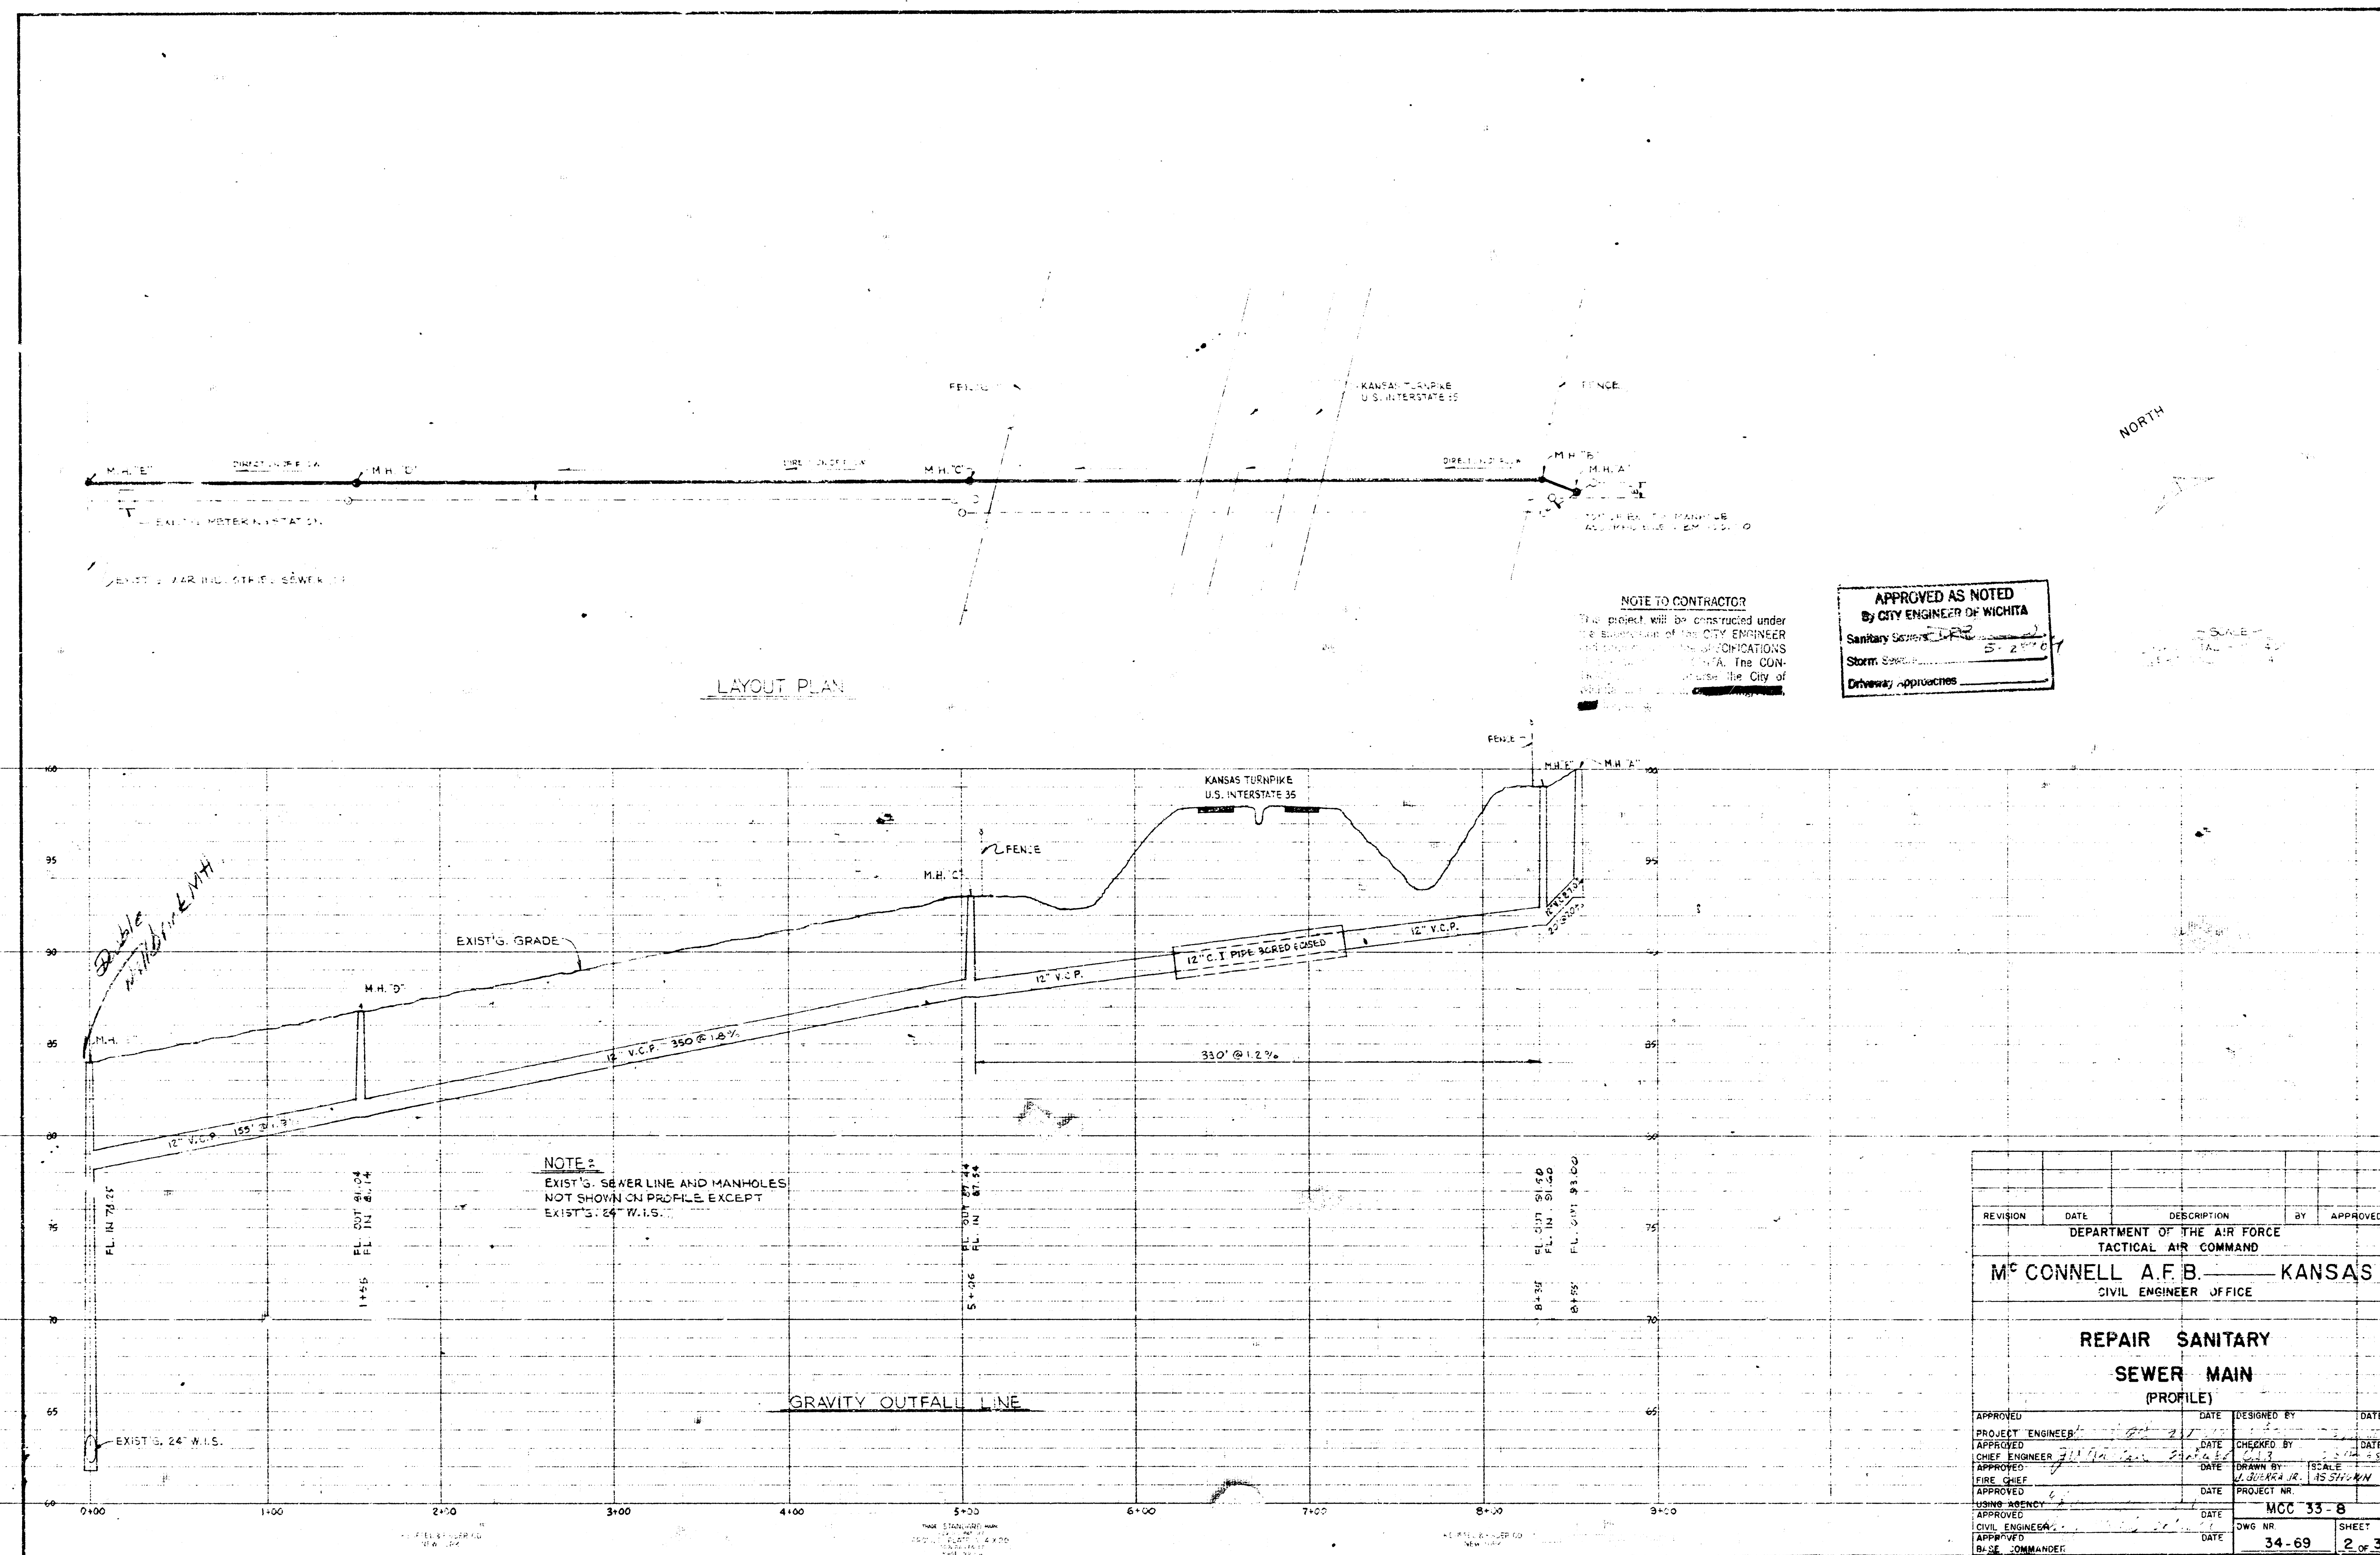

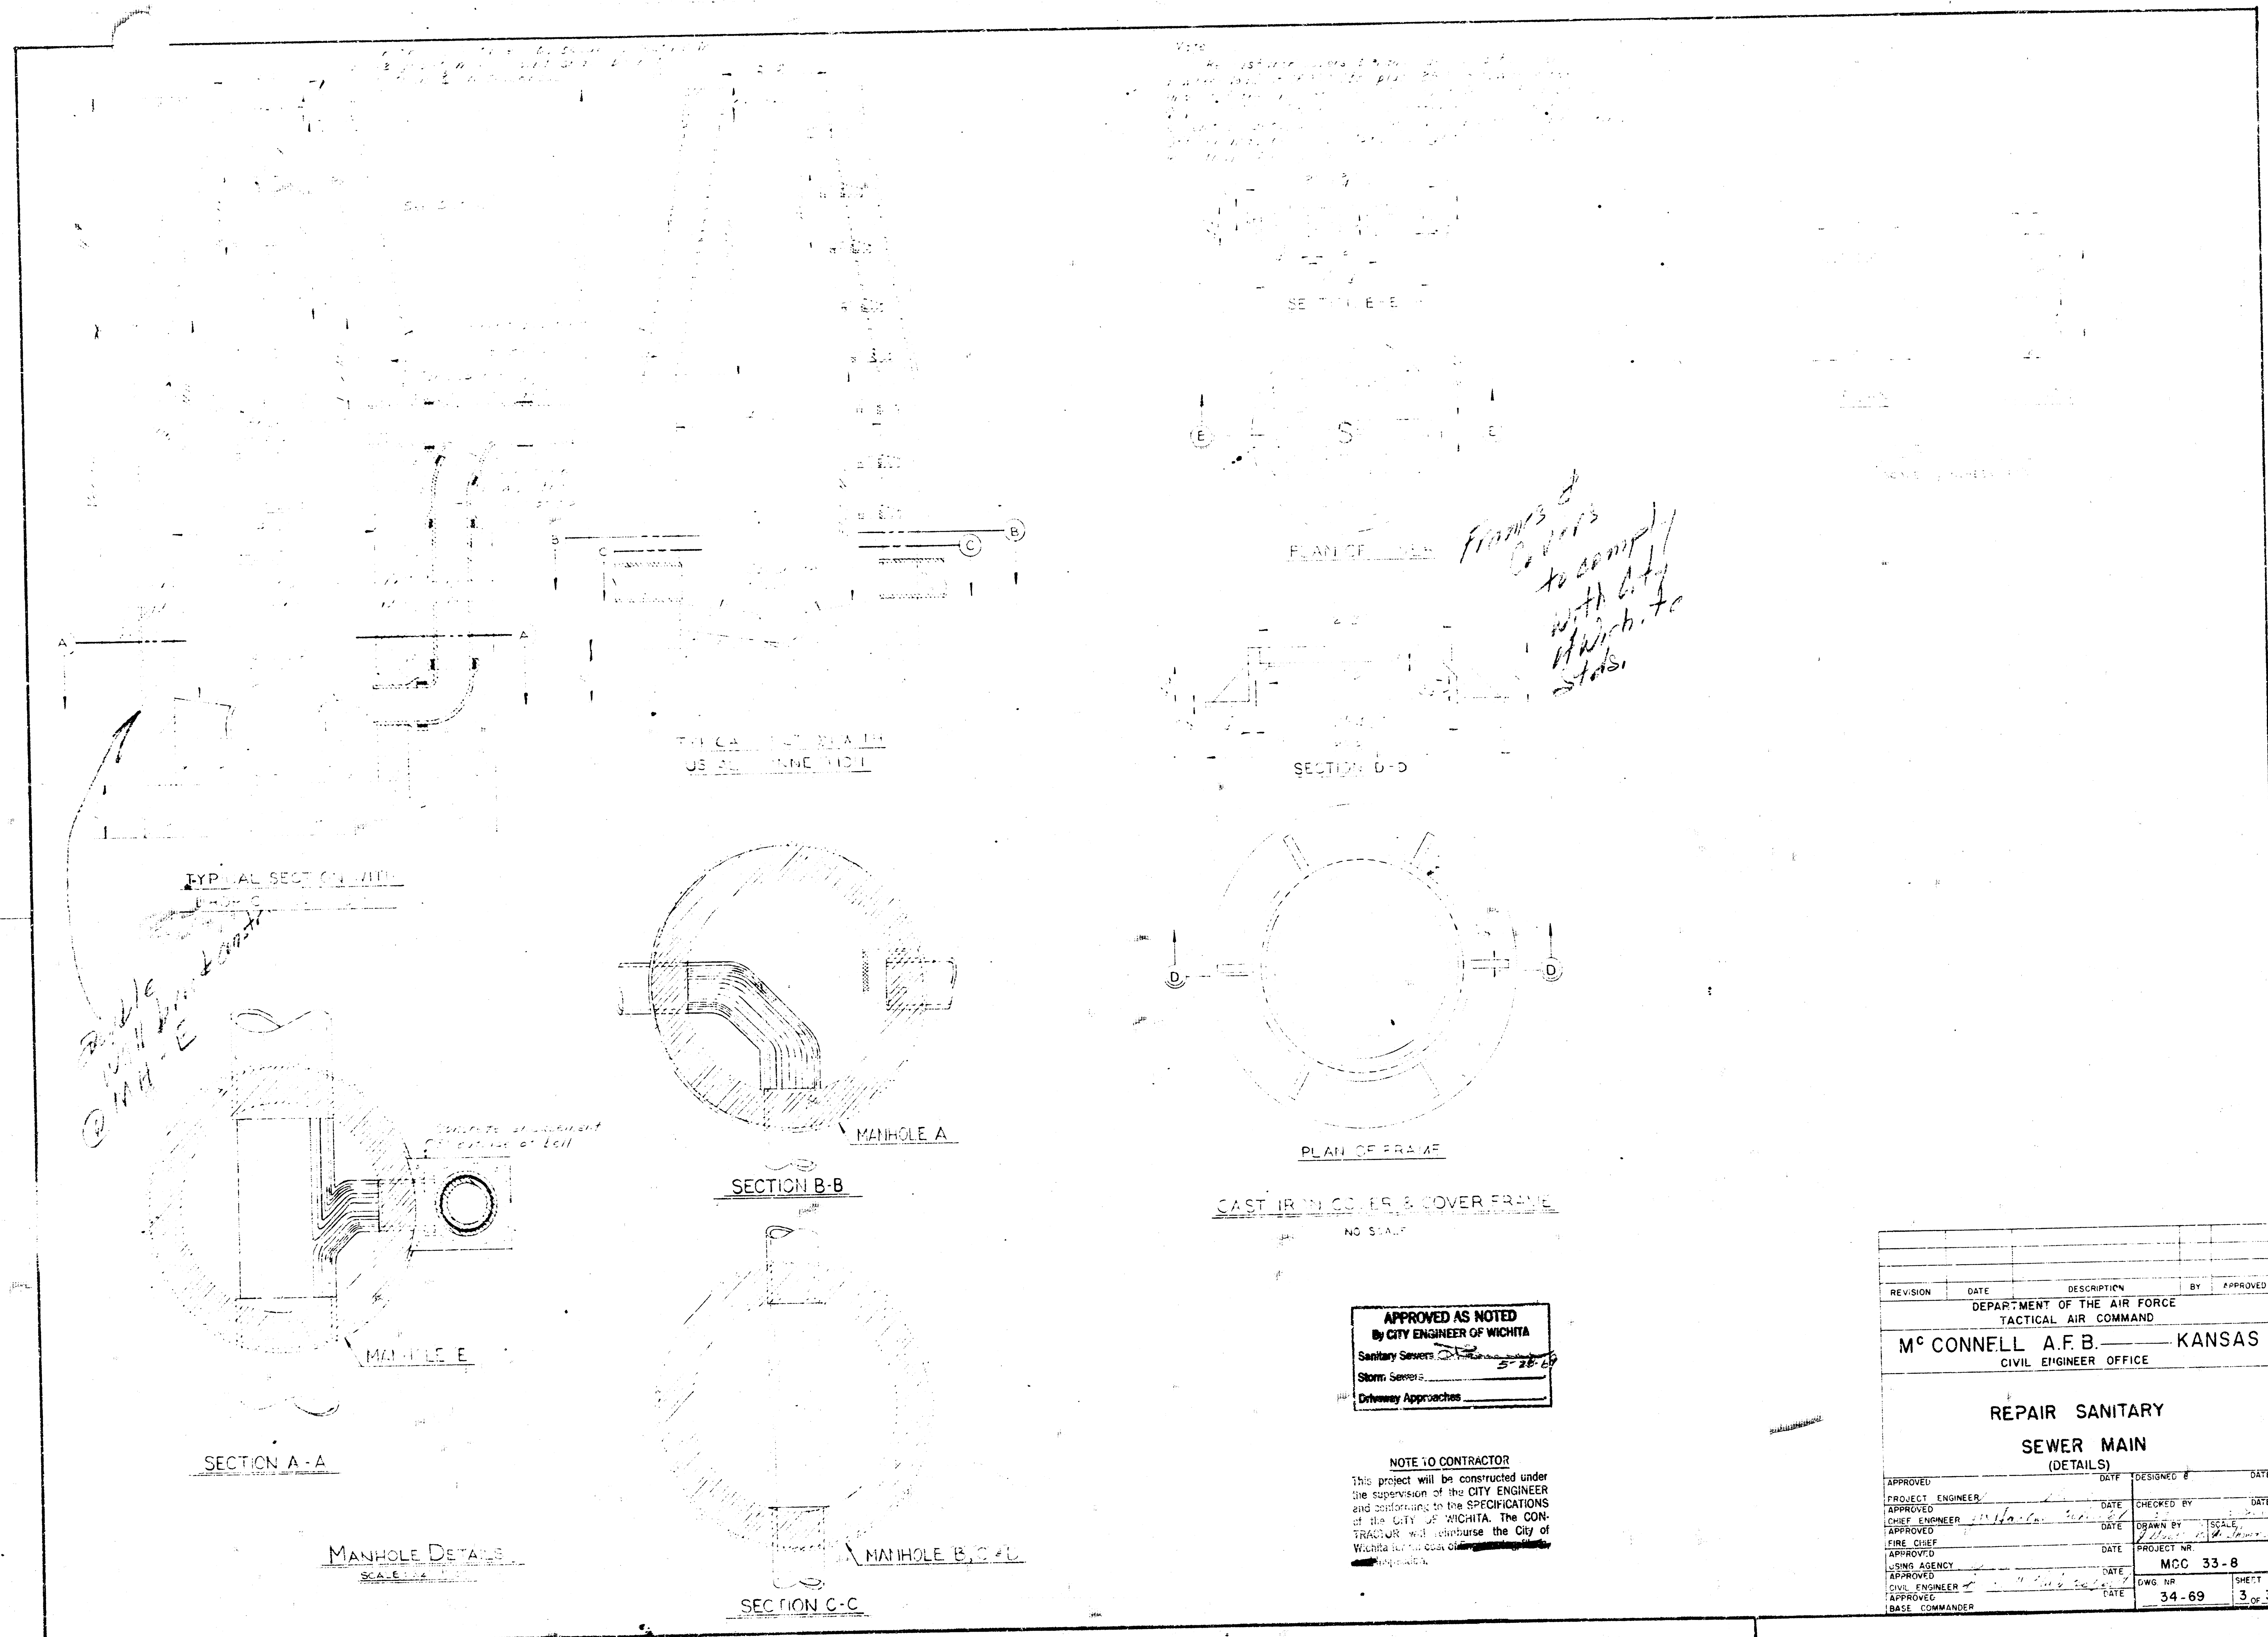

APPROVED AS NOTED
 By CITY ENGINEER OF WICHITA
 Sanitary Sewers *[Signature]*
 Storm Sewers *[Signature]*
 Driveway Approaches *[Signature]*

NOTE TO CONTRACTOR
 This project will be constructed under the supervision of the CITY ENGINEER and conforming to the SPECIFICATIONS of the CITY OF WICHITA. The CONTRACTOR will reimburse the City of Wichita for the cost of the project.

REVISION	DATE	DESCRIPTION	BY	APPROVED
DEPARTMENT OF THE AIR FORCE TACTICAL AIR COMMAND				
M ^c CONNELL A.F.B. KANSAS				
CIVIL ENGINEER OFFICE				
REPAIR SANITARY SEWER MAIN (DETAILS)				
APPROVED	DATE	DESIGNED BY	DATE	
PROJECT ENGINEER		CHECKED BY	DATE	
