14 6 2 (13)

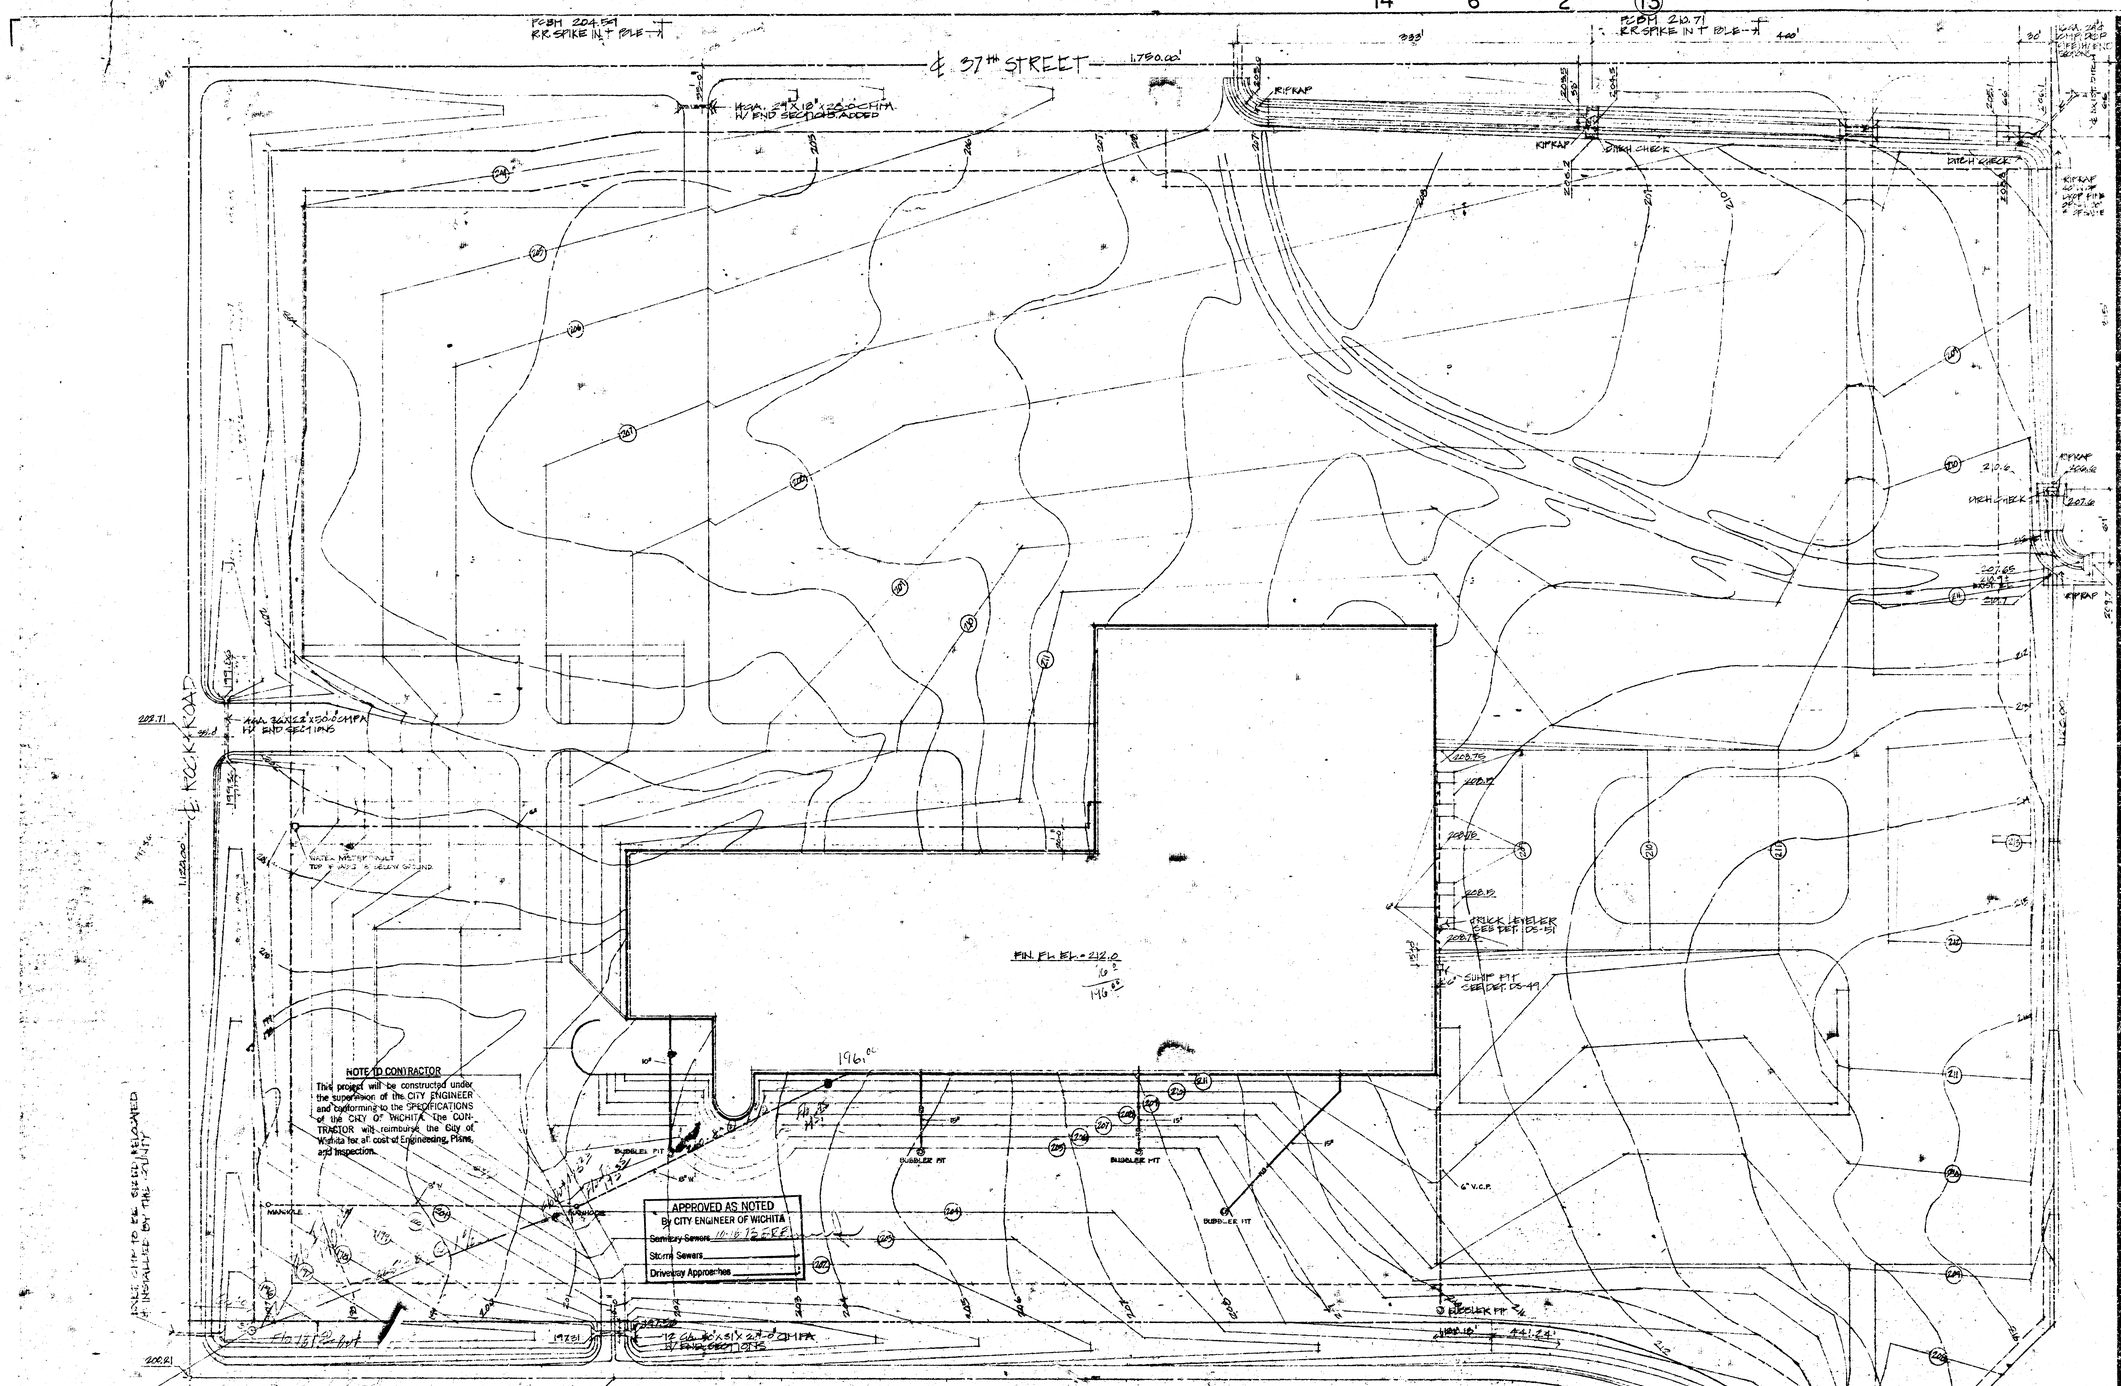

LEGAL DESCRIPTION NCR Sani Sew

BEGINNING AT THE NORTHWEST CORNER OF THE NORTHWEST QUARTER OF SECTION 32, TOWNSHIP 26 SOUTH RANGE 2 EAST OF THE 6TH P.M., SEDGWICK COUNTY, KANSAS; THENCE ALONG THE NORTH LINE OF SAID NORTHWEST QUARTER, BEARING NORTH 89°07'32" EAST, A DISTANCE OF 1,780.00 FEET; THENCE PARALLEL WITH THE WEST LINE OF SAID NORTHWEST QUARTER, BEARING SOUTH 1°05'11" EAST, A DISTANCE OF 1,120.00; THENCE SOUTH 89°07'32" WEST, A DISTANCE OF 262.71 FEET; THENCE ALONG A CURVE TO THE LEFT WITH A RADIUS OF 861.91 FEET, AN ARC DISTANCE OF 441.24 FEET, A LONG CHORD OF 436.00 FEET, BEARING NORTH 28°22'28" WEST TO A POINT; THENCE, PARALLEL WITH THE NORTH LINE OF SAID NORTHWEST QUARTER, BEARING SOUTH 89°07'32" WEST, A DISTANCE OF 1,100.18 FEET TO A POINT ON THE WEST LINE OF SAID NORTHWEST QUARTER; THENCE ALONG SAID WEST LINE, BEARING NORTH 1°03'11" WEST, A DISTANCE OF 1,120.00 FEET TO THE PLACE OF BEGINNING, CONTAINING 45.70 ACRES, MORE OR LESS.

LEGEND

- (201) NEW CONTOUR LINE
- 201 EXIST. CONTOUR LINE
- 201.1 SPOT ELEVATION
- PROPERTY LINE
- RIGHT OF WAY LINE
- SET BACK & EASEMENT LINES
- RIPRAP (6" GRAVEL USED UNDER)

UTILITIES SITE PLAN

N.C.R.
SANI SEWER
NW Rock Rd. & 37TH ST NO.

No. REV. - 2-5-75
JUNE 26, 75

SCHAEFER SCHIMER & ASSOCIATES P.A.
ARCHITECTURE • PLANNING • LANDSCAPE DESIGN
URBAN DESIGN • INTERIOR DESIGN • ENGINEERING
WICHITA TOPEKA

NCR
ACCOUNTING COMPUTER DIVISION
37 TH. & ROCK ROAD, WICHITA, KS.

DATE: FEB. 21, 75
DR: CH.
JOB: 72-536
SHEET NO.
G1A
OF SHEETS