


PROFILE	SURVEYED _____	BY _____	DATE _____
NOTE BOOK	BOTTLED _____		
CASE CHECKED	_____		
G.M. IPIPED	_____		
STRUCTURE ROTATING CHKD	_____		

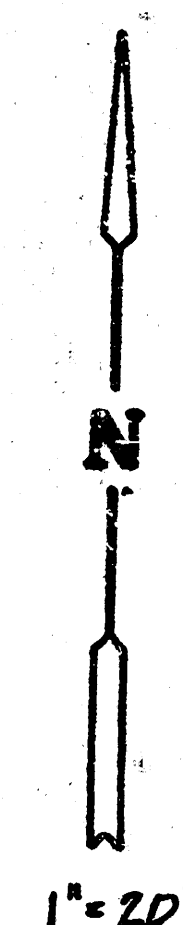

NOTE TO CONTRACTOR

This project will be constructed under the supervision of the CITY ENGINEER and conforming to the S.W. ORDINANCES of the CITY OF WICHITA. The CONTRACTOR will prepay the City of Wichita for all costs of Inspection.


5-13-81

APPROVED AS NOTED
By CITY ENGINEER OF WICHITA

Sanitary Sewers. *J.E.S.*

Storm Sewers _____

Driveway Approaches _____

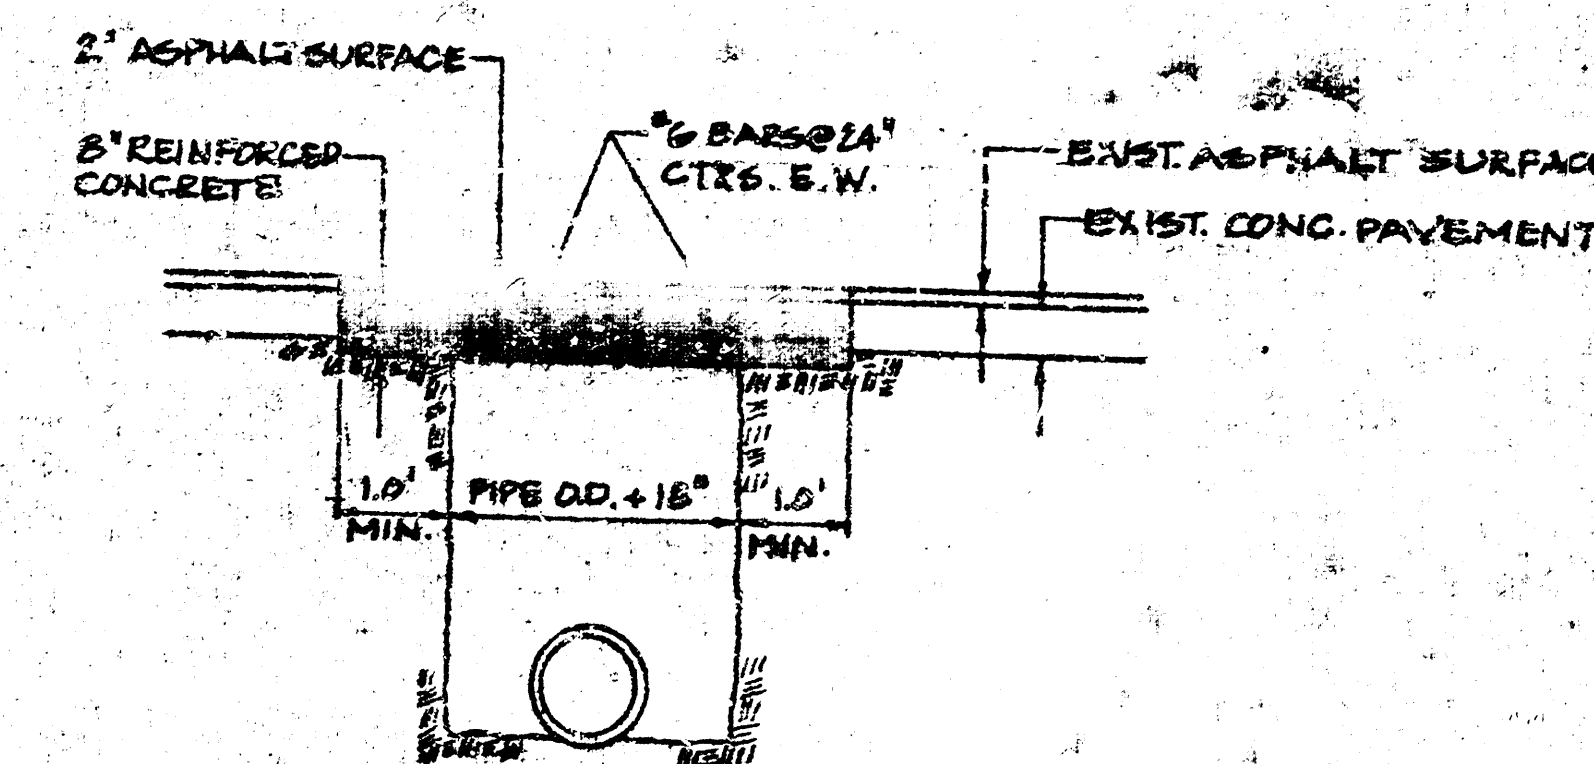

PAVEMENT REPLACEMENT DETAIL
NO SCALE

NOTE:
REPLACE CURB & GUTTER AND DRIVE APPROACH
TO MATCH EXISTING SECTION.
ALL PAVEMENT CUTS TO BE PARALLEL WITH OR
PERPENDICULAR TO EXISTING STREET PAVEMENT.

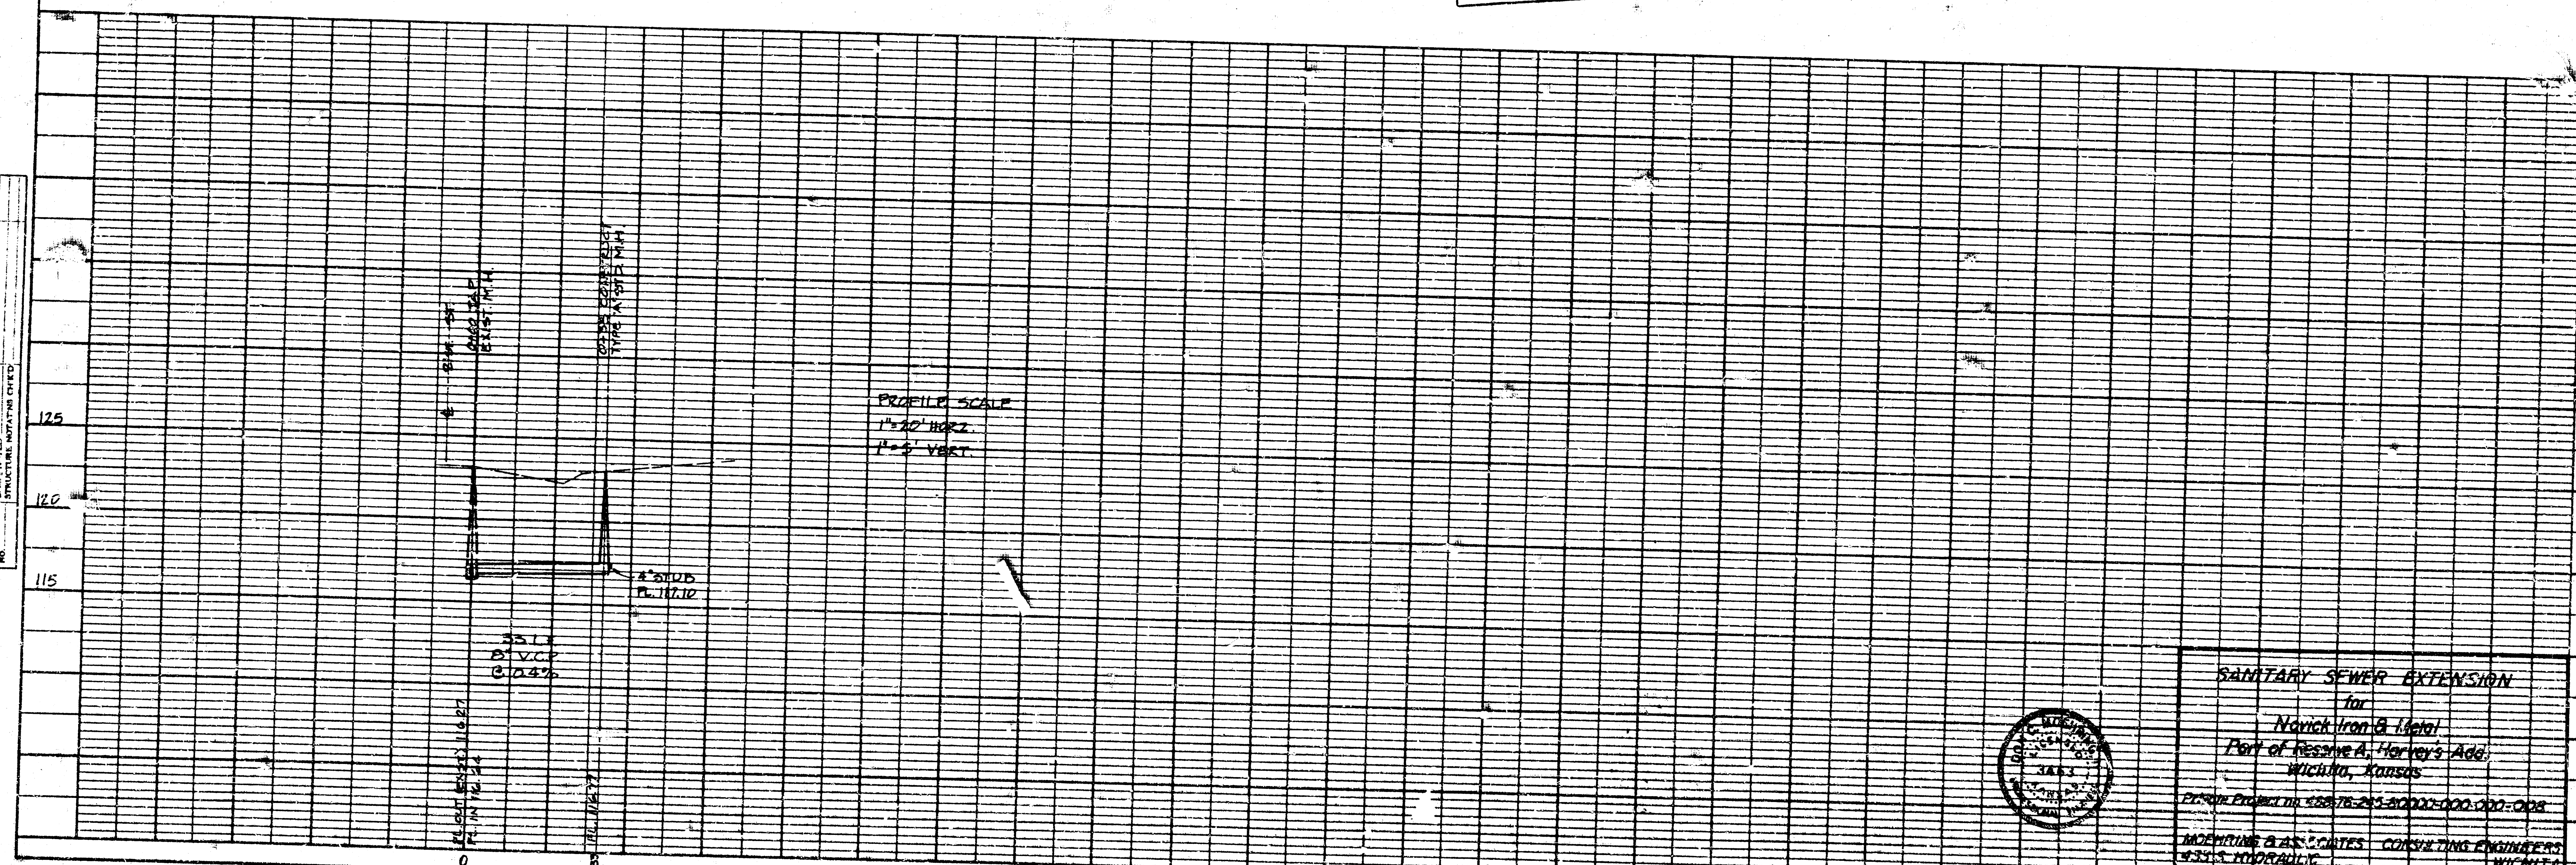


PLATE 1 - PLAN - PROFILE - F.A.
CLEARPRINT PAPER CO., S. CAL.
NO. 1000H-1

SANITARY SEWER EXTENSION
for
Navick Iron & Metal
Part of Residue A, Harvey's Add.
Wichita, Kansas


MOCKINGBASS, JAMES L. CONSULTING ENGINEER
4331 S. MORRIS
OK-66102 WICHITA, KANSAS
MAY 1981