
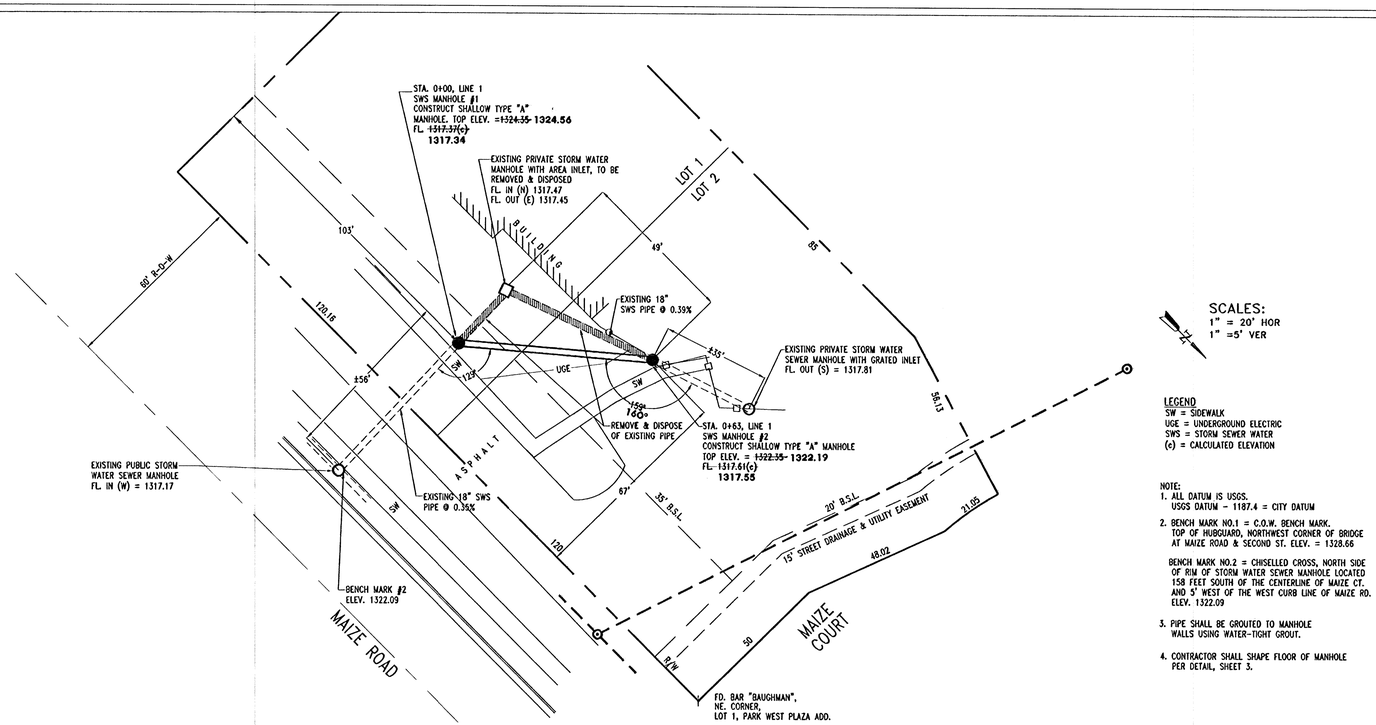


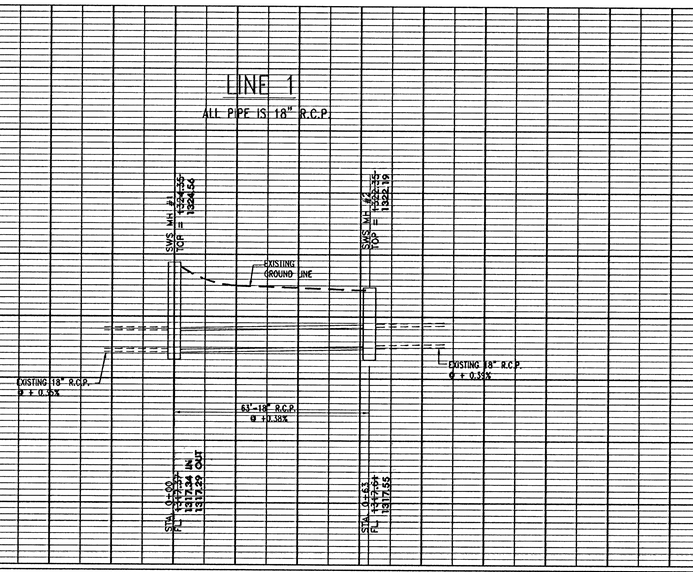

AS-BUILT 7-31-2007

REISS & GOODNESS ENGINEERS
2160 WEST 21st STREET
WICHITA, KANSAS 67203
(316) 832-0213

REVISION	DIRECTORY	DRAWN BY	FILE NAME	CHECKED BY	DESIGNED BY
	RGS\MISC\TREEHOUSE	C.E.	LEARNING_CTR\	LEARNING CENTER	R.P.

STORM WATER SEWER REPLACEMENT

CUSTOMER

LOTS 1 & 2, PARK WEST PLAZA ADDITION, WICHITA, KANSAS

SCALE: NOTED
DATE: 12/18/06
PROJECT NO. ST0508
SHEET: 2 OF 7