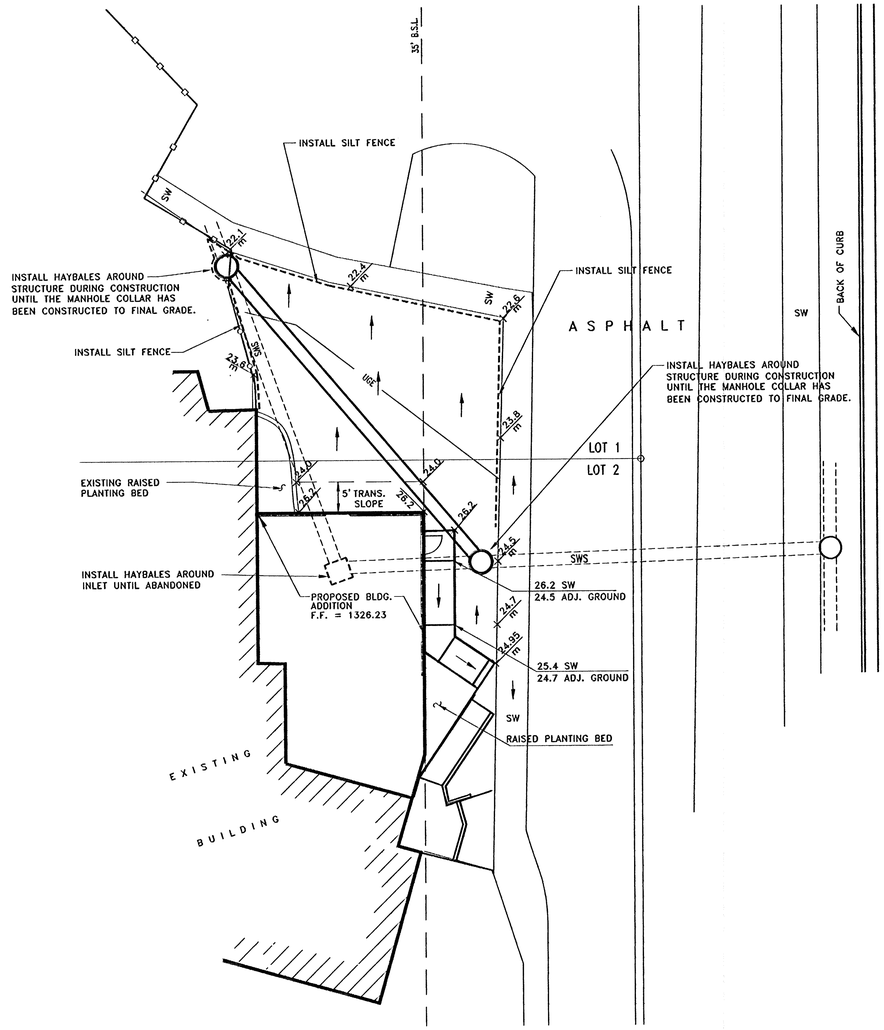


N

SCALE:
1" = 10'

LEGEND

m = MATCH ELEVATION
SW = SIDEWALK
SWS = STORM WATER SEWER
UGE = UNDERGROUND ELECTRIC
—► = DIRECTION OF DRAINAGE
125.4 = PROPOSED SPOT ELEVATIONS
--- = SILT FENCE

AS-BUILT 7-31-2007

REISS & GOODNESS ENGINEERS
2160 WEST 21st STREET
WICHITA, KANSAS 67203
(316) 832-0213

REVISION	DIRECTORY	DRAWN BY	FILE NAME	CHECKED BY	DESIGNED BY	PROJECT	CUSTOMER	SCALE: 1" = 10'	PROJECT NO. M50508
	C:\RGF\MSC\LEARK_CTR	C.E.	LEARK_CTR_ELEV.		R.P.	SITE GRADING AND EROSION CONTROL PLAN	LOTS 1 & 2 PARK WEST PLAZA ADD'N.	DATE: 12/31/06	SHEET: 5 of 7