

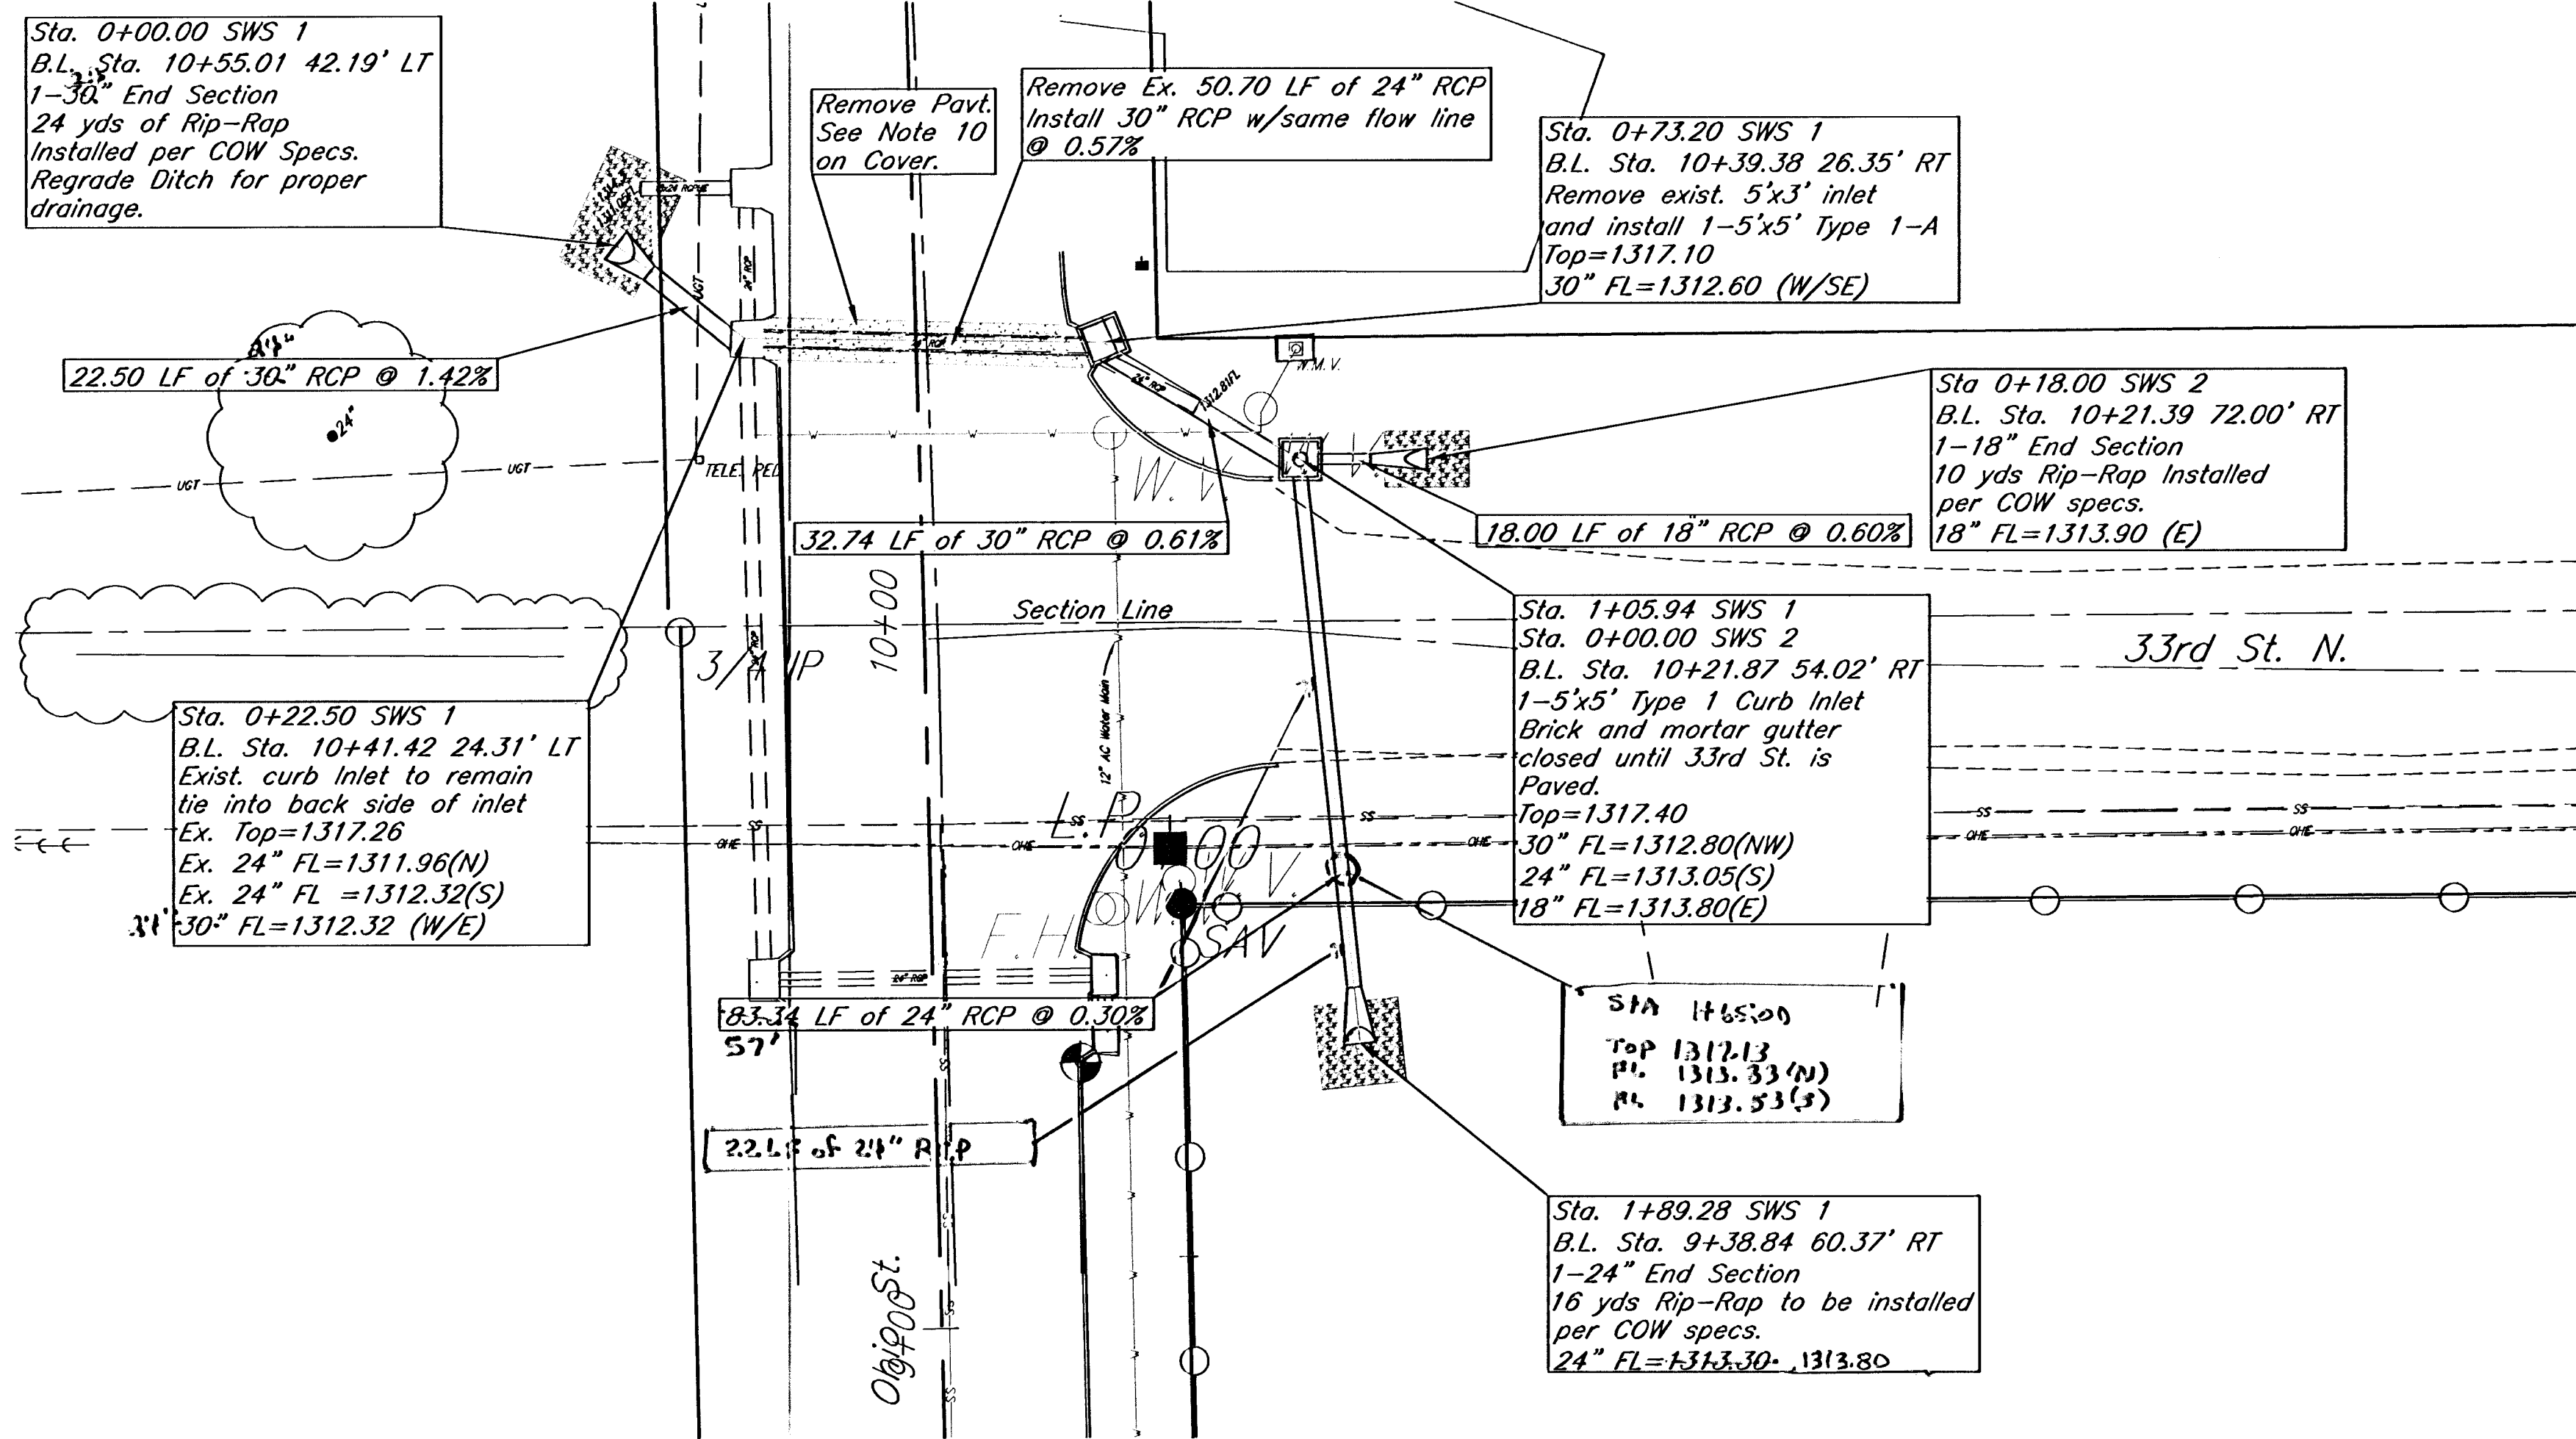
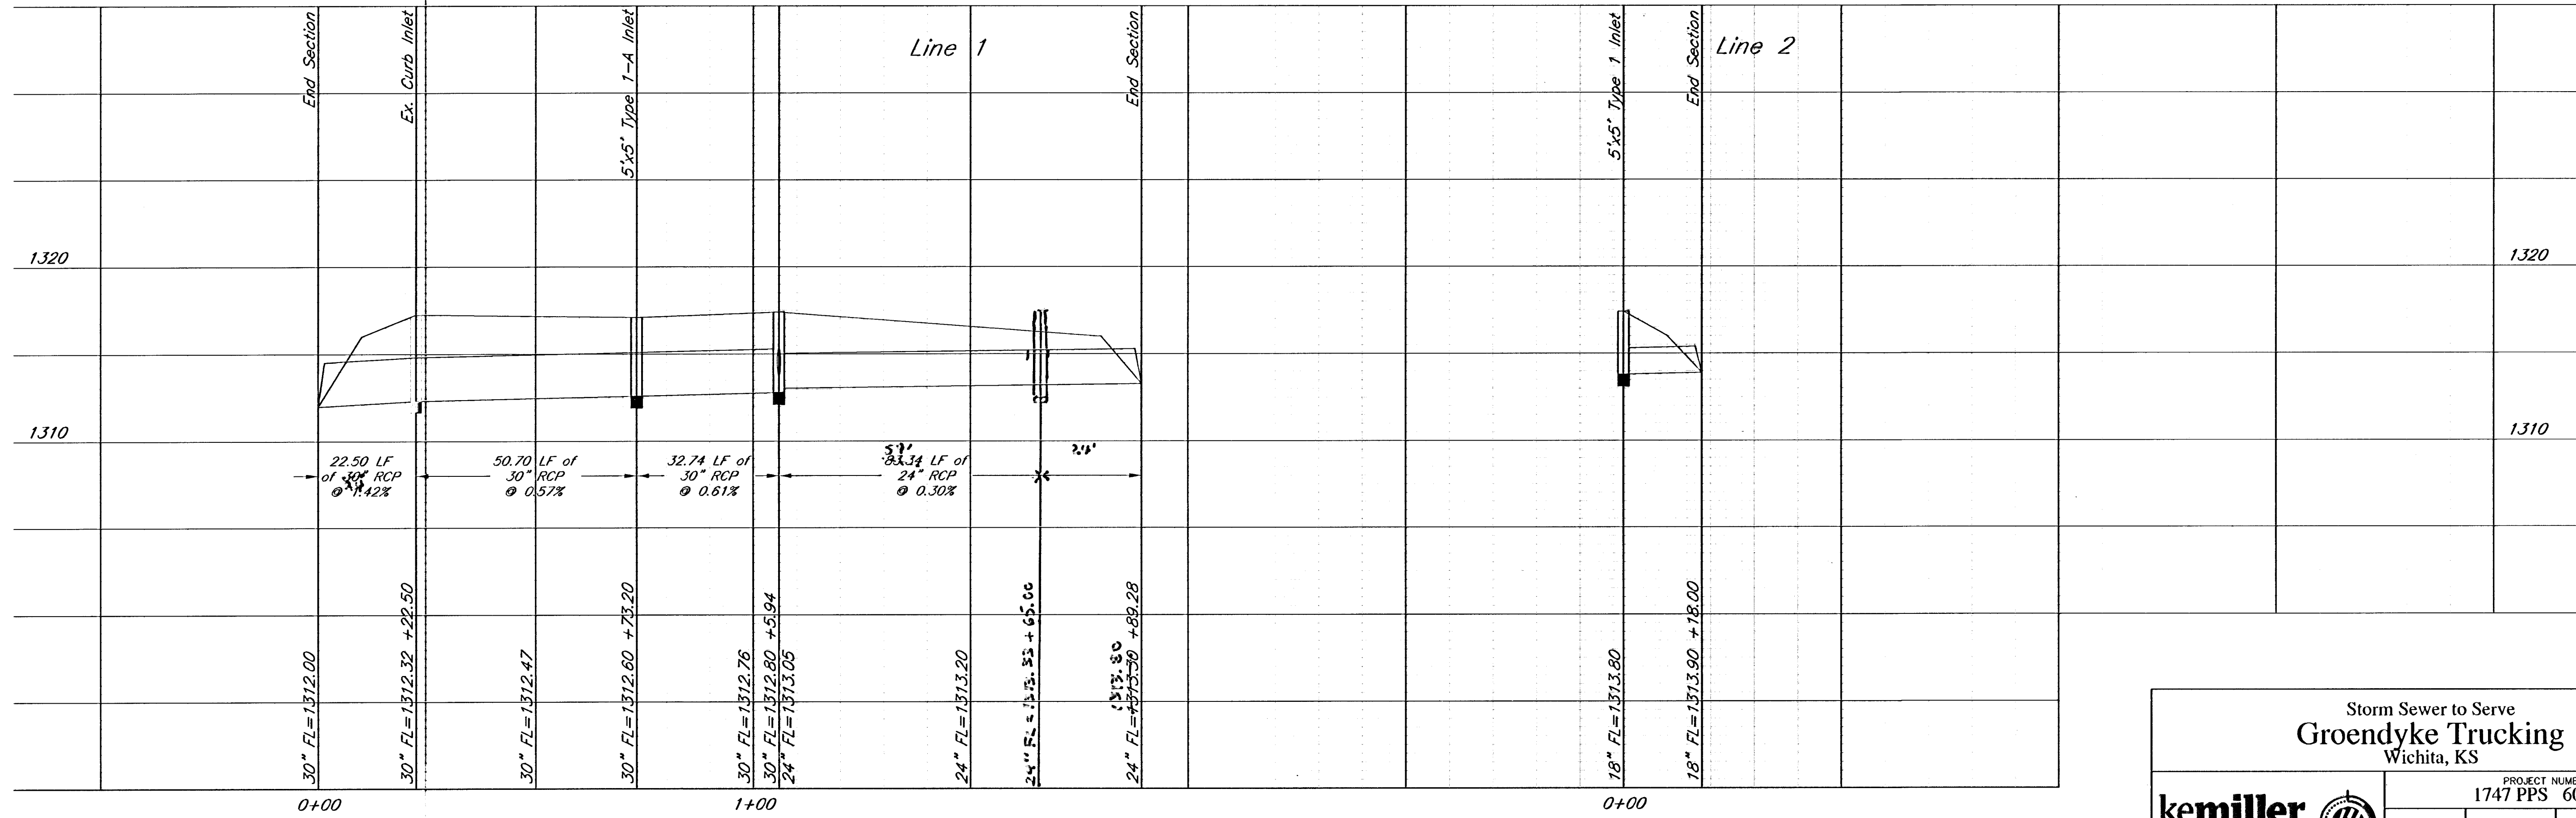


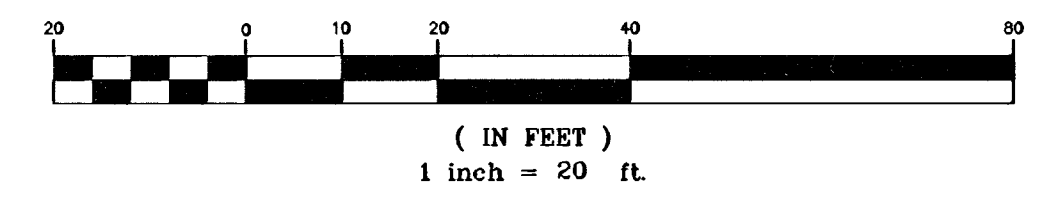

Baseline
Intersection of Ohio and Quarter
Section Line, being Sta. 10+00.

Benchmark:
Rail Road Spike in Hubguard
SW Corner of RCBG under Ohio
St. 75' N. of 29th St. N.
Elev. = 1317.01

On Site BM: "□" on Top of Curb
at S. End of Catch Basin E. Side
of Ohio at S. Curb Return.
Elev. = 1316.75

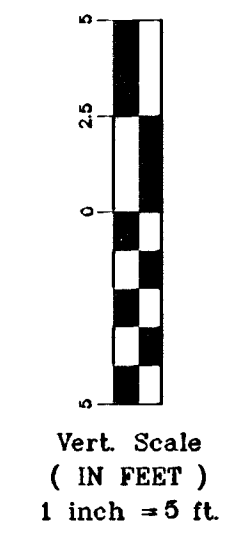

518 S. Market,
Wichita, KS 67202

Storm Sewer to Serve
Groendyke Trucking
Wichita, KS

PROJECT NUMBER 1747 PPS 607861			
KEM NO. 06177	FILE PPS	DATE 2/07	SHEET 2
DESIGN PB	DRAWN JO	REVISED 2/20/07	OF 5

318/264-0242