
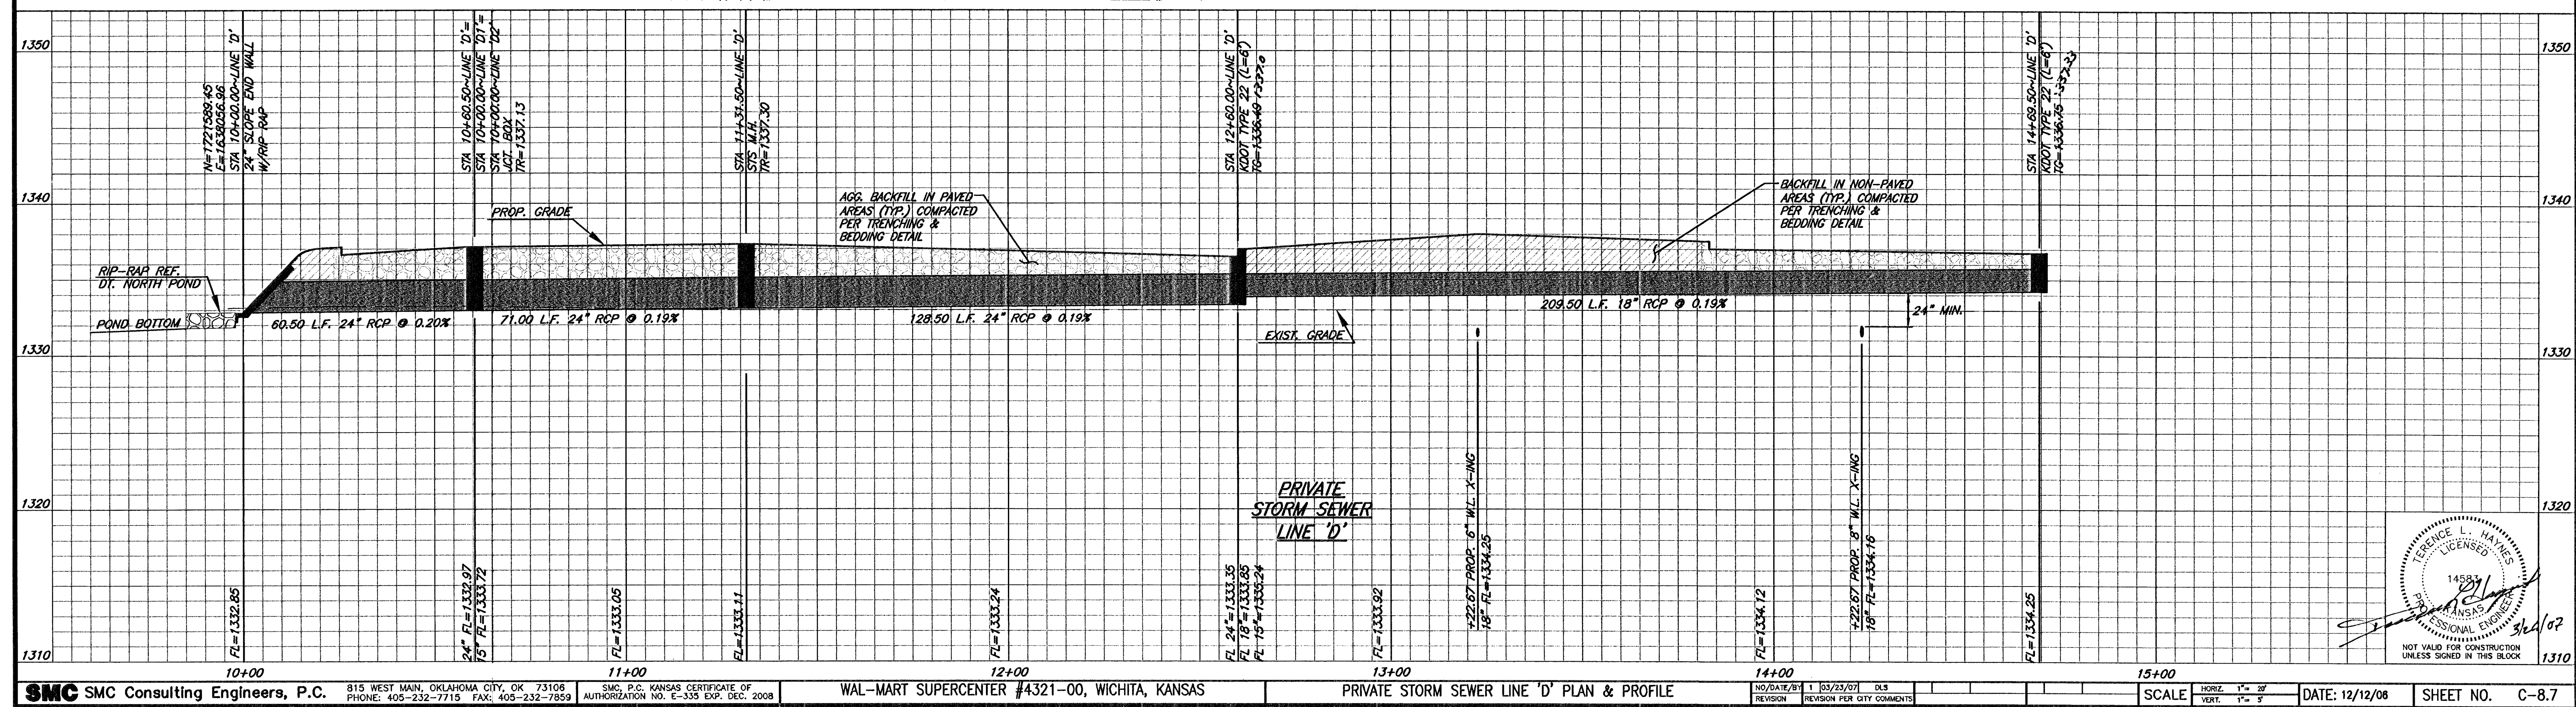


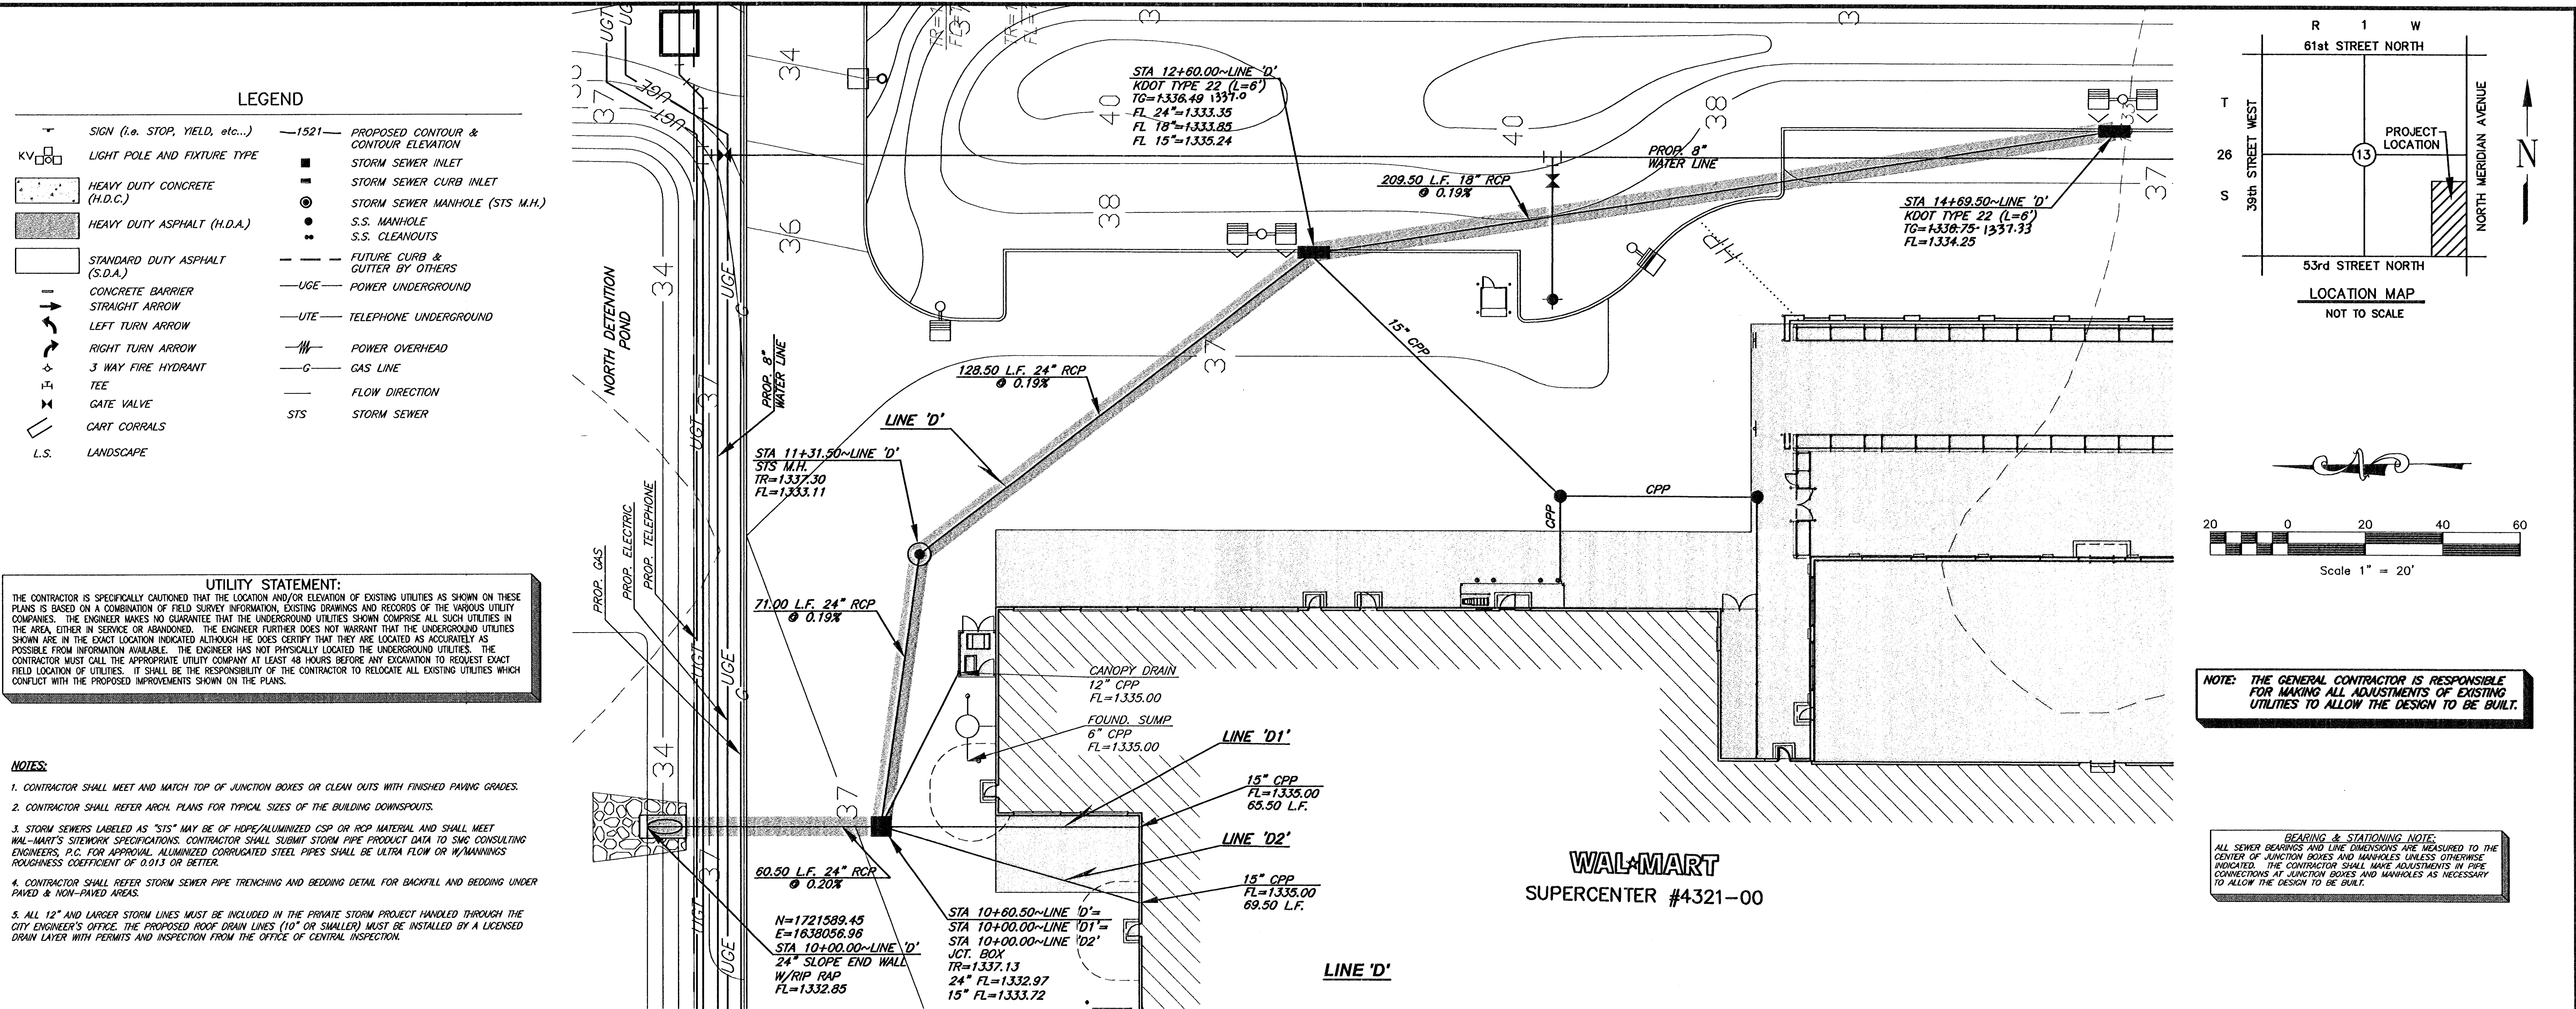

C:\454\Sum Sme\4544925-Rev.dwg, 3/25/2007 10:37:59 AM