



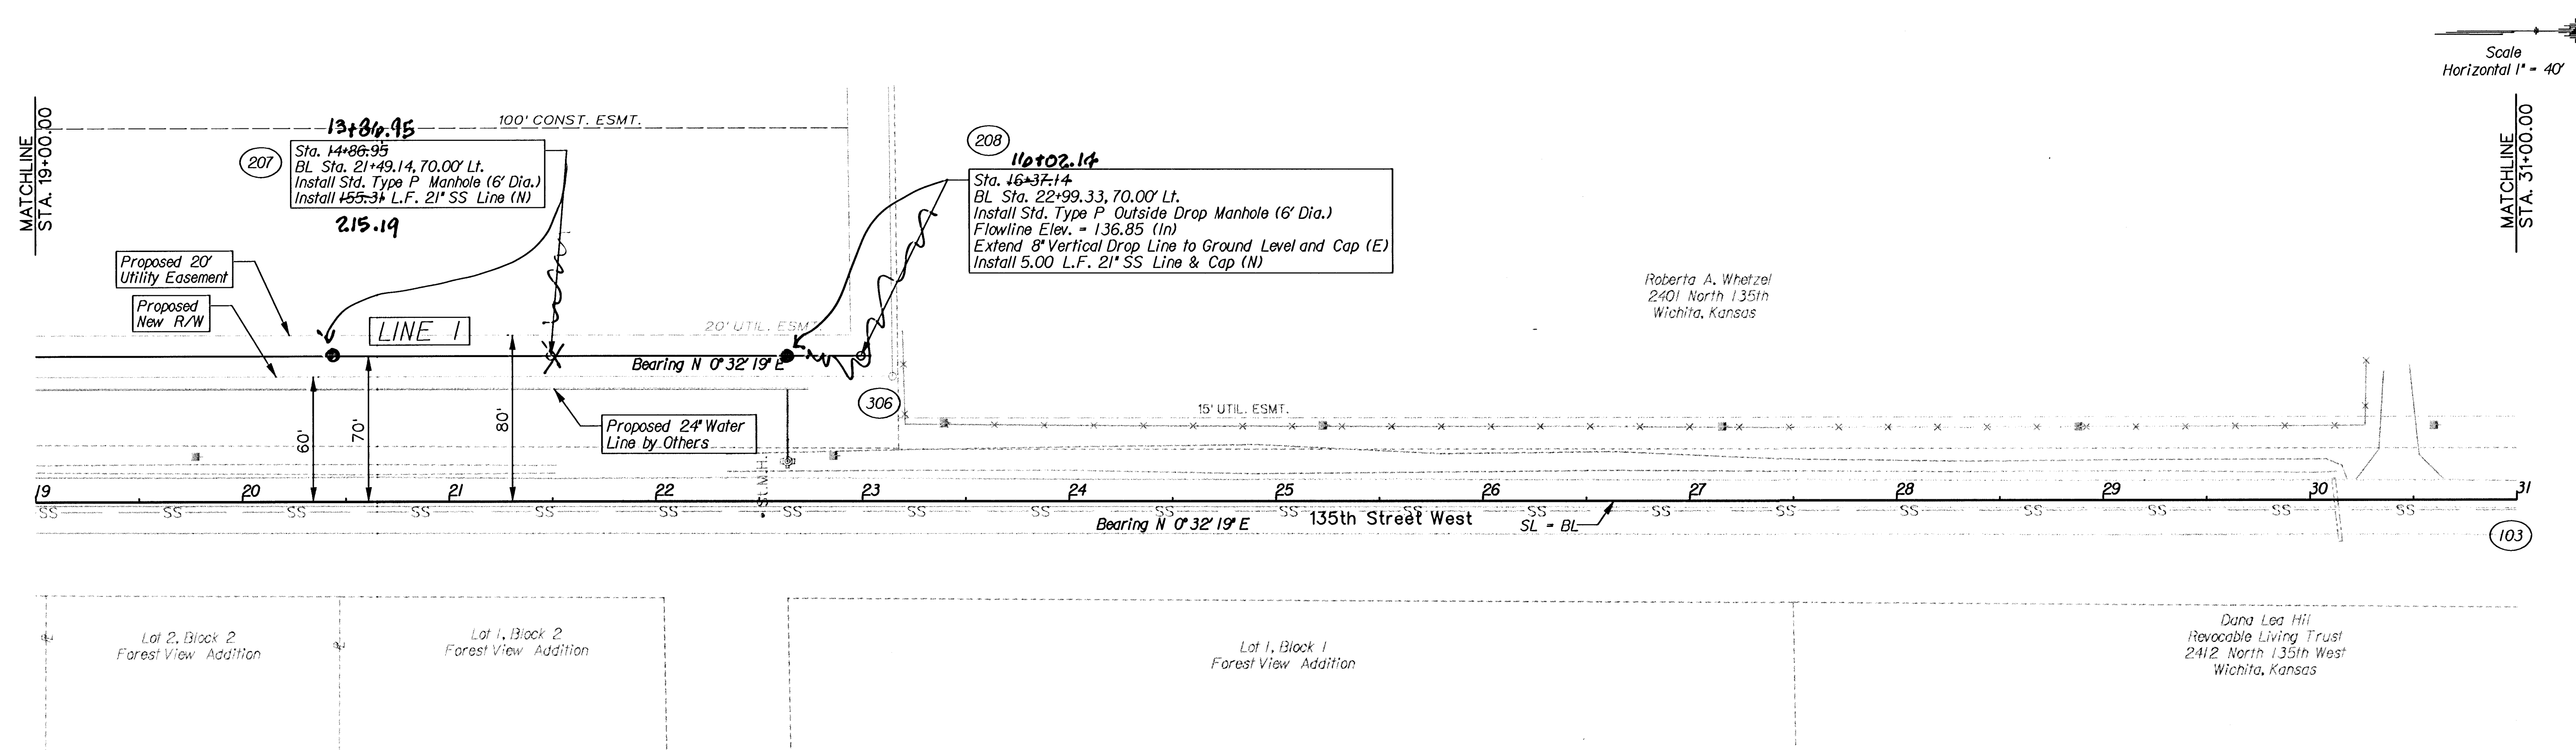

Note: FL information not verified.

Note:
No Construction Activities are allowed
on Private Property without a Construction
Easement.

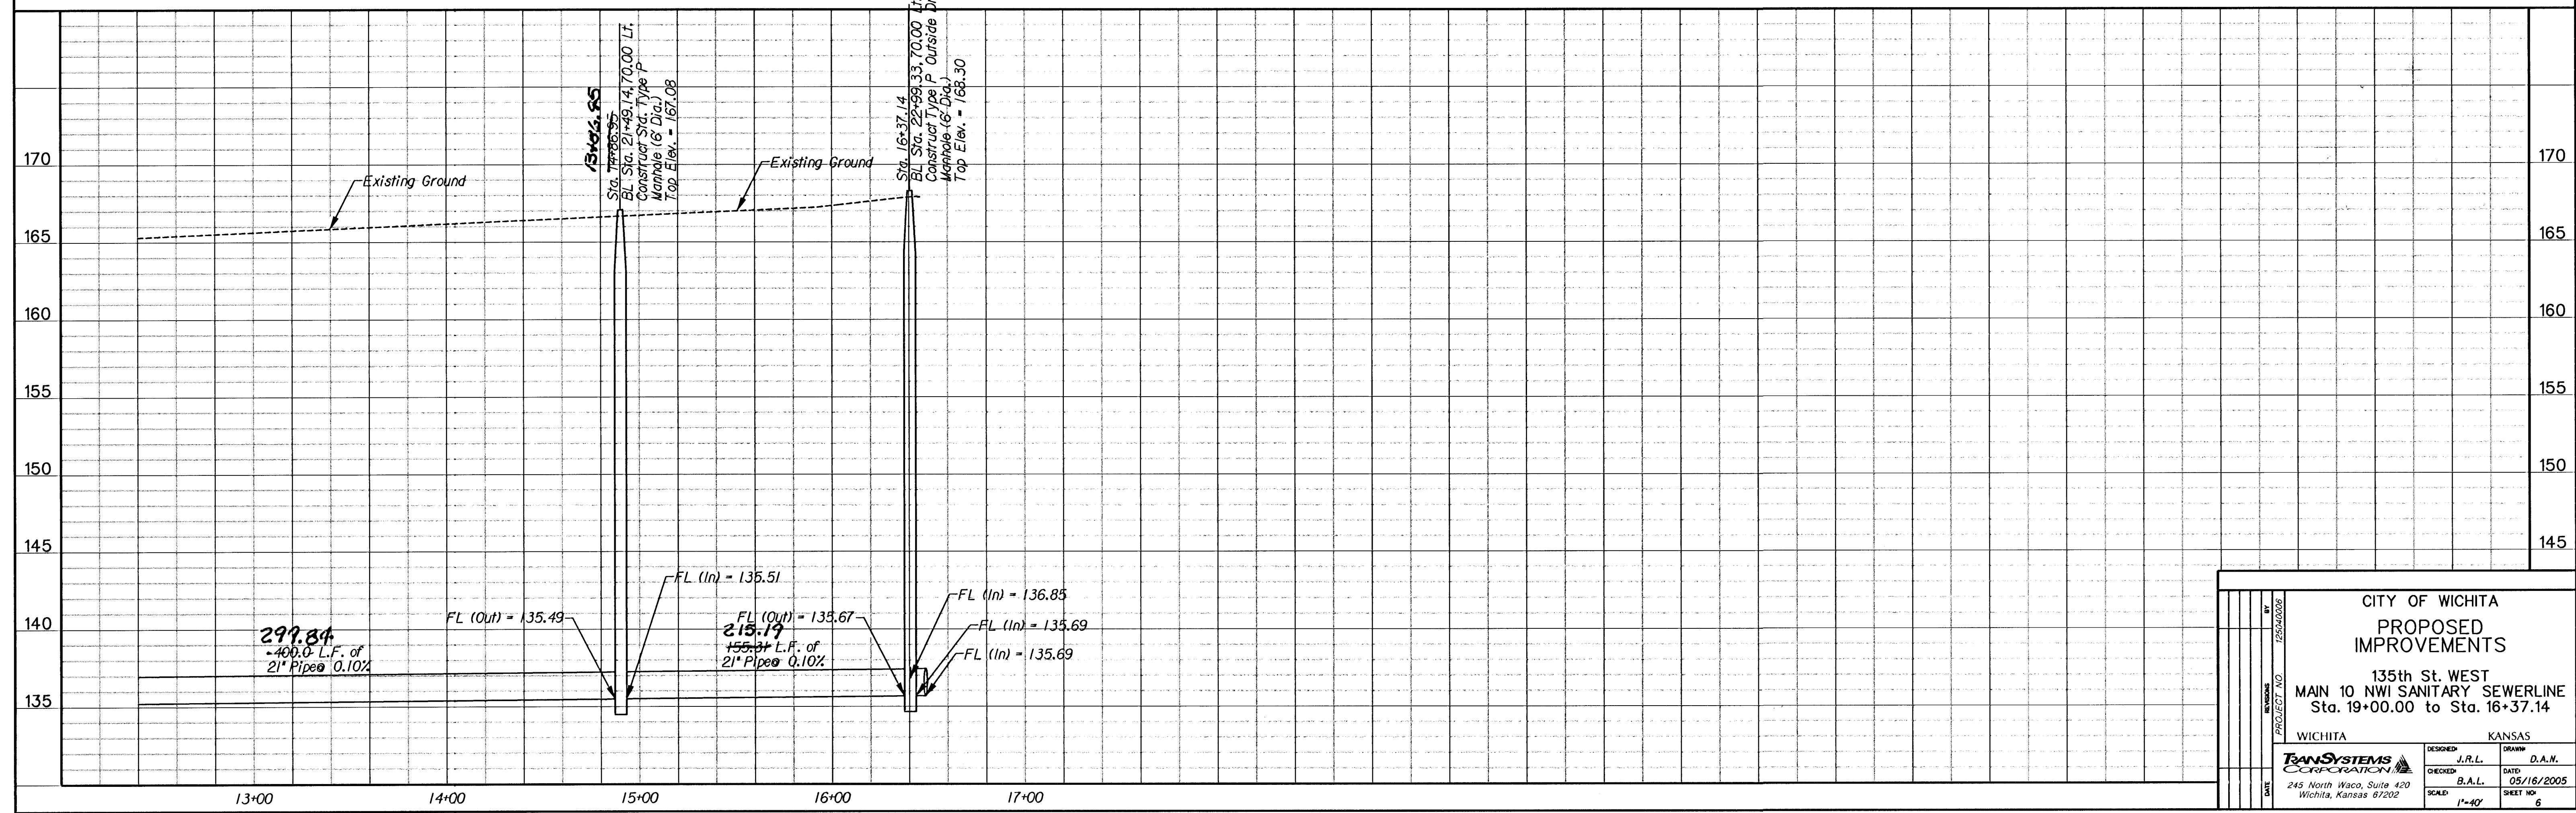

g:\w04\0006\road\p02.sht
05/16/2005 10:35:25 AM

CITY OF WICHITA			
PROPOSED IMPROVEMENTS			
135th St. WEST			
MAIN 10 NW SANITARY SEWERLINE			
Sta. 19+00.00 to Sta. 16+37.14			
WICHITA		KANSAS	
DESIGNED	J.R.L.	DRAWN	D.A.W.
CHECKED	B.A.L.	DATE	05/16/2005
245 North Waco, Suite 420 Wichita, Kansas 67202		SCALE	1"=40'
PROJECT NO.		SHEET NO.	