


ENGINEERING DEPARTMENT

CITY OF WICHITA

MISCELLANEOUS INFORMATION

Signed

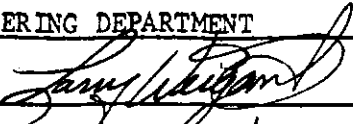

Contractor

Cornejo and Sons, Inc.

Date

8/31/07

Project

37th St. N. to serve Ridge Port North 4th Addition

Project Number

472-83411

~~Project Constructed As Planned.~~ Extra pavement was removed and replaced @ Ridge Port entrance. Low area between existing pavement and proposed was removed (Station 10+34.25)