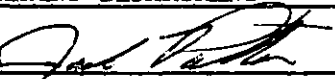


ENGINEERING DEPARTMENT

CITY OF WICHITA

MISCELLANEOUS INFORMATION

Signed

Contractor WB CARTER

Date

Project

Storm Water #630 COLES ADDITION

Project Number

468-84335 751446M/H SAT 3 PLANS SHOW AT STA 2+50 / ACTUAL STA 2+52RIED INLET SAT 5 PLANS SHOW AT STA 12+92 / ACTUAL STA 12+95