



STATE	PROJECT NO.	YEAR	SHEET NO.	SHEETS
KANSAS	87 N-0349-01	2009	20	133

MKEC
ENGINEERING
CONSULTANTS, INC.
411 N. WEBB ROAD
WICHITA, KS. 67206
316-684-9600

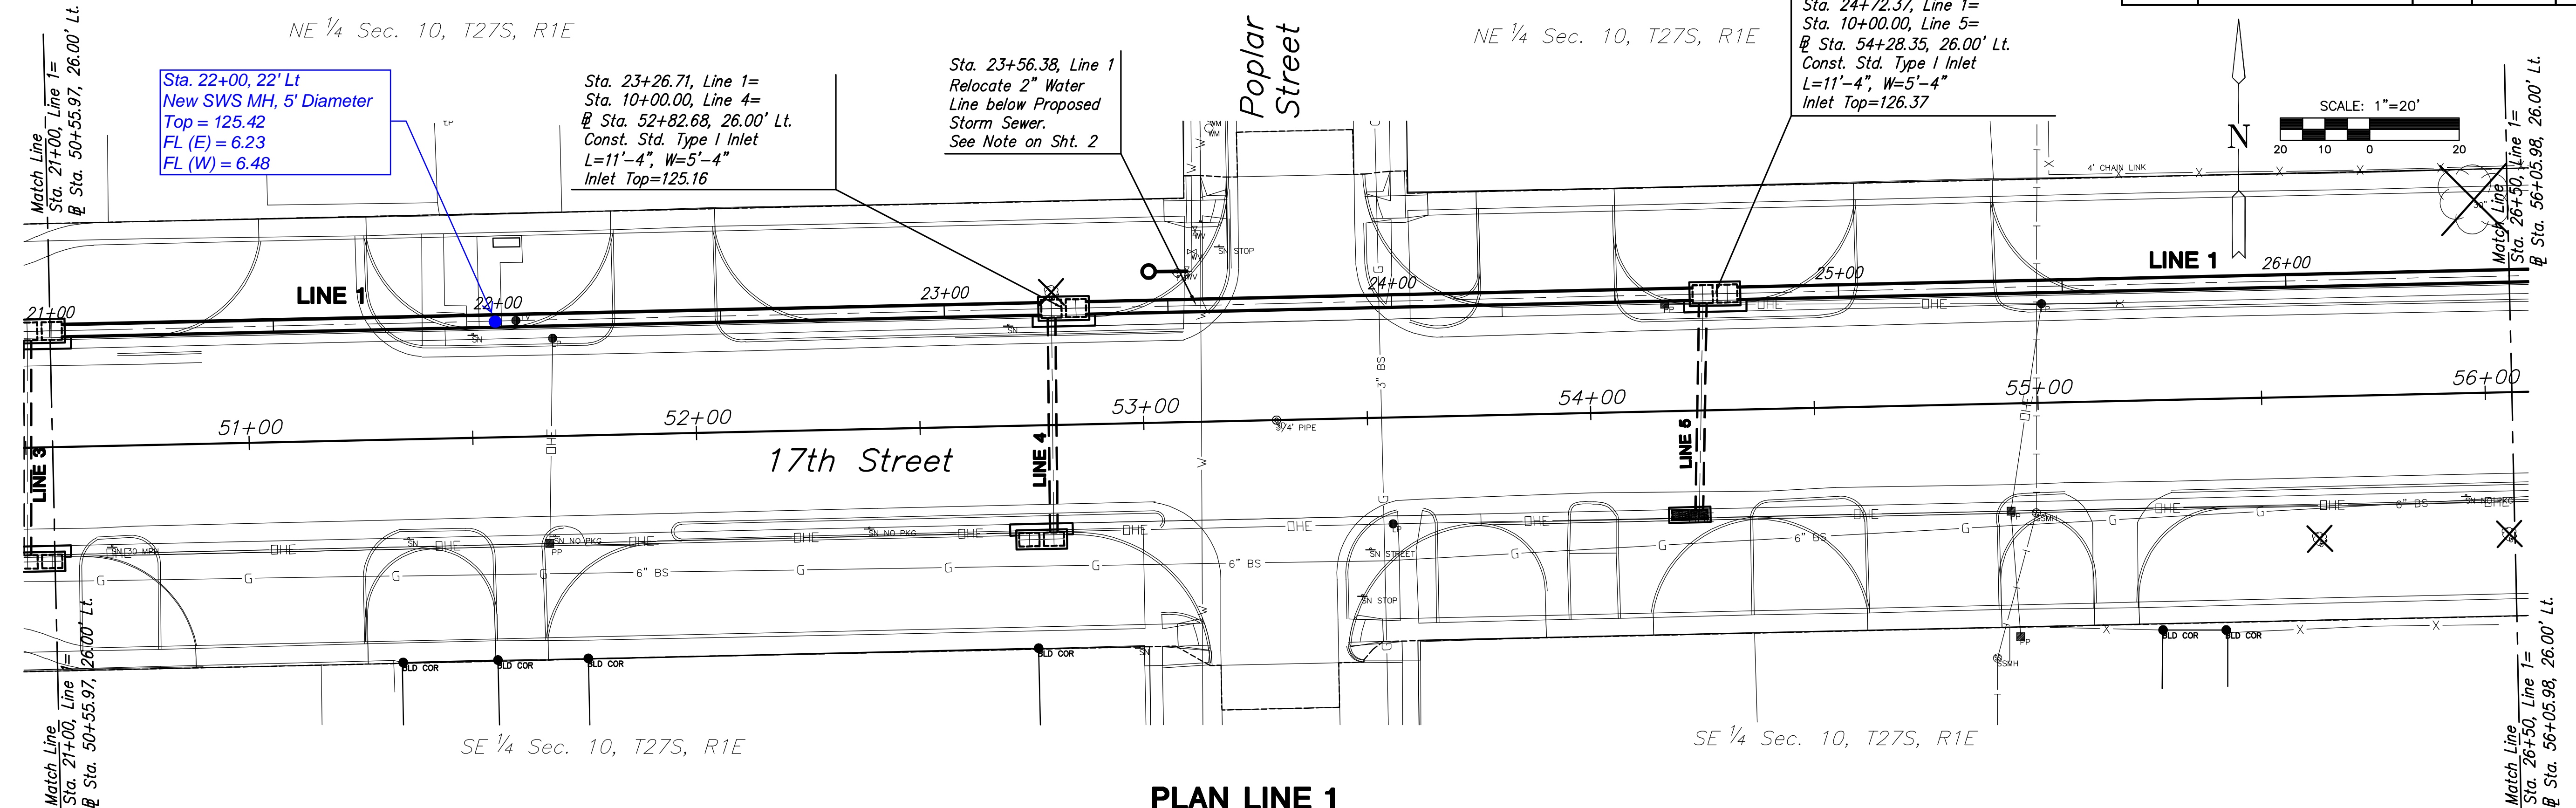

PLAN LINE 1

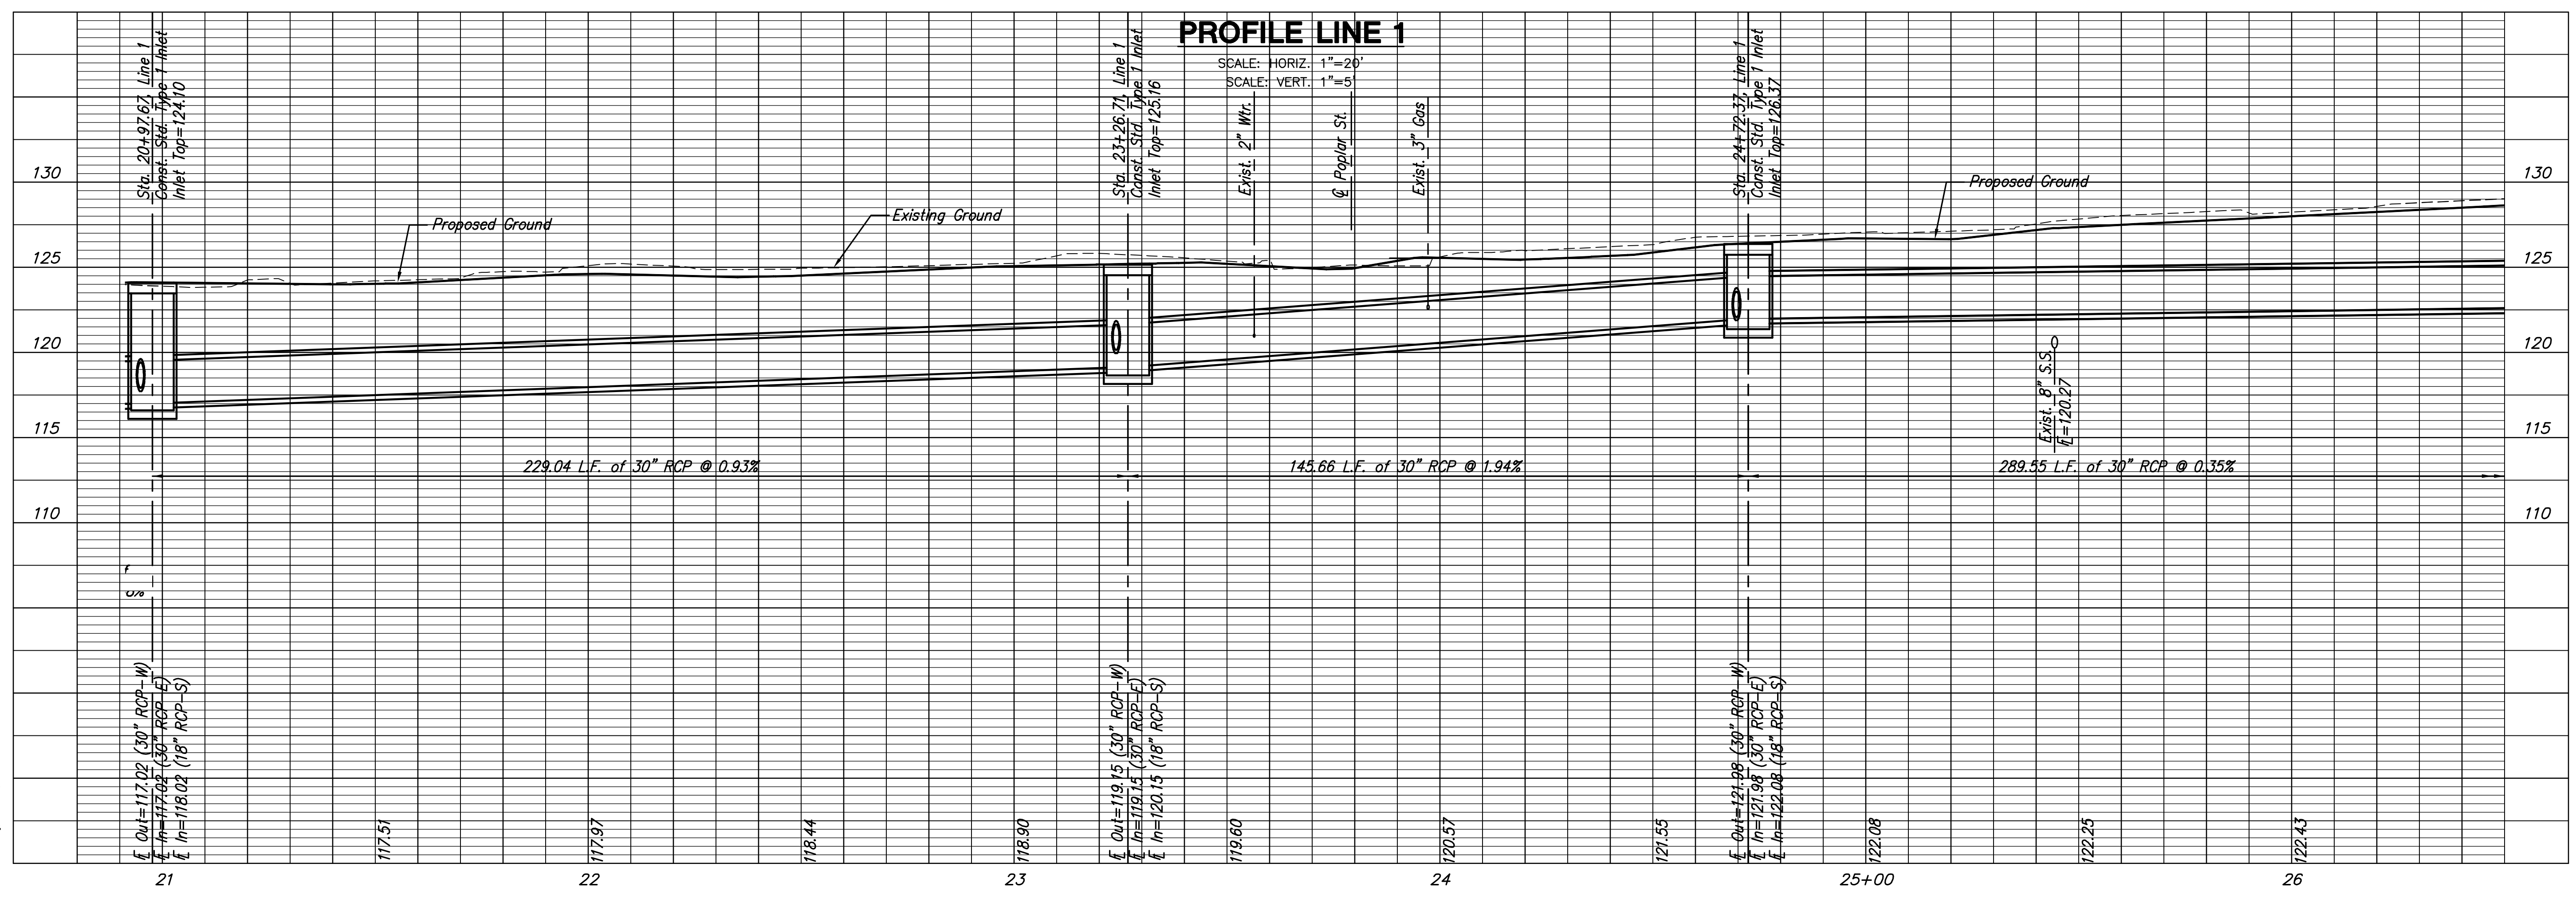

PROFILE LINE 1

PLOT DATE: Thursday, June 04, 2009 @ 08:24 AM

**17th STREET
FROM GROVE TO HILLSIDE**

**Storm Line 1
Sta. 21+00
to
Sta. 26+50**
87 N-0349-01
PROJECT NUMBER

DESIGN BY: JRA
DRAWN BY: JSB
CHECKED BY: JRA

ISSUED: June 4, 2009
REVISED:

SHEET NO.
20 of 133