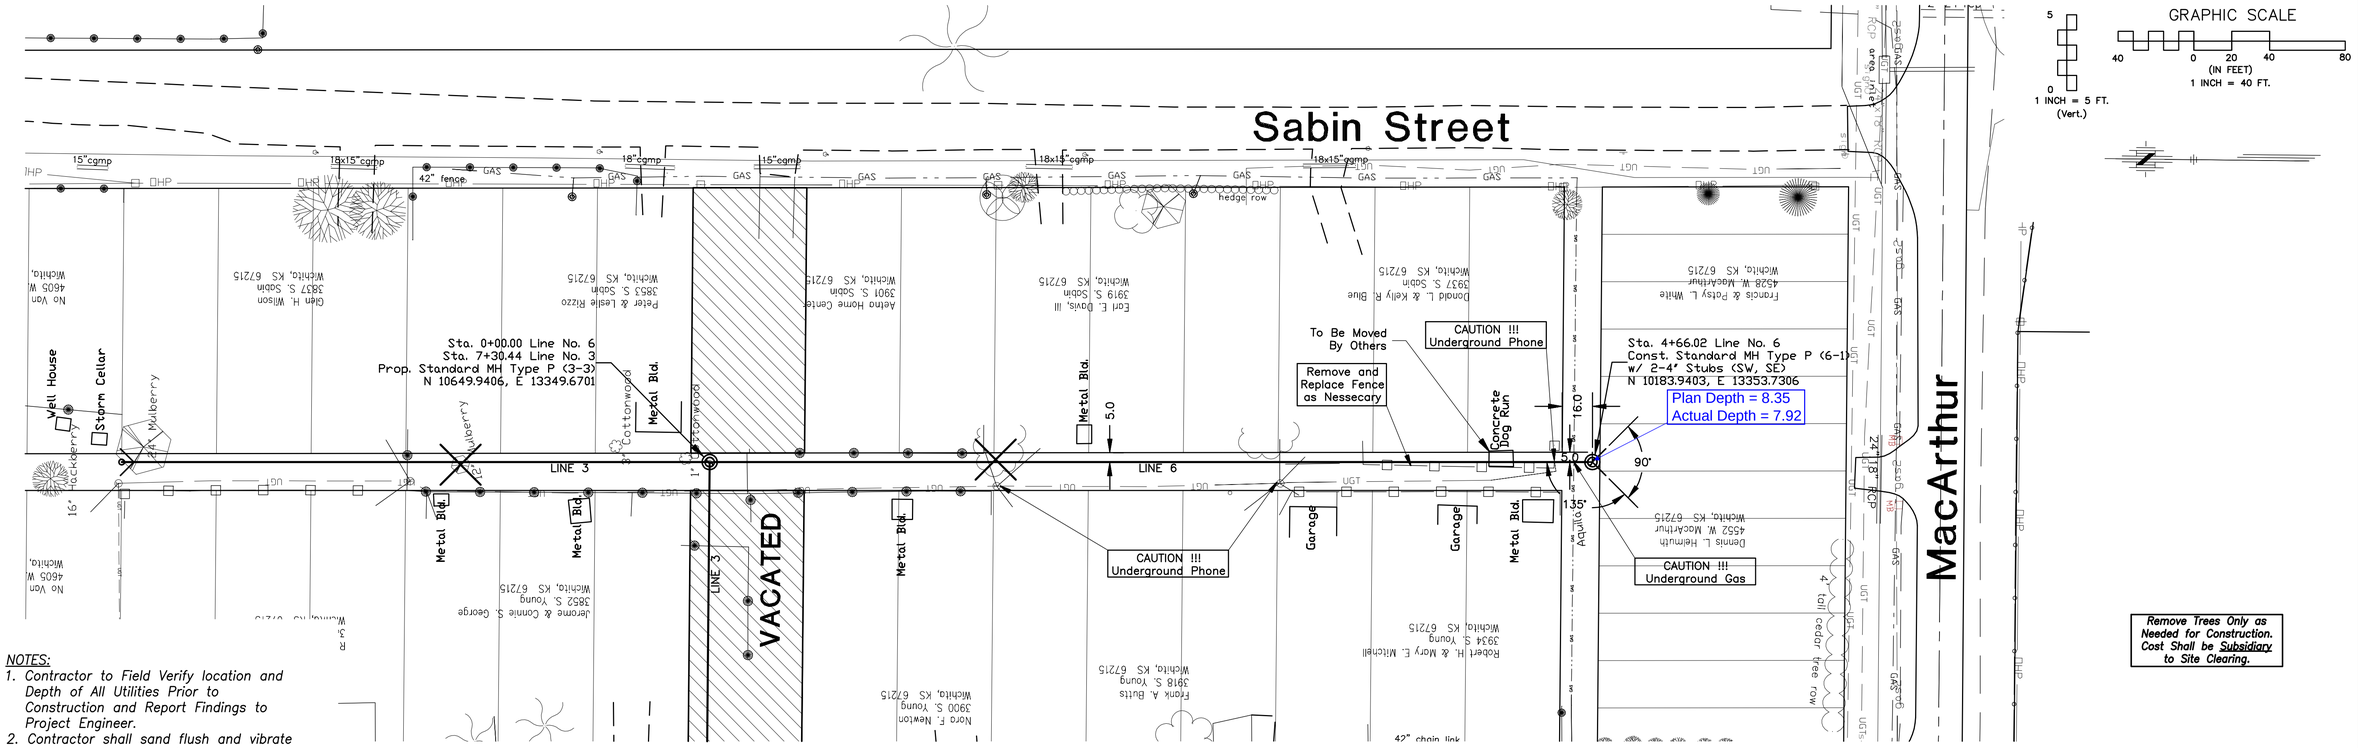

NOTES:

1. Contractor to Field Verify location and Depth of All Utilities Prior to Construction and Report Findings to Project Engineer.
2. Contractor shall sand flush and vibrate all gravel road and driveway crossings.

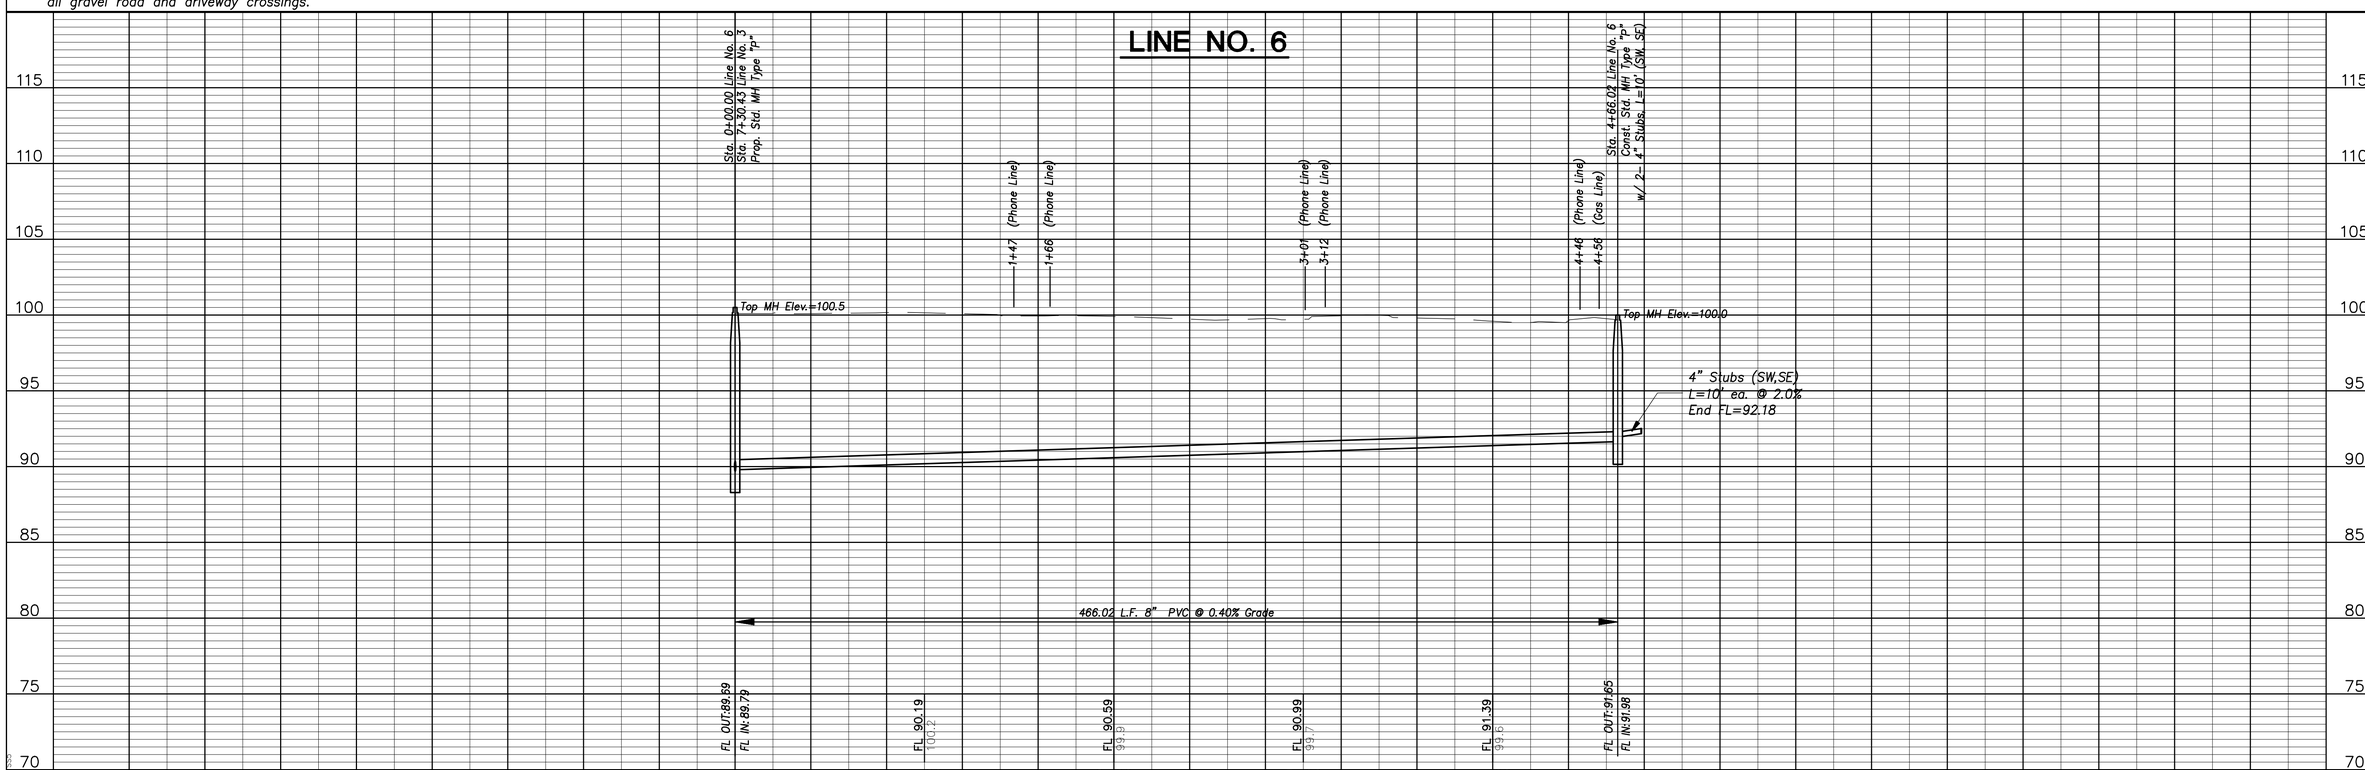

No.	Date	By	Approved	Revision

OATVILLE ADDITION
SANITARY SEWER IMPROVEMENTS
LINE NO. 6

CITY OF WICHITA, KANSAS

JAMES ARMOUR, P.E. - CITY ENGINEER
Proj.# 468-83980 O.C.A.# 744113

POE & ASSOCIATES, INC.
CONSULTING ENGINEERS
5940 E. Central, Suite 200 • Wichita, KS 67208-6242
Phone 316/685-4114 • FAX 316/685-4444

FINAL

Designed By: J. Dickman
Drawn By: M. Tucker
Poe Job No.: 1805A
Date: May 2008