FHWA REG. NO.	STATE	PROJECT NO.:	YEAR	SHEET NUMBER	TOTAL SHEETS
7	KANSAS	87 N-0502-01	2009	WL15	WL15
A.R.R.A-N05(201)					

GRAPHIC SCALE
20 0 10 20 40
(IN FEET)
1 INCH = 20 FT.

MAIZE AVENUE INC.

WL Sta. 410+28.21 = Maize Rd.
Sta. 54+16.38, 49.14' Lt.
Connect to Ex. 8" WL (W)
1-45° Bend (Vert.)
N=24600.066, E=51327.196

CAUTION!!! Telephone Crossing

20.00 L.F. 8" DICL SJ Pipe

WL Sta. 410+50.69 = Maize Rd.
Sta. 54+17.41, 26.69' Lt.
1-45° Bend (Vert.)
N=24601.458, E=51349.631

SCHMIDT, ROBERT J. & WANDA L.

WL Sta. 410+53.17 = Maize Rd.
Sta. 54+17.52, 24.21' Lt.
Connect to Exist. 8" WL (E)
1-45° Bend (Vert.)
N=24601.611, E=51352.104

2.48 L.F. 8" DICL SJ Pipe

2.48 L.F. 8" DICL SJ Pipe

Prop. 42" RCP

WL Sta. 410+30.69 = Maize Rd.
Sta. 54+16.50, 46.67' Lt.
1-45° Bend (Vert.)
N=24600.220, E=51329.669

1735 MAIZE RD. LLC

MAIZE ROAD

WL Sta. 420+10.97 = Maize Rd.
Sta. 55+76.82, 33.93' Lt.
1-45° Bend (Vert.)
N=24760.734, E=51339.753

MAIZE AVENUE INC.

CAUTION!!! Sanitary Sewer

WL Sta. 420+08.33 = Maize Rd.
Sta. 55+76.88, 36.57' Lt.
Connect to Ex. 8" & 2" WL (W)
1-45° Bend (Vert.)
N=24760.743, E=51337.112

Prop. 42" RCP

2.64 L.F. 8" DICL SJ & 2" Pipe

30.00 L.F. 8" & 2" Pipe

WL Sta. 420+40.97 = Maize Rd.
Sta. 55+76.22, 3.94' Lt.
1-45° Bend (Vert.)
N=24760.627, E=51369.753

2.64 L.F. 8" DICL SJ & 2" Pipe

WL Sta. 420+43.61 = Maize Rd.
Sta. 55+76.17, 1.30' Lt.
Connect to Exist. 8" & 2" WL (E)
1-45° Bend (Vert.)
N=24760.617, E=51372.394

FISHER, GAIL A. ETAL

DRAINAGE EASEMENT

Utility Easement

No.	Date	By	Approved	Revision
1	12/15/09	JPD	PAF	Added 8" Line at Maize Road Sta. 55+75

MAIZE ROAD
WEST KELLOGG AVE. TO PAWNEE AVE.
CITY OF WICHITA, KANSAS
WATER LINE P & P Crossing
2324+36.59 & 235+40.18

POE & ASSOCIATES, INC.
CONSULTING ENGINEERS
5940 E. Central, Suite 200 ■ Wichita, KS 67208-4242
Phone 316/685-4111 ■ FAX 316/685-4444

FINAL

Engineer: P. FERGUSON
Designer: K. WARREN
KDOT Job No.: 87 N-0502-01 Poe Job No.: 1935
Date: SEPTEMBER 2009
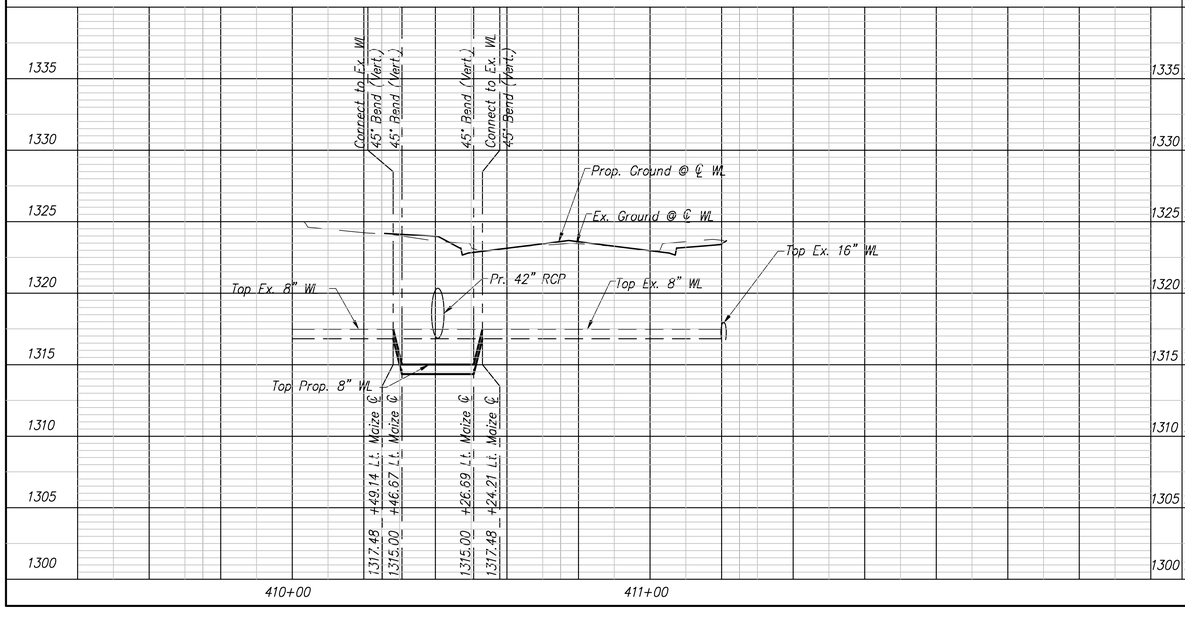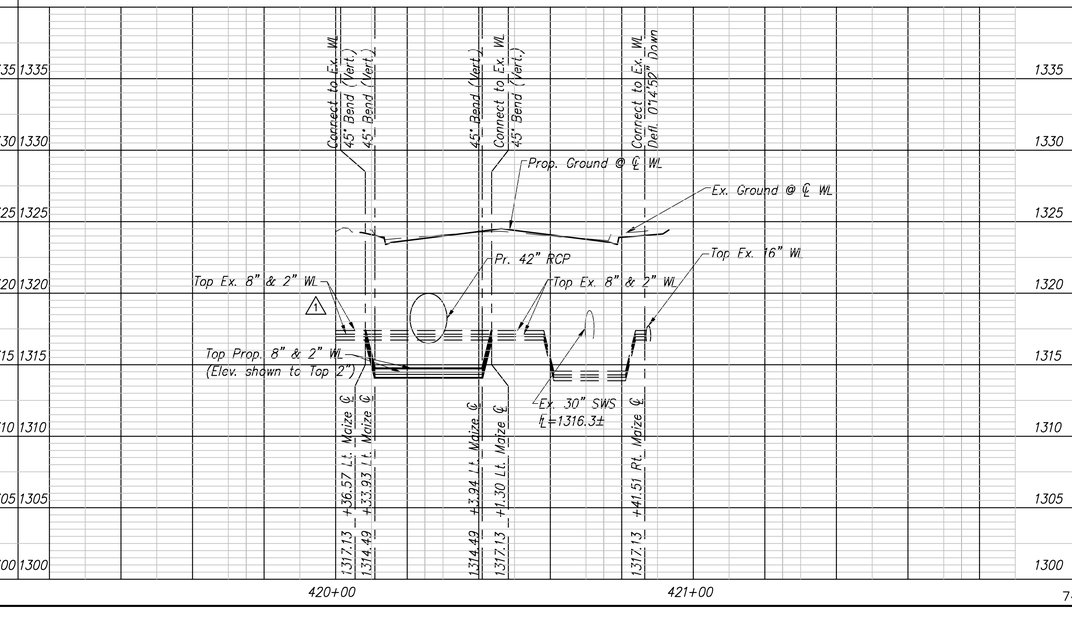
Sheet
WL15 of WL15