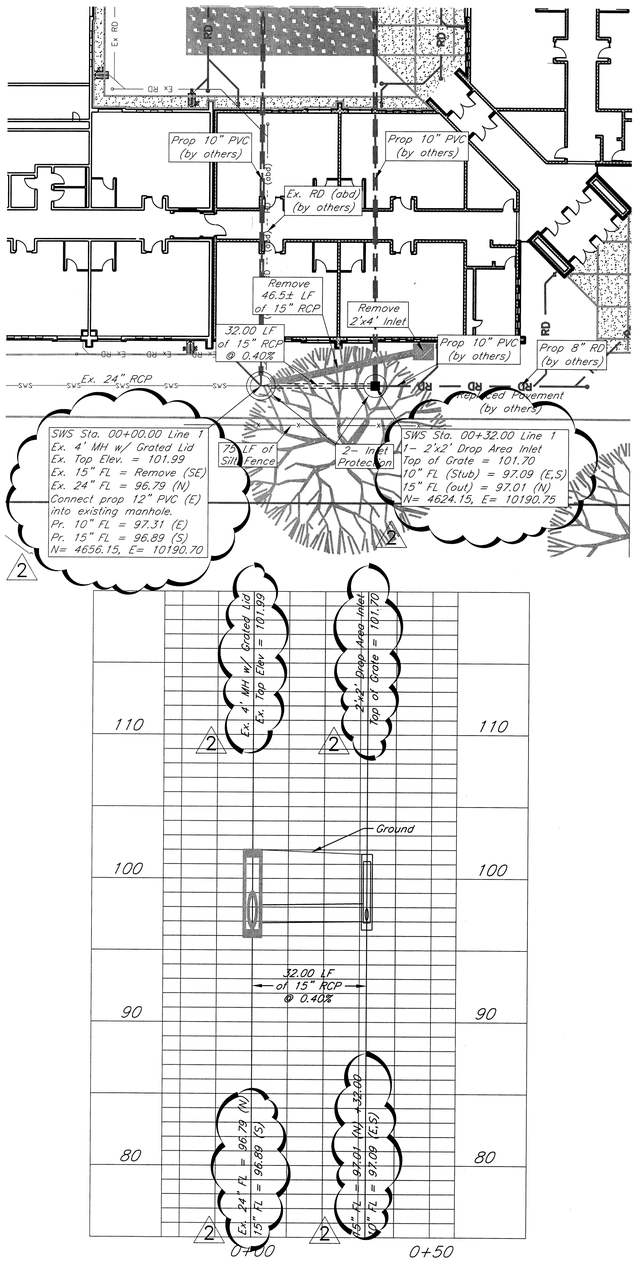

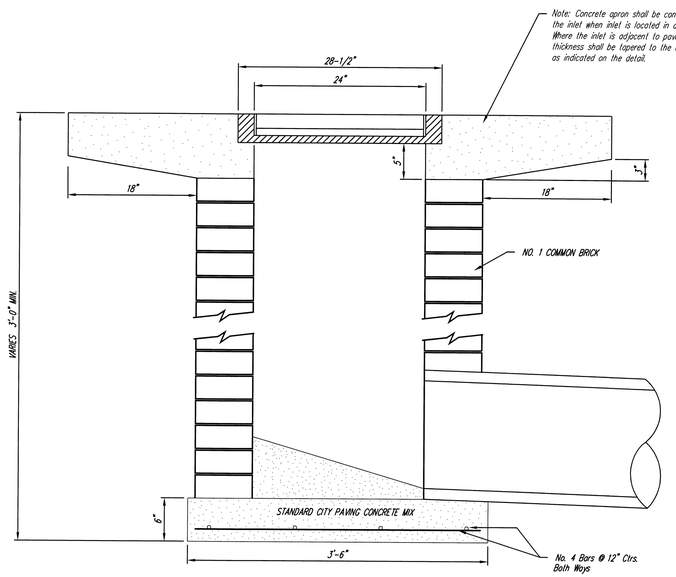

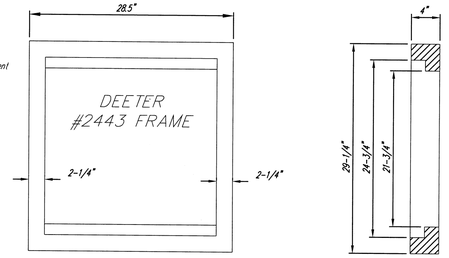

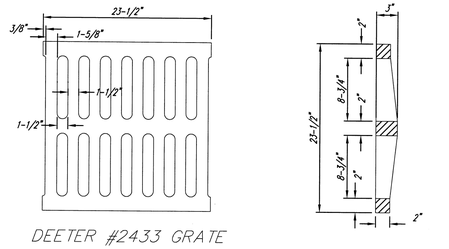

DEETER #2433 GRATE

24" x 24" Frame and Grate Detail

NOTE: Grates shall be imprinted on the top surface with "CITY OF WICHITA" using letters at least 1" in height. Other marking methods may be approved by the engineer.

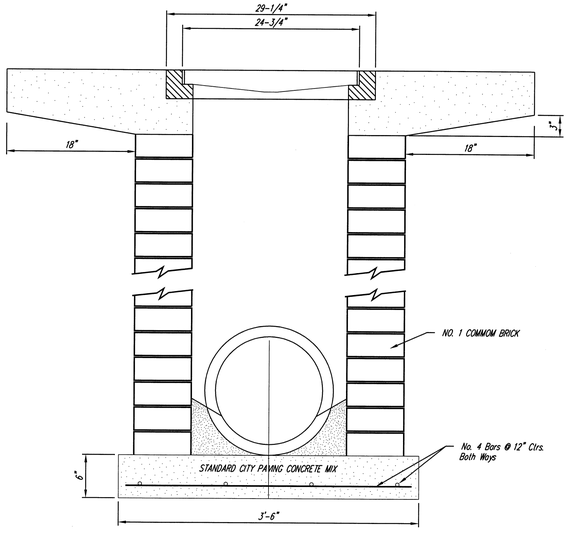

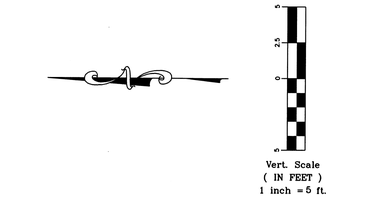

kemiller engineering
516 S. Market,
Wichita, KS 67202
316/264-0242

PBA architects
1133 East Second Street
Wichita, Kansas 67214
316.262.7400

Seal:
KIRK E. MILLER
LICENSED
11283
9/1/2010
KANSAS
PROFESSIONAL ENGINEER

LINWOOD ELEMENTARY ADDN
BID # 09-25-002
1654 S. HYDRAULIC
WICHITA, KANSAS 67211

Revisions:
2. February 09, 2010

Proj no: PK25909100
Date: November 18, 2009
Sheet title: Storm Water Sewer Plan and Profile
Drawn by: NS
Checked by: KM

C4.1

© 2009 PBA Architects

FILE NAME: PLANS sh- C4.1 PPS Plan and Details.dwg