
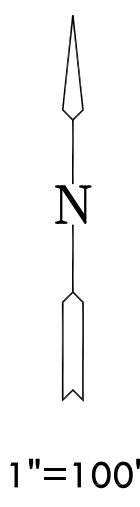


GRADING AND DRAINAGE PLANS
SUMMIT CROSSING
WICHITA, KANSAS

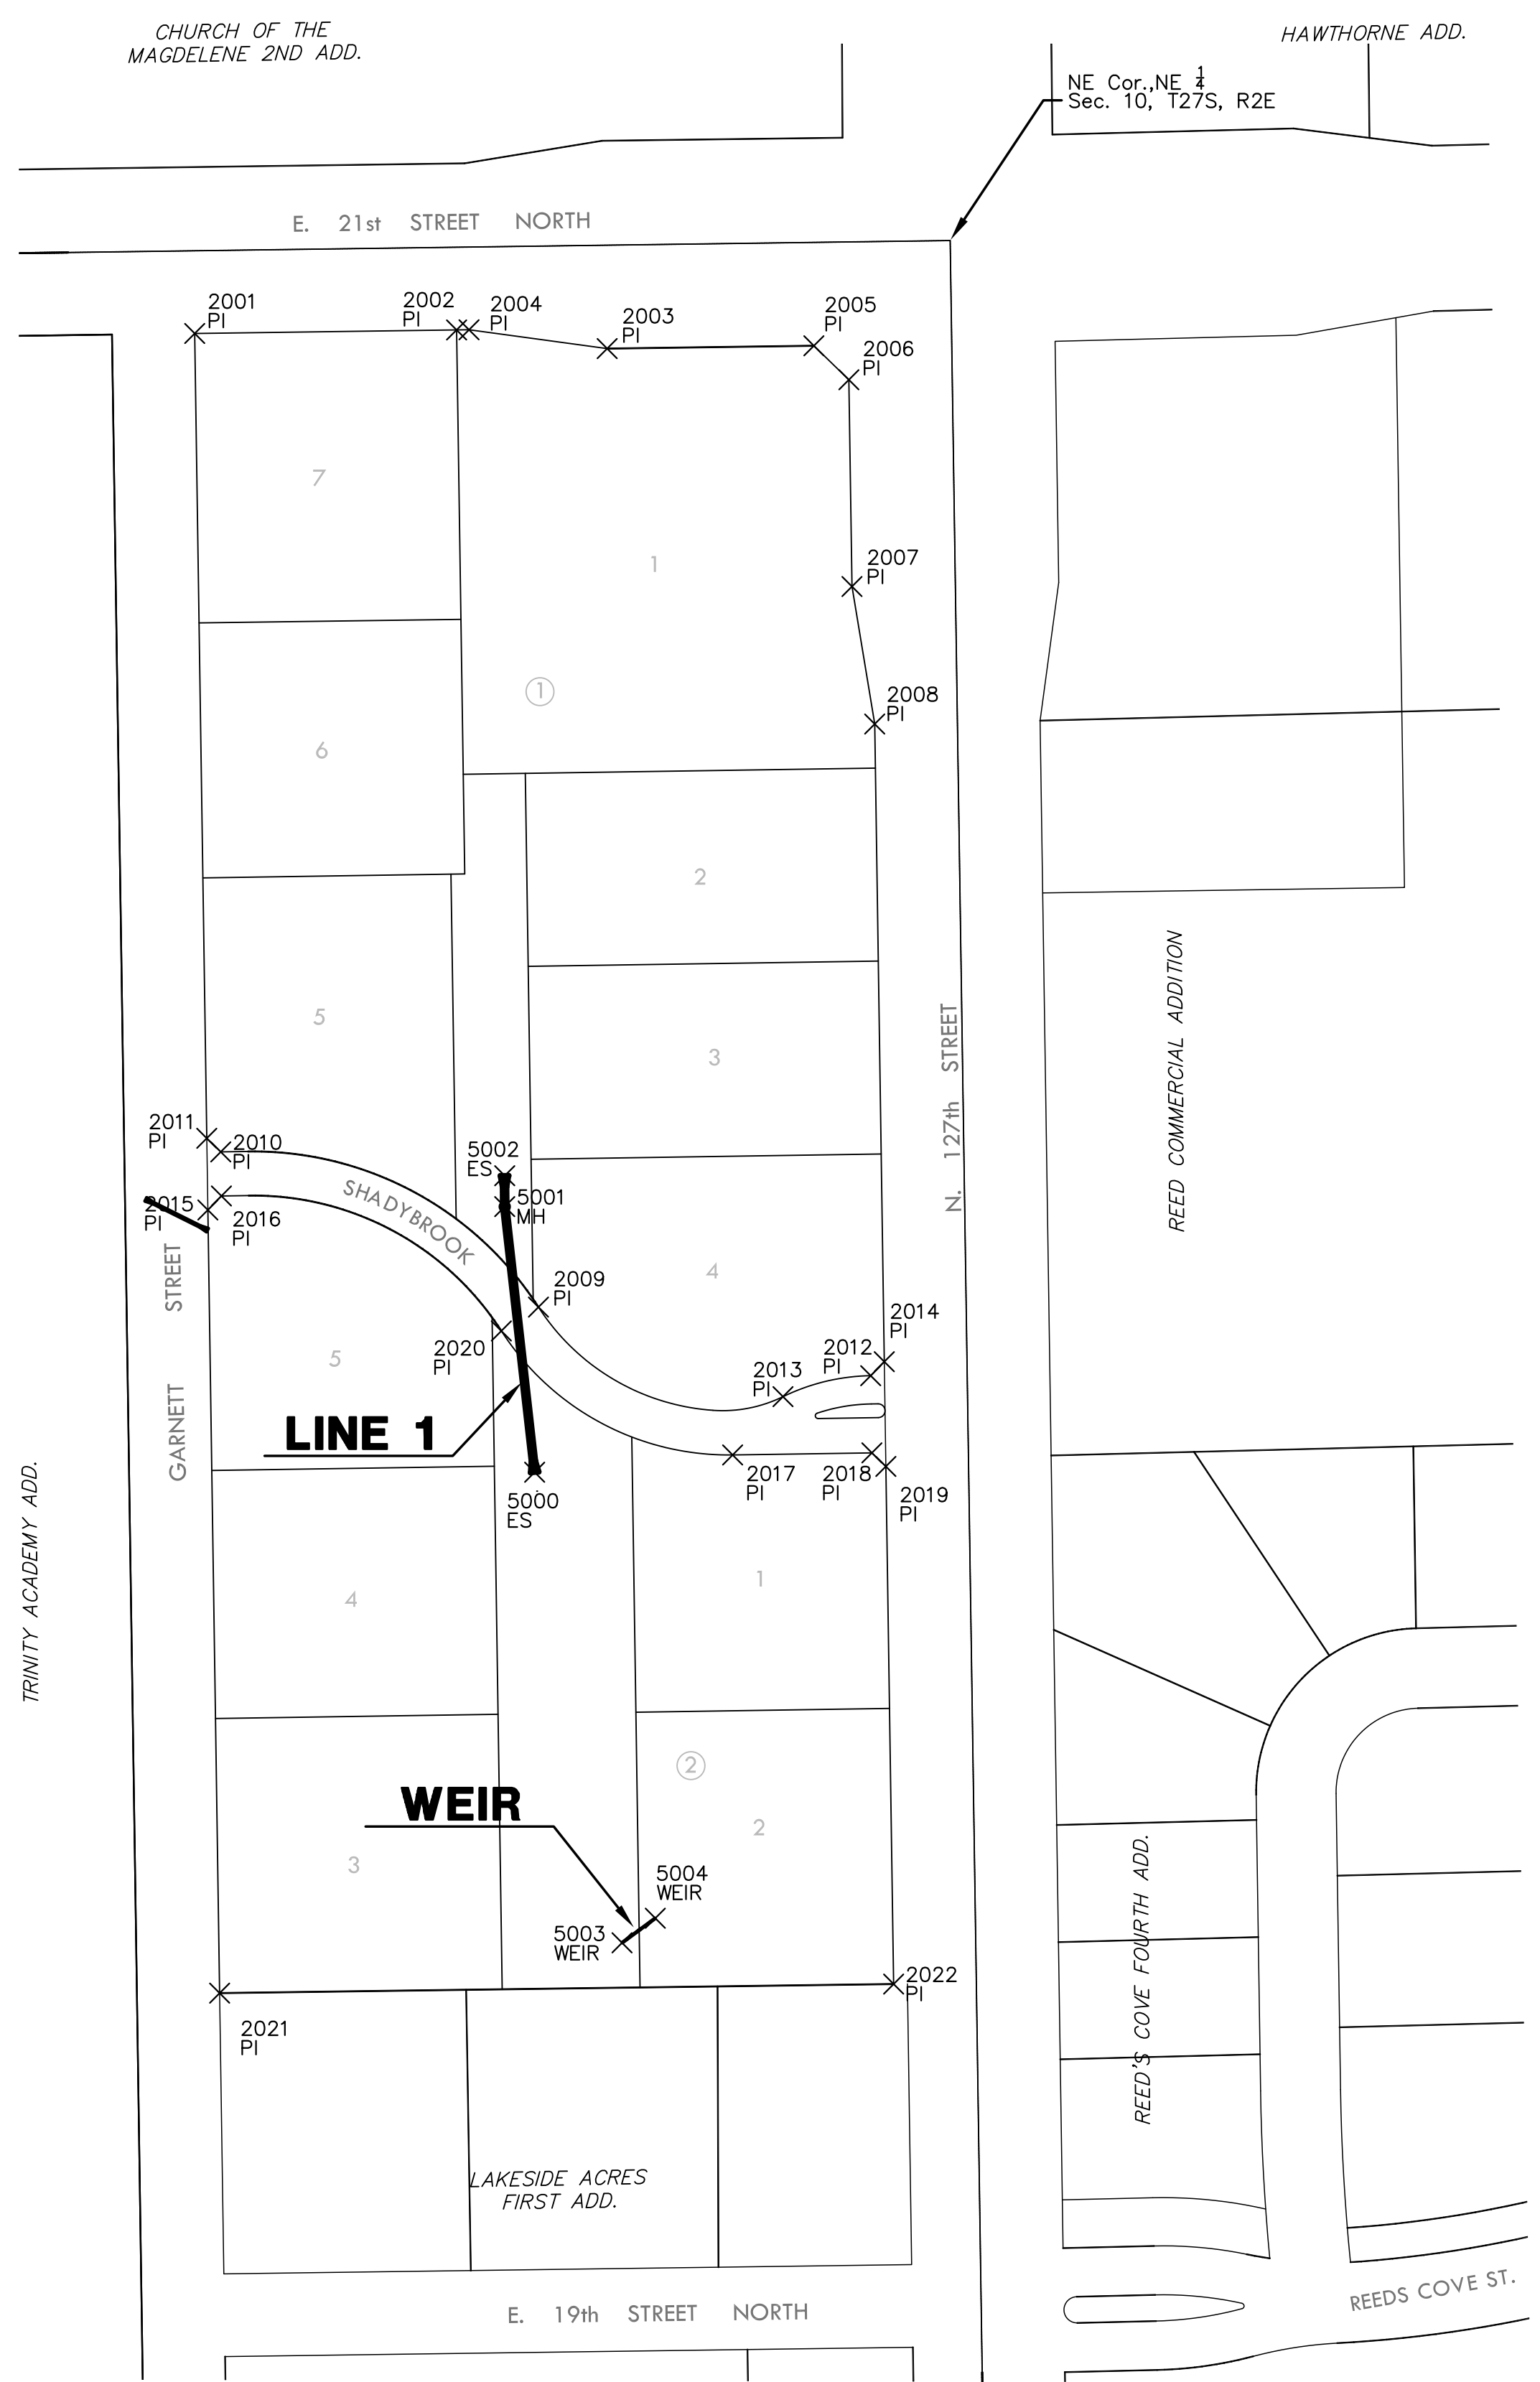

PLAT IRONS			
Point #	Northing	Easting	Desc.
2001	1699798.39	1690964.05	PI
2002	1699800.96	1691154.03	PI
2003	1699787.44	1691263.24	PI
2004	1699801.08	1691163.05	PI
2005	1699789.47	1691413.23	PI
2006	1699764.81	1691438.60	PI
2007	1699614.83	1691440.85	PI
2008	1699615.07	1691457.35	PI
2009	1699092.04	1691213.42	PI
2010	1699204.65	1690992.96	PI
2011	1699214.50	1690972.81	PI
2012	1699042.28	1691454.45	PI
2013	1699027.06	1691390.83	PI
2014	1699052.43	1691464.30	PI
2015	1699162.51	1690973.59	PI
2016	1699172.65	1690983.44	PI
2017	1698984.77	1691354.29	PI
2018	1698986.29	1691455.29	PI
2019	1698976.44	1691465.44	PI
2020	1699074.73	1691186.50	PI
2021	1698594.33	1690982.12	PI
2022	1698600.90	1691471.08	PI

SWS POINTS			
Point #	Northing	Easting	Desc.
5000	169972.25	1691210.66	ES
5001	1699164.95	1691188.95	MH
5002	1699187.35	1691188.95	ES
5003	1699630.84	1691274.05	WEIR
5004	1699648.68	1691298.18	WEIR

PLOTTED: Friday, March 26, 2010 @ 09:24AM

J:\CIVIL\08542\DWG\GRD\PHASE1\08542_BUBBLE.DWG

BUBBLE MAP
SHEET TITLE
08542
PROJECT NUMBER

DFL
DESIGN BY
KKL
DRAWN BY
GJA
CHECKED BY

ISSUED
March 2010
REVISED

SHEET NO.
9 of 15