


WYN-WOOD ADDITION

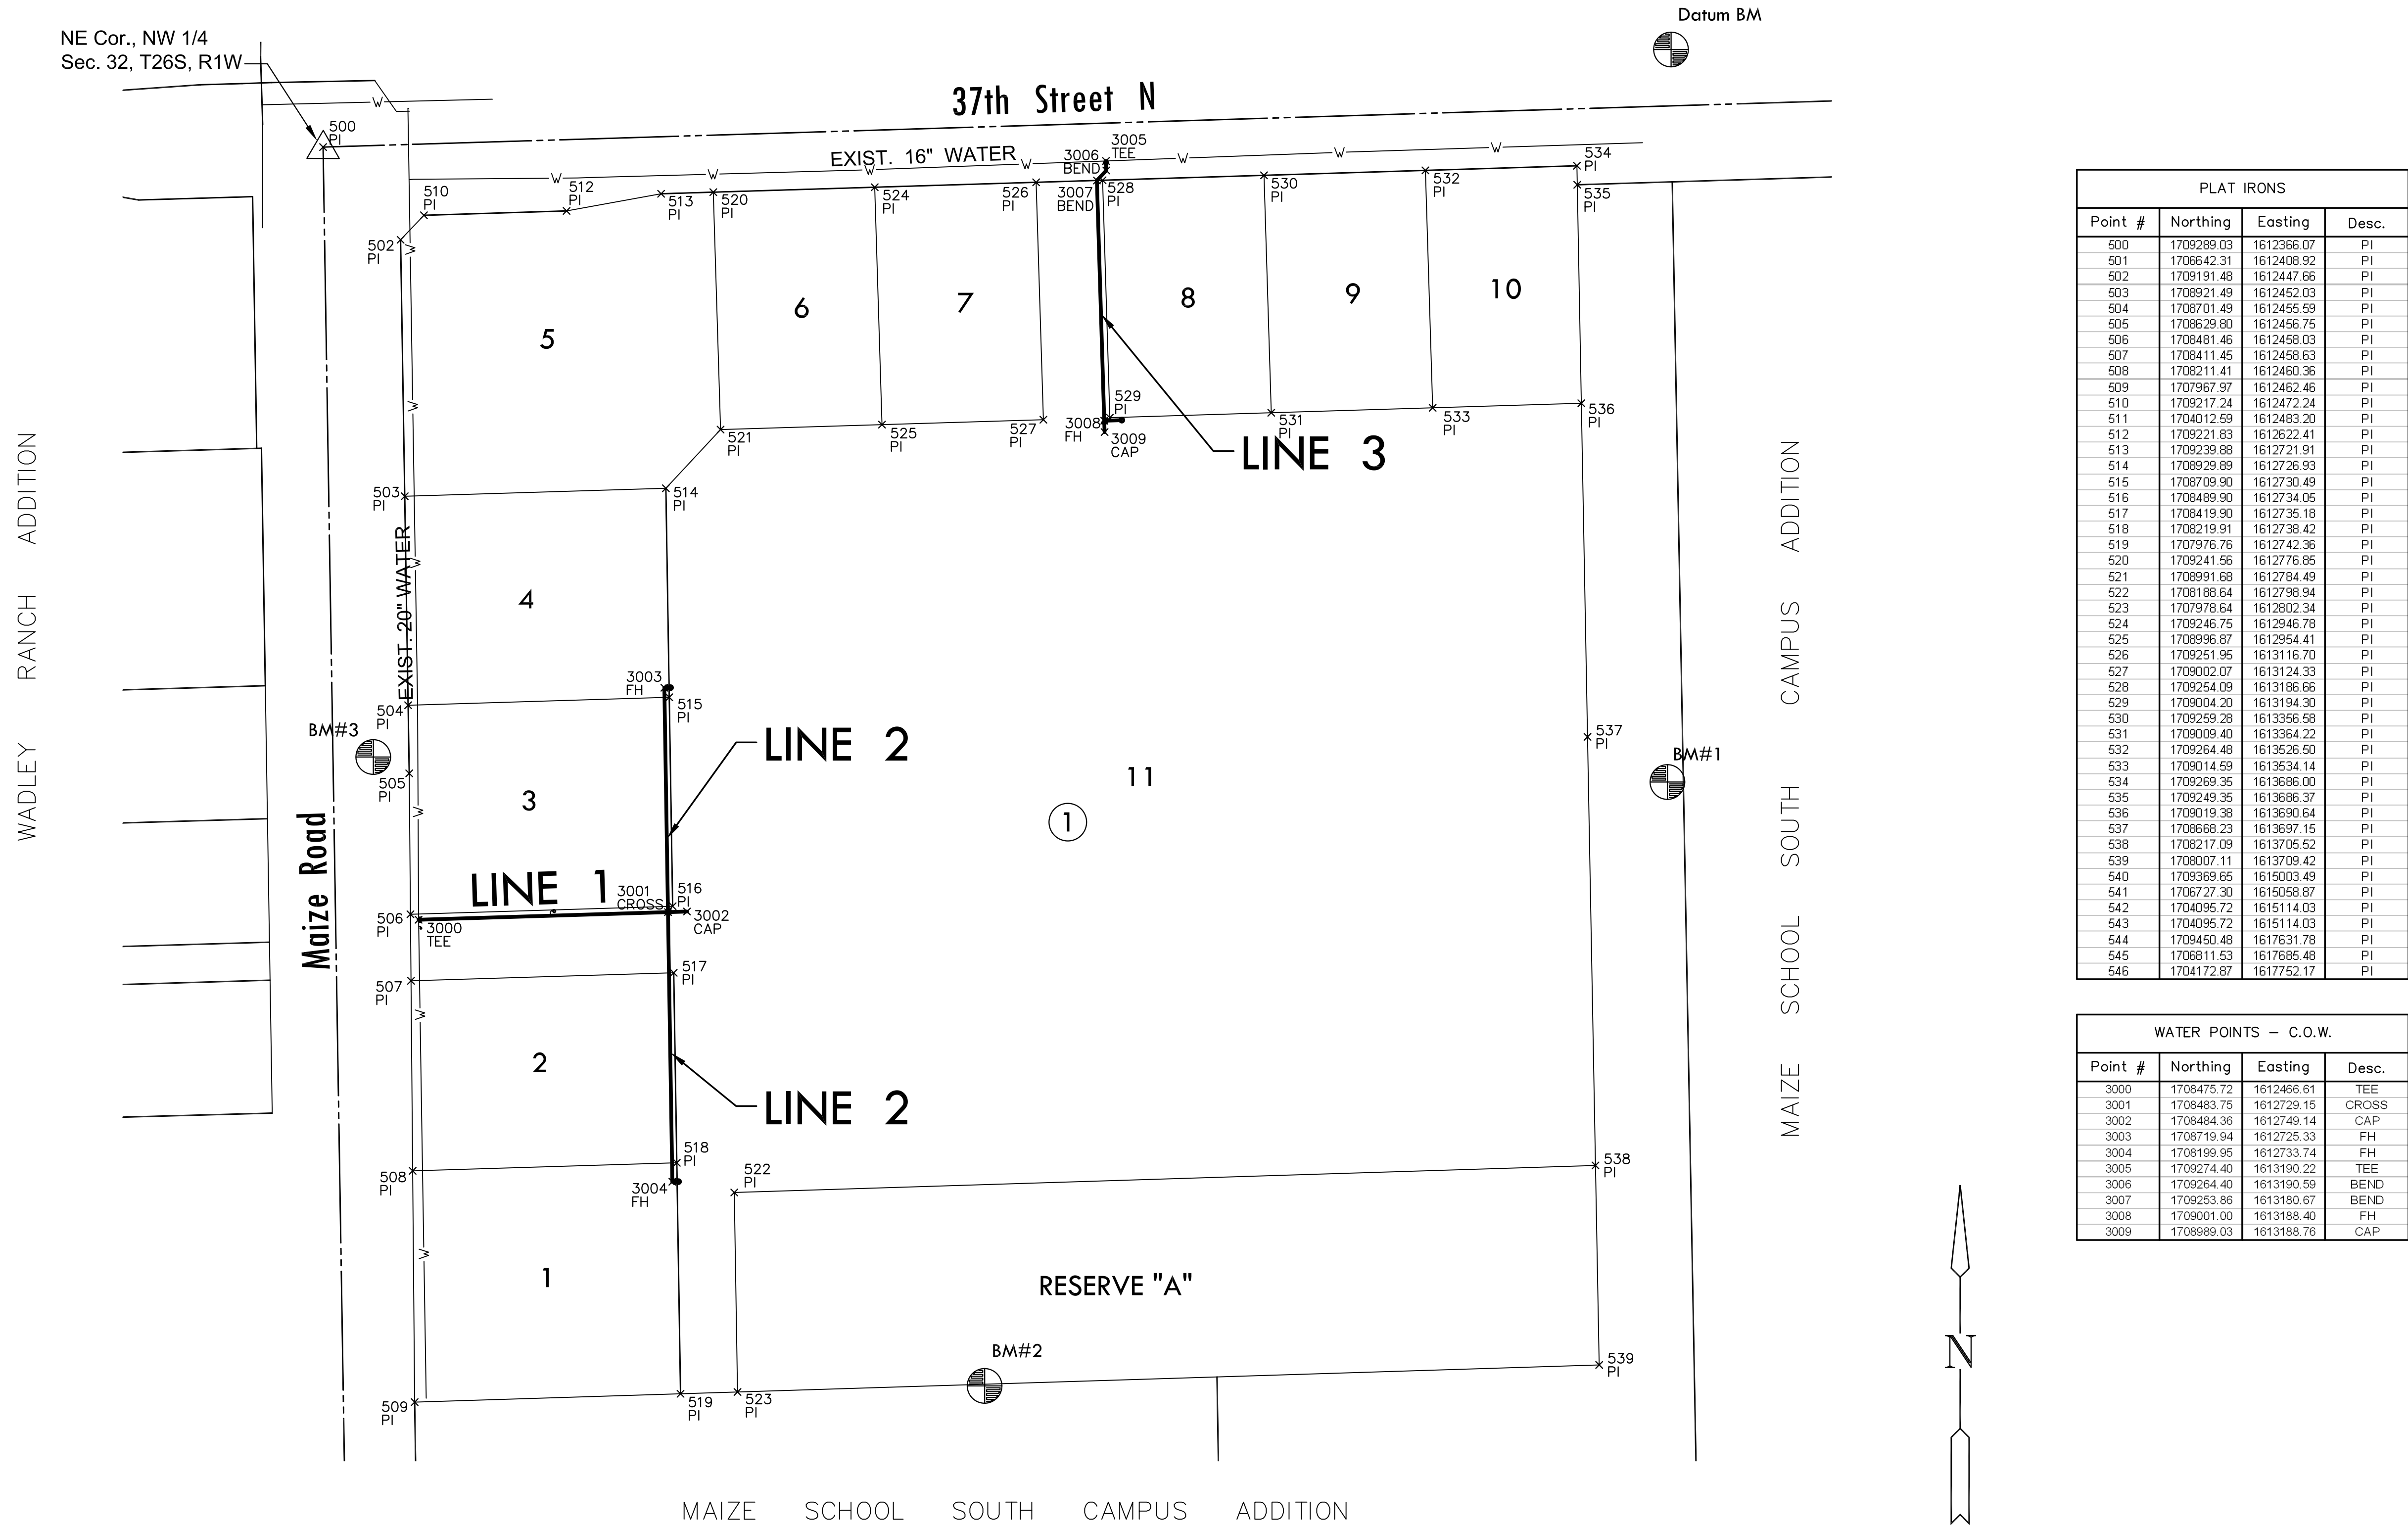

PLAT IRONS			
Point #	Northing	Easting	Desc.
500	1709289.03	1612366.07	PI
501	1706642.31	1612408.92	PI
502	1709191.48	1612447.66	PI
503	1708921.49	1612452.03	PI
504	1708701.49	1612455.59	PI
505	1708629.80	1612456.75	PI
506	1708481.46	1612458.03	PI
507	1708411.45	1612458.63	PI
508	1708211.41	1612460.36	PI
509	1707967.97	1612462.46	PI
510	1709217.24	1612472.24	PI
511	1704012.59	1612483.20	PI
512	1709221.63	1612522.41	PI
513	1709239.88	1612721.91	PI
514	1708929.89	1612726.93	PI
515	1708709.90	1612730.49	PI
516	1708489.90	1612734.05	PI
517	1708419.90	1612735.18	PI
518	1708219.91	1612738.42	PI
519	1707976.76	1612742.36	PI
520	1709241.56	1612776.85	PI
521	1708991.68	1612784.49	PI
522	1708188.64	1612798.94	PI
523	1707978.64	1612802.34	PI
524	1709246.75	1612946.79	PI
525	1708996.67	1612954.41	PI
526	1709251.95	1613116.70	PI
527	1709002.07	1613124.33	PI
528	1709254.09	1613186.66	PI
529	1709004.20	1613194.30	PI
530	1709259.28	1613356.58	PI
531	1709009.40	1613364.22	PI
532	1709264.48	1613526.50	PI
533	1709014.59	1613534.14	PI
534	1709269.35	1613686.00	PI
535	1709249.35	1613686.37	PI
536	1709019.38	1613690.64	PI
537	1708663.23	1613697.15	PI
538	1708217.09	1613705.52	PI
539	1708007.11	1613709.42	PI
540	1709369.65	1615003.49	PI
541	1706727.30	1615058.87	PI
542	1704095.72	1615114.03	PI
543	1704095.72	1615114.03	PI
544	1709450.48	1617631.78	PI
545	1706811.53	1617685.48	PI
546	1704172.87	1617752.17	PI

WATER POINTS - C.O.W.			
Point #	Northing	Easting	Desc.
3000	1708475.72	1612466.61	TEE
3001	1708483.75	1612729.15	CROSS
3002	1708484.36	1612749.14	CAP
3003	1708719.94	1612725.33	FH
3004	1708199.95	1612733.74	FH
3005	1709274.40	1613190.22	TEE
3006	1709264.40	1613190.59	BEND
3007	1709253.86	1613180.67	BEND
3008	1709001.00	1613188.40	FH
3009	1708989.03	1613188.76	CAP

**WATER DISTRIBUTION SYSTEM**  
**STONEBRIDGE COMMERCIAL**  
**ADDITION**

**BUBBLE MAP**  
SHEET TITLE  
**448-90418**  
PROJECT NUMBER

DESIGN BY: **DFL**  
DRAWN BY: **KKL**  
CHECKED BY: **GJA**

ISSUED: **April 2010**  
REVISED:

SHEET NO.  
**5 of 11**