THE CONTRACTOR SHALL GRADE THE DITCH TO MAINTAIN POSITIVE DRAINAGE. ALL COSTS SHALL BE SUBSIDIARY TO OTHER BID ITEMS.

THE CONTRACTOR SHALL REMOVE AND REPLACE THE EXISTING ROADWAY AND DRIVEWAYS TO CITY STANDARDS.

THE CONTRACTOR SHALL CONSTRUCT RISERS AS SHOWN IN THE SEWER SERVICE TABLE (SHEET NO. 2) AND THE VERTICAL RISER DETAILS (SHEET NO. 11).

THE CULVERT PIPES SHALL BE REMOVED AND REPLACED AS NECESSARY TO FACILITATE CONSTRUCTION OF THE SANITARY SEWER PROJECT. IF IN THE OPINION OF THE AREA ENGINEER THAT A CULVERT PIPE CAN BE REUSED, THE EXISTING CULVERT PIPE SHALL BE CLEANED OUT AND RESET. IF REPLACEMENT OF THE CULVERT PIPE IS REQUIRED, THE CULVERT PIPE SHALL BE OF THE SAME GAUGE AS REQUIRED FOR CITY OF WICHITA PAVING PROJECTS. COSTS FOR SUCH REMOVAL AND REPLACEMENT SHALL BE CONSIDERED SUBSIDIARY TO THE SITE RESTORATION BID ITEM AND NOT BE BID OR PAID FOR SEPARATELY.

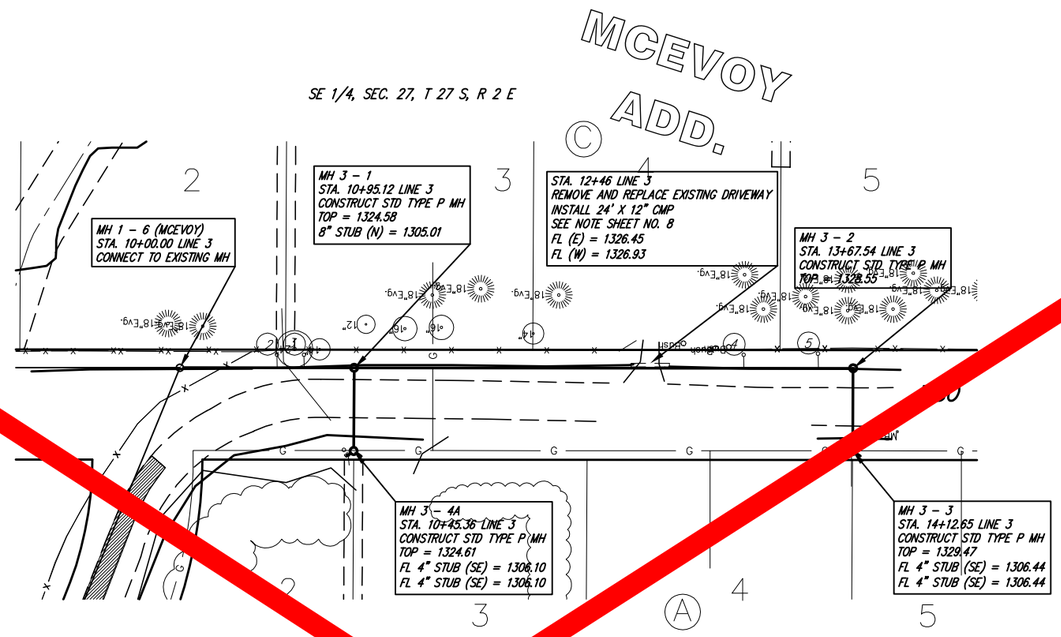

Scale 1" = 40' (Horiz.)
1" = 5' (Vert.)

3' 2' 1' 0
10' 0 20' 40'

See Revised Sheet

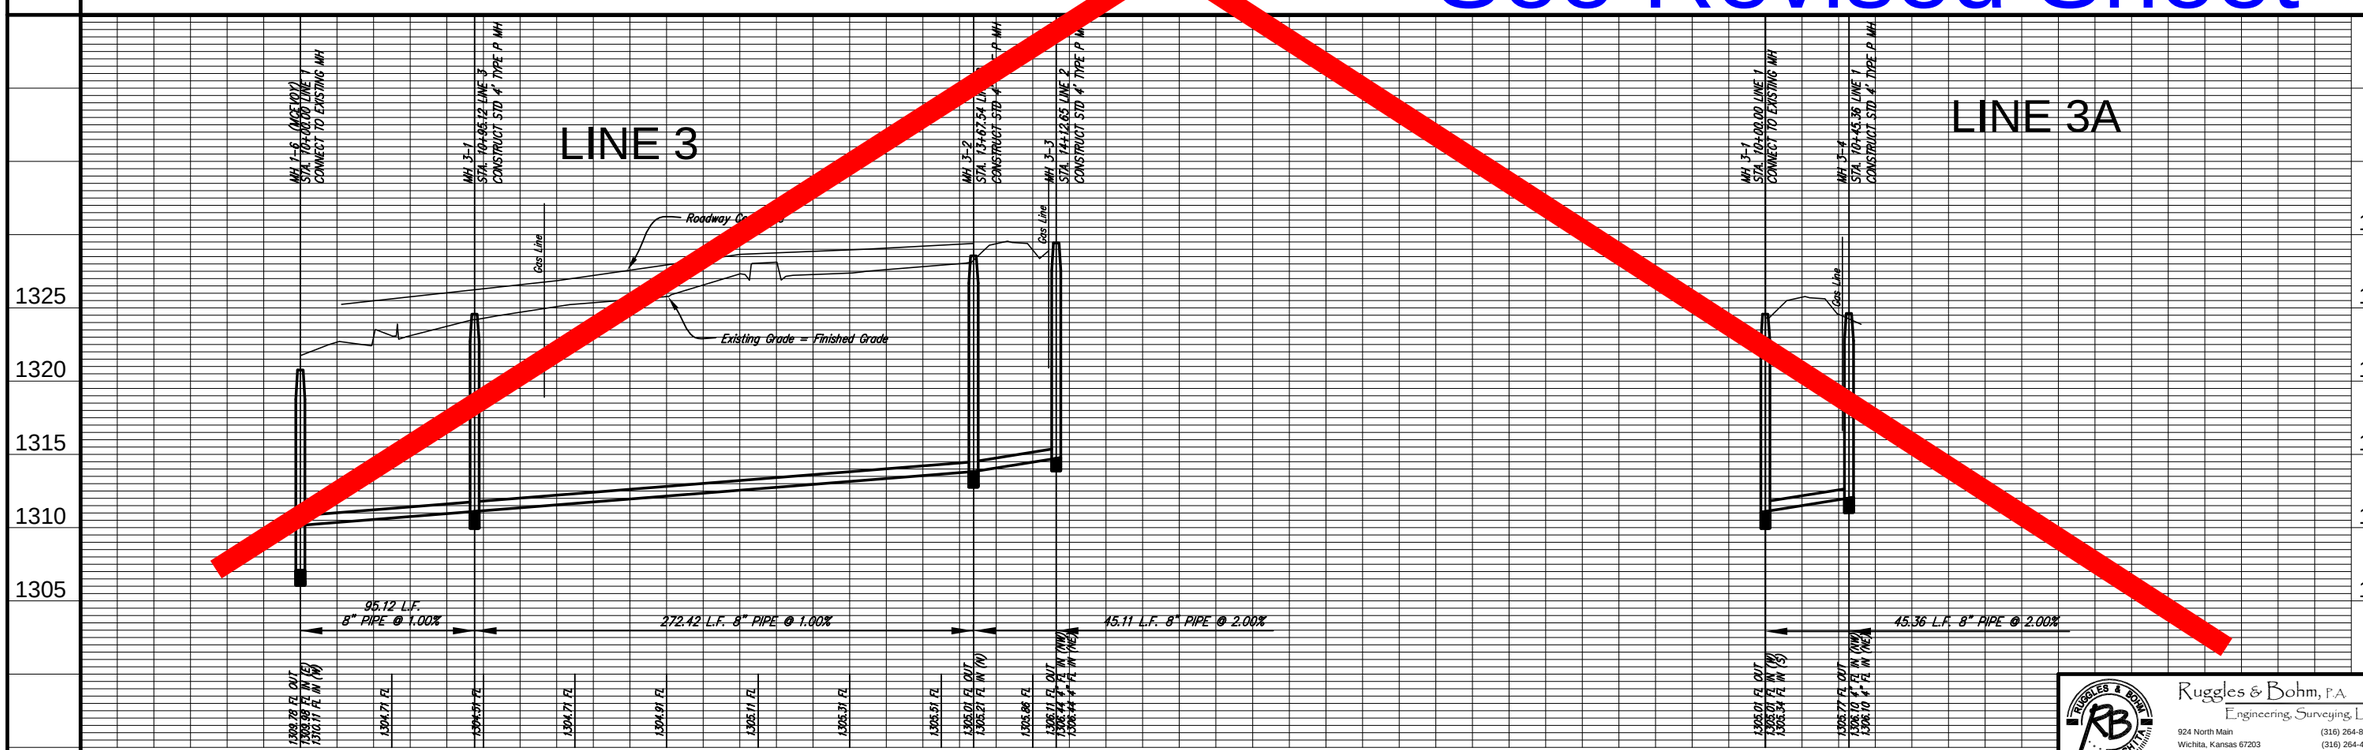

DESIGN PDC	DRAWN PDC
UTILITY	DATE 9/26/05
REVISED	REVIEW
PROJECT NUMBER 468-84033	DRAWING FILE ergg. base

MCEVOY SANITARY SEWER
LATERAL LINE 3
WICHITA, KANSAS

Ruggles & Bohm, P.A.
Engineering, Surveying, Land Planning
924 North Main
Wichita, Kansas 67203
www.rbkansas.com
(316) 264-8008
(316) 264-4621 fax
E-mail: info@rbkansas.com

RB JOB 2612X