

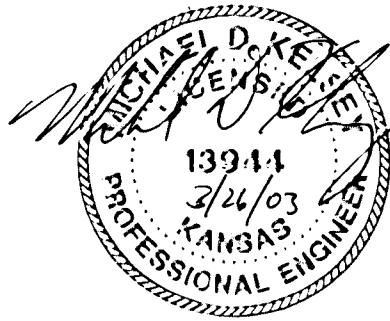
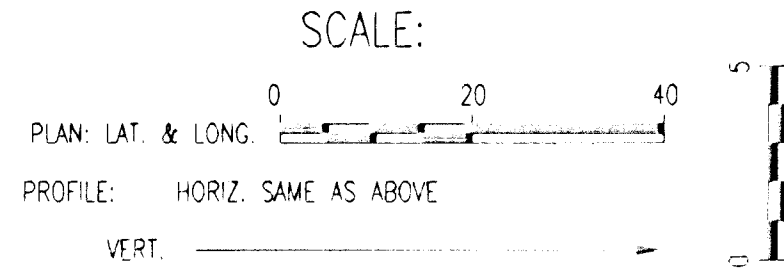


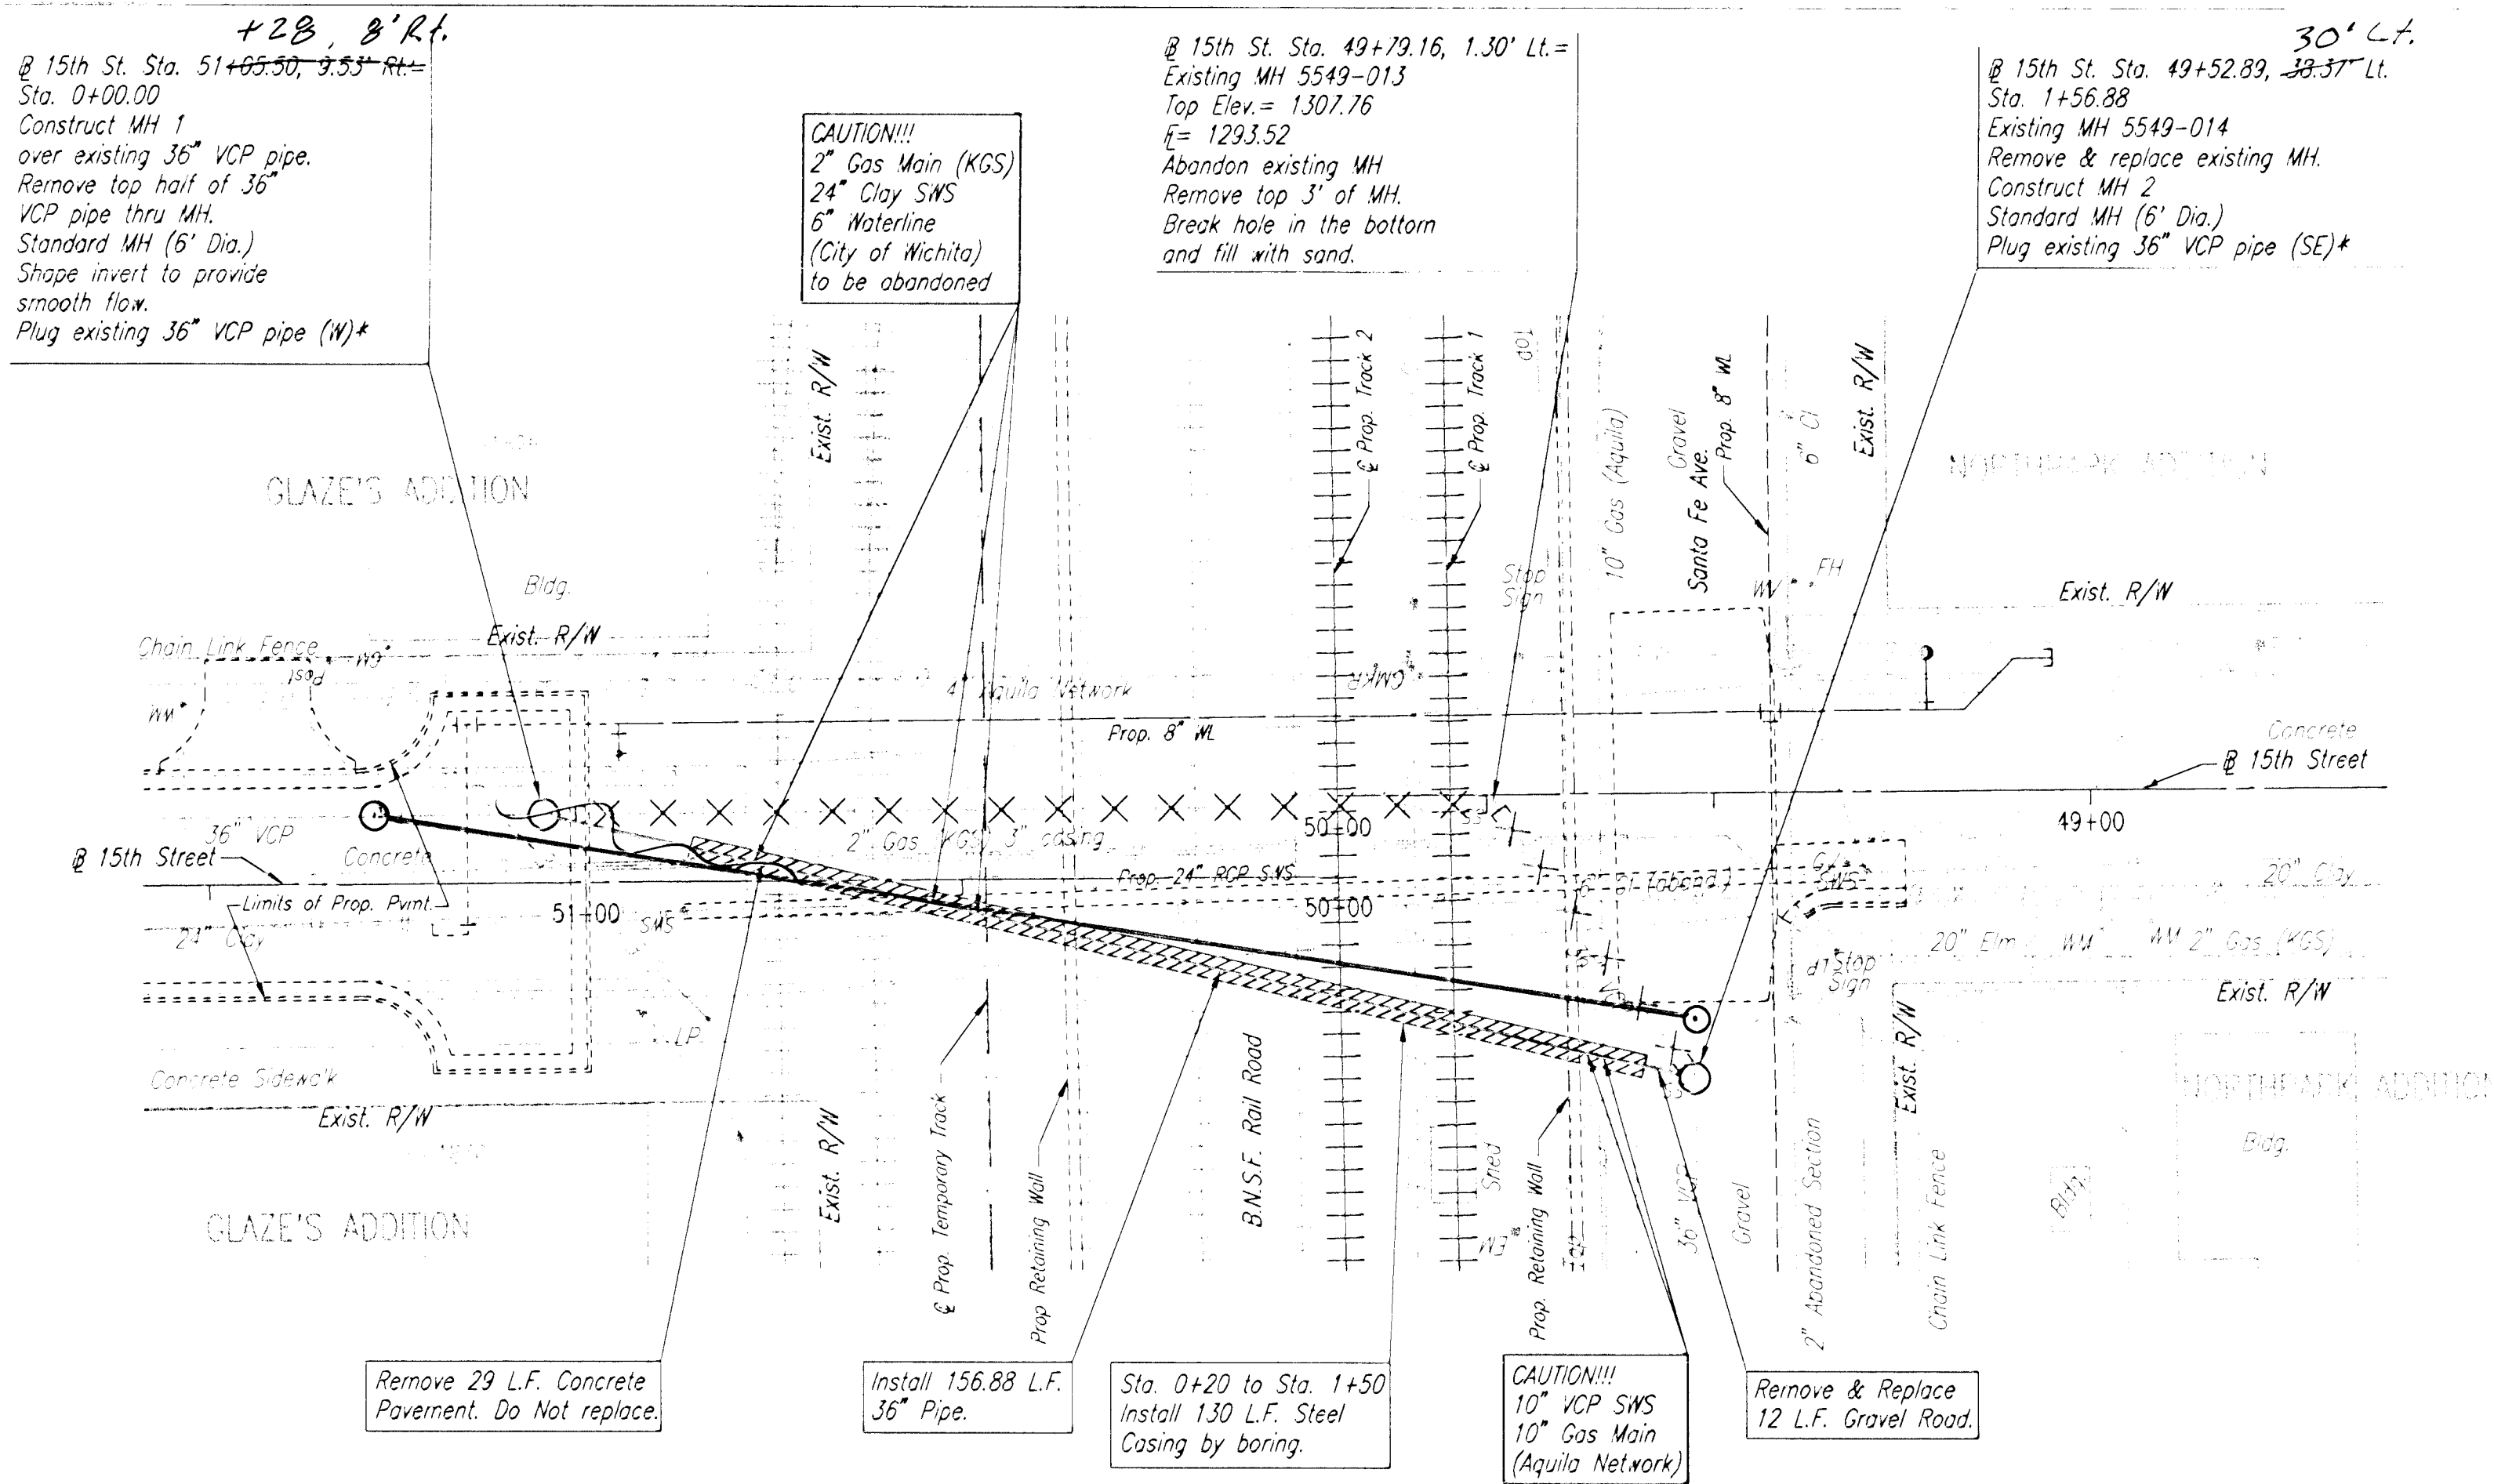

*CONTRACTOR SHALL FILL EXISTING 36" SANITARY SEWER TO BE ABANDONED WITH JETTED SAND OR FLOWABLE FILL TO THE LIMITS SHOWN. PRICE SUBSIDIARY TO PROJECT COSTS.

SANITARY SEWER LINE NO. 1

□ - Denotes Caps or Plugs to be Installed
X - Denotes Sanitary Sewer to be Abandoned.

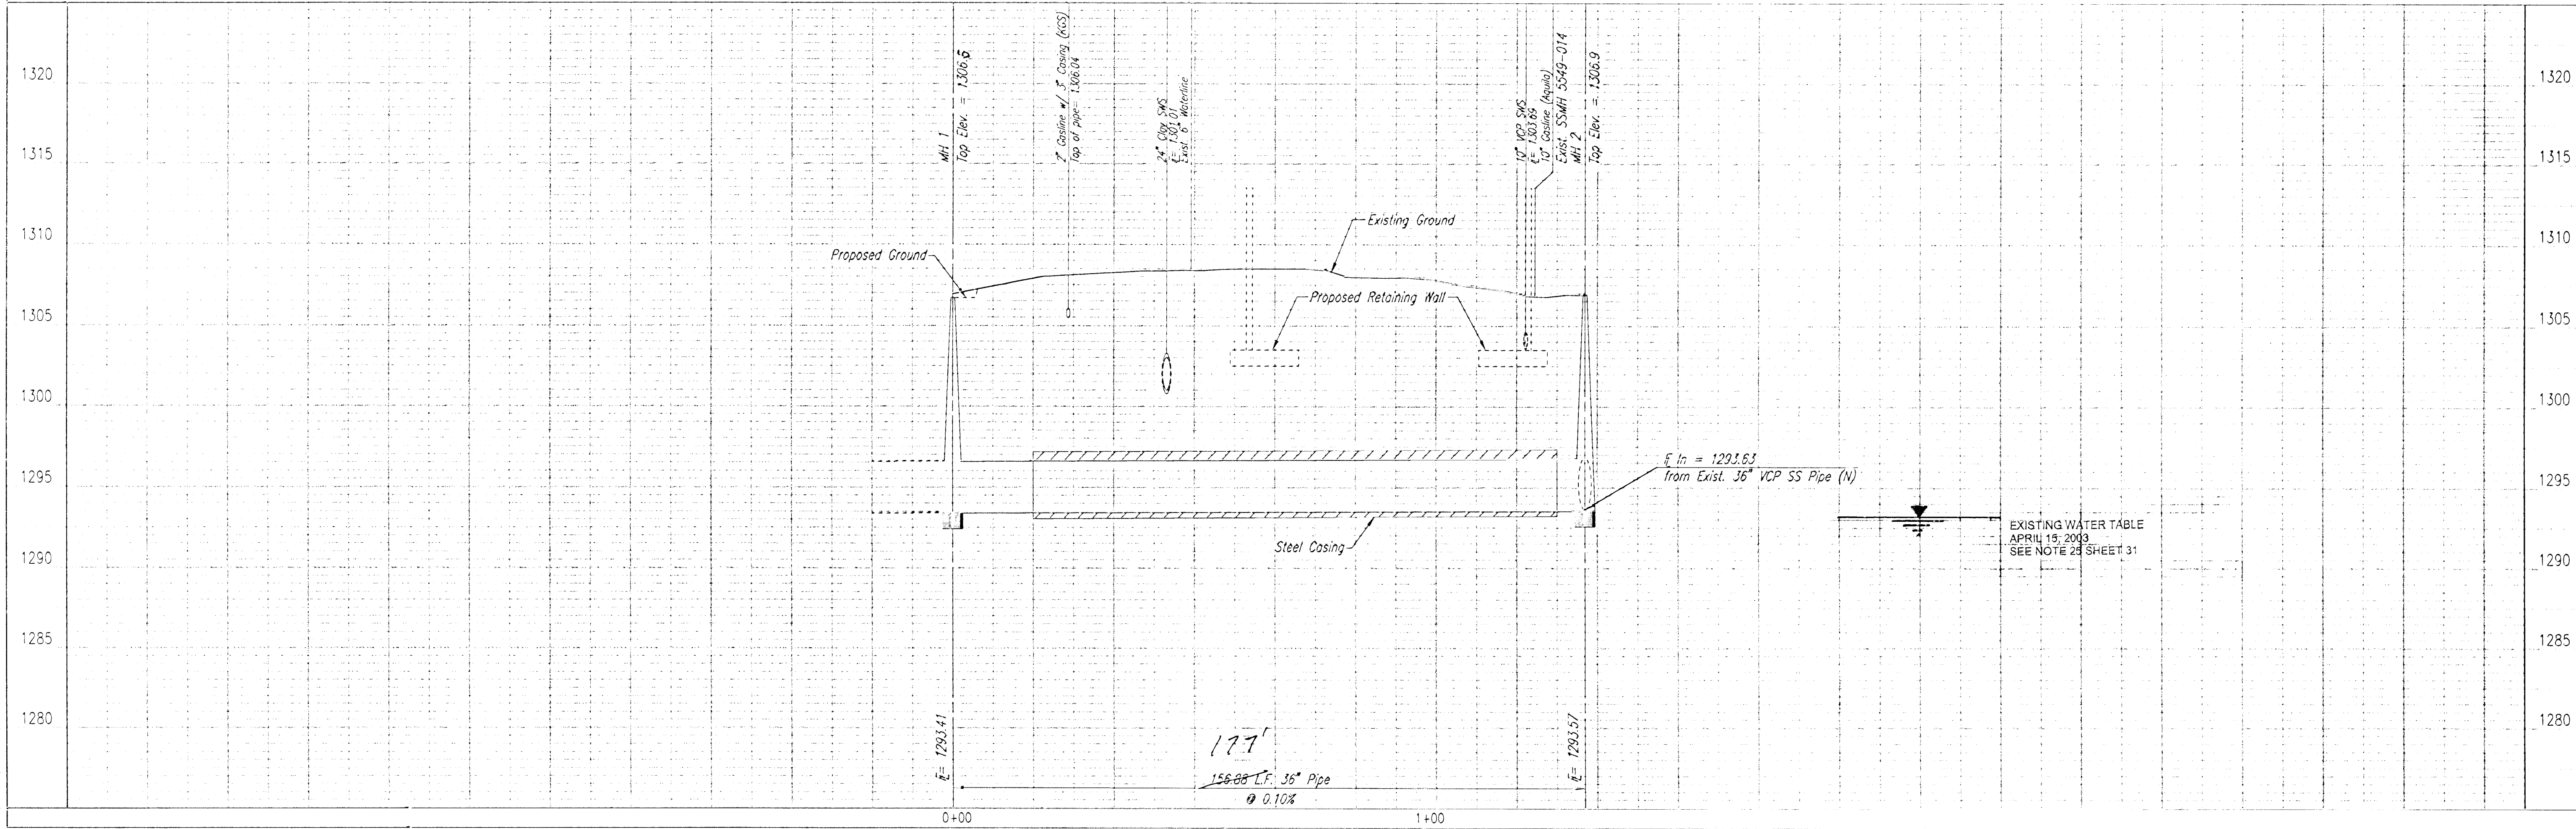

SANITARY SEWER LINE NO. 1

Professional Engineering Consultants, P.A.
303 S. TOPEKA • WICHITA, KANSAS 67202
316-262-2691 • FAX 316-262-3003

Designed By: MOK
Drawn By: GJR, JLM

Job No: 34-99189-4
Date: August 2002