


STATE	PROJECT NO.	YEAR	SHEET NO.	SHEETS
KANSAS	87 N-0349-01	2009	65	133

MKEC
ENGINEERING
CONSULTANTS, INC.

411 N. WEBB ROAD
WICHITA, KS. 67206
316 - 684 - 9600

④ Service location. See Sht. 55 for Station and direction.

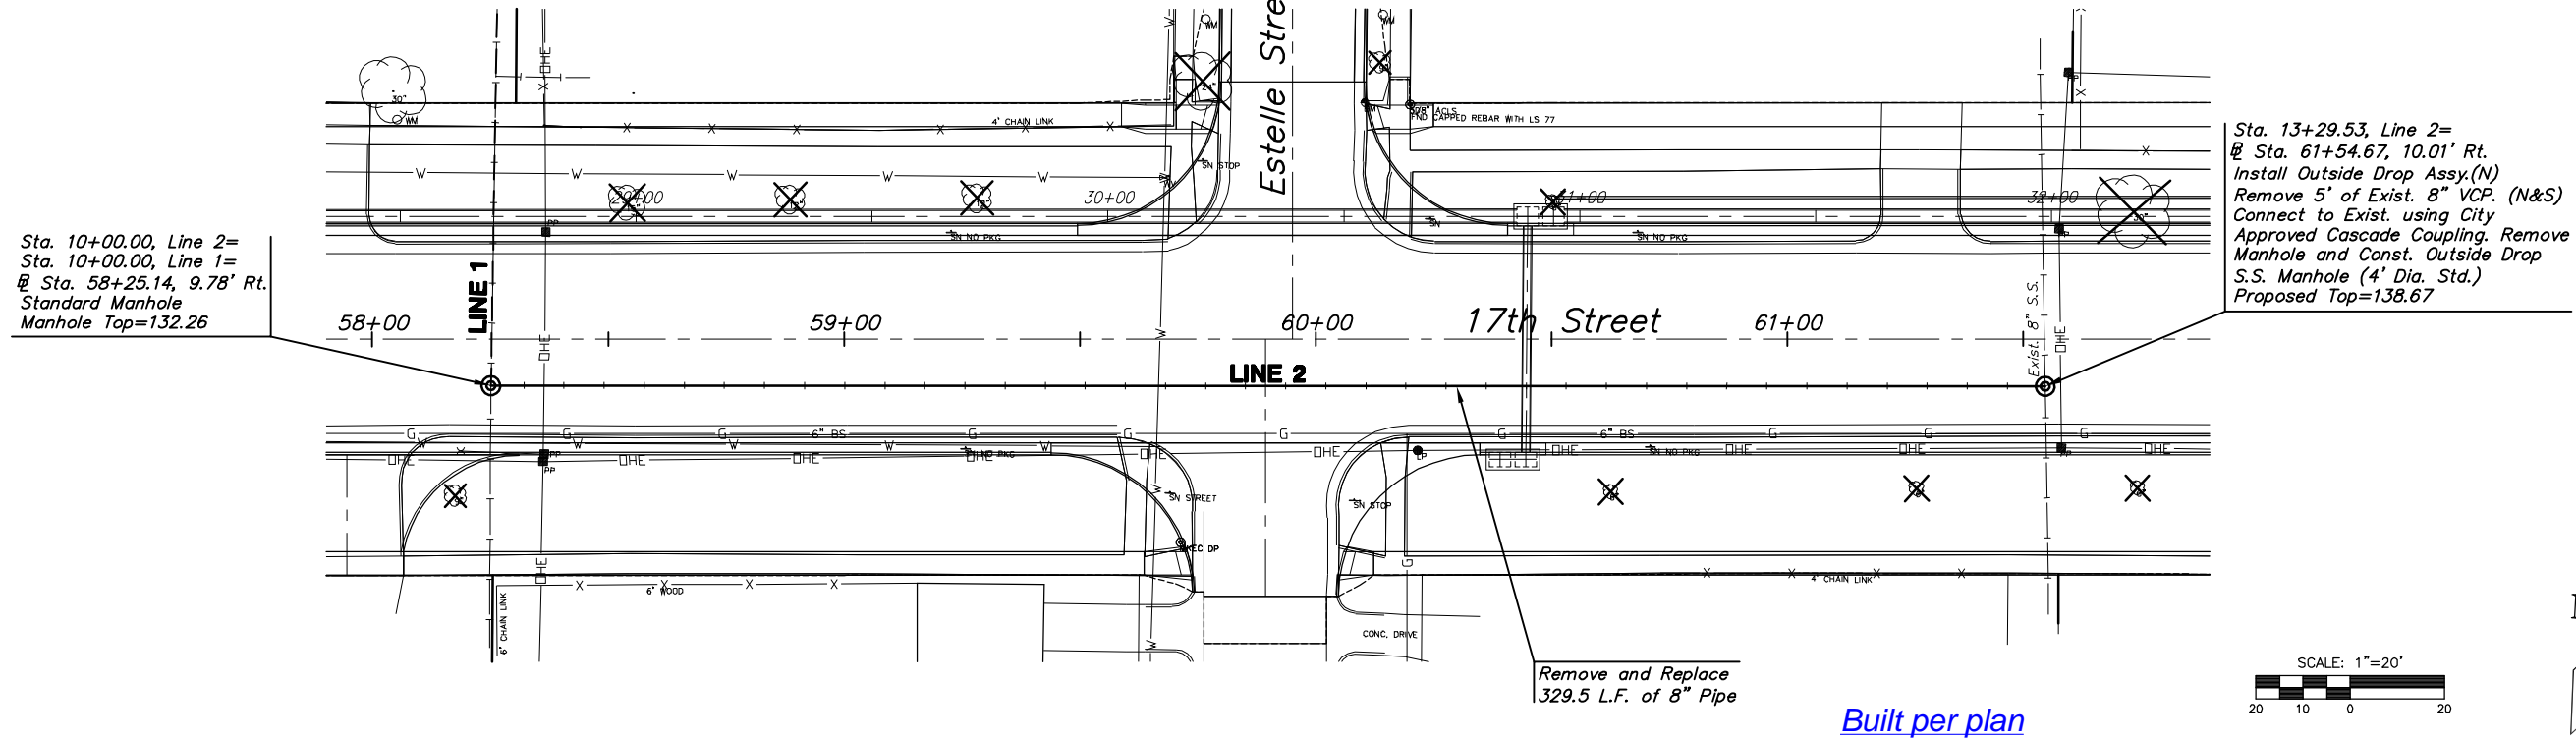


Sta. 13+29.53, Line 2=
@ Sta. 61+54.67, 10.01' Rt.
Install Outside Drop Assy.(N)
Remove 5' of Exist. 8" VCP. (N&S)
Connect to Exist. using City
Approved Cascade Coupling. Remove
Manhole and Const. Outside Drop
S.S. Manhole (4' Dia. Std.)
Proposed Top=138.67

Sta. 10+00.00, Line 2=
Sta. 10+00.00, Line 1=
@ Sta. 58+25.14, 9.78' Rt.
Standard Manhole
Manhole Top=132.26

PLAN LINE 2

PROFILE LINE 2

SCALE: HORIZ. 1"=20'
SCALE: VERT. 1"=5'

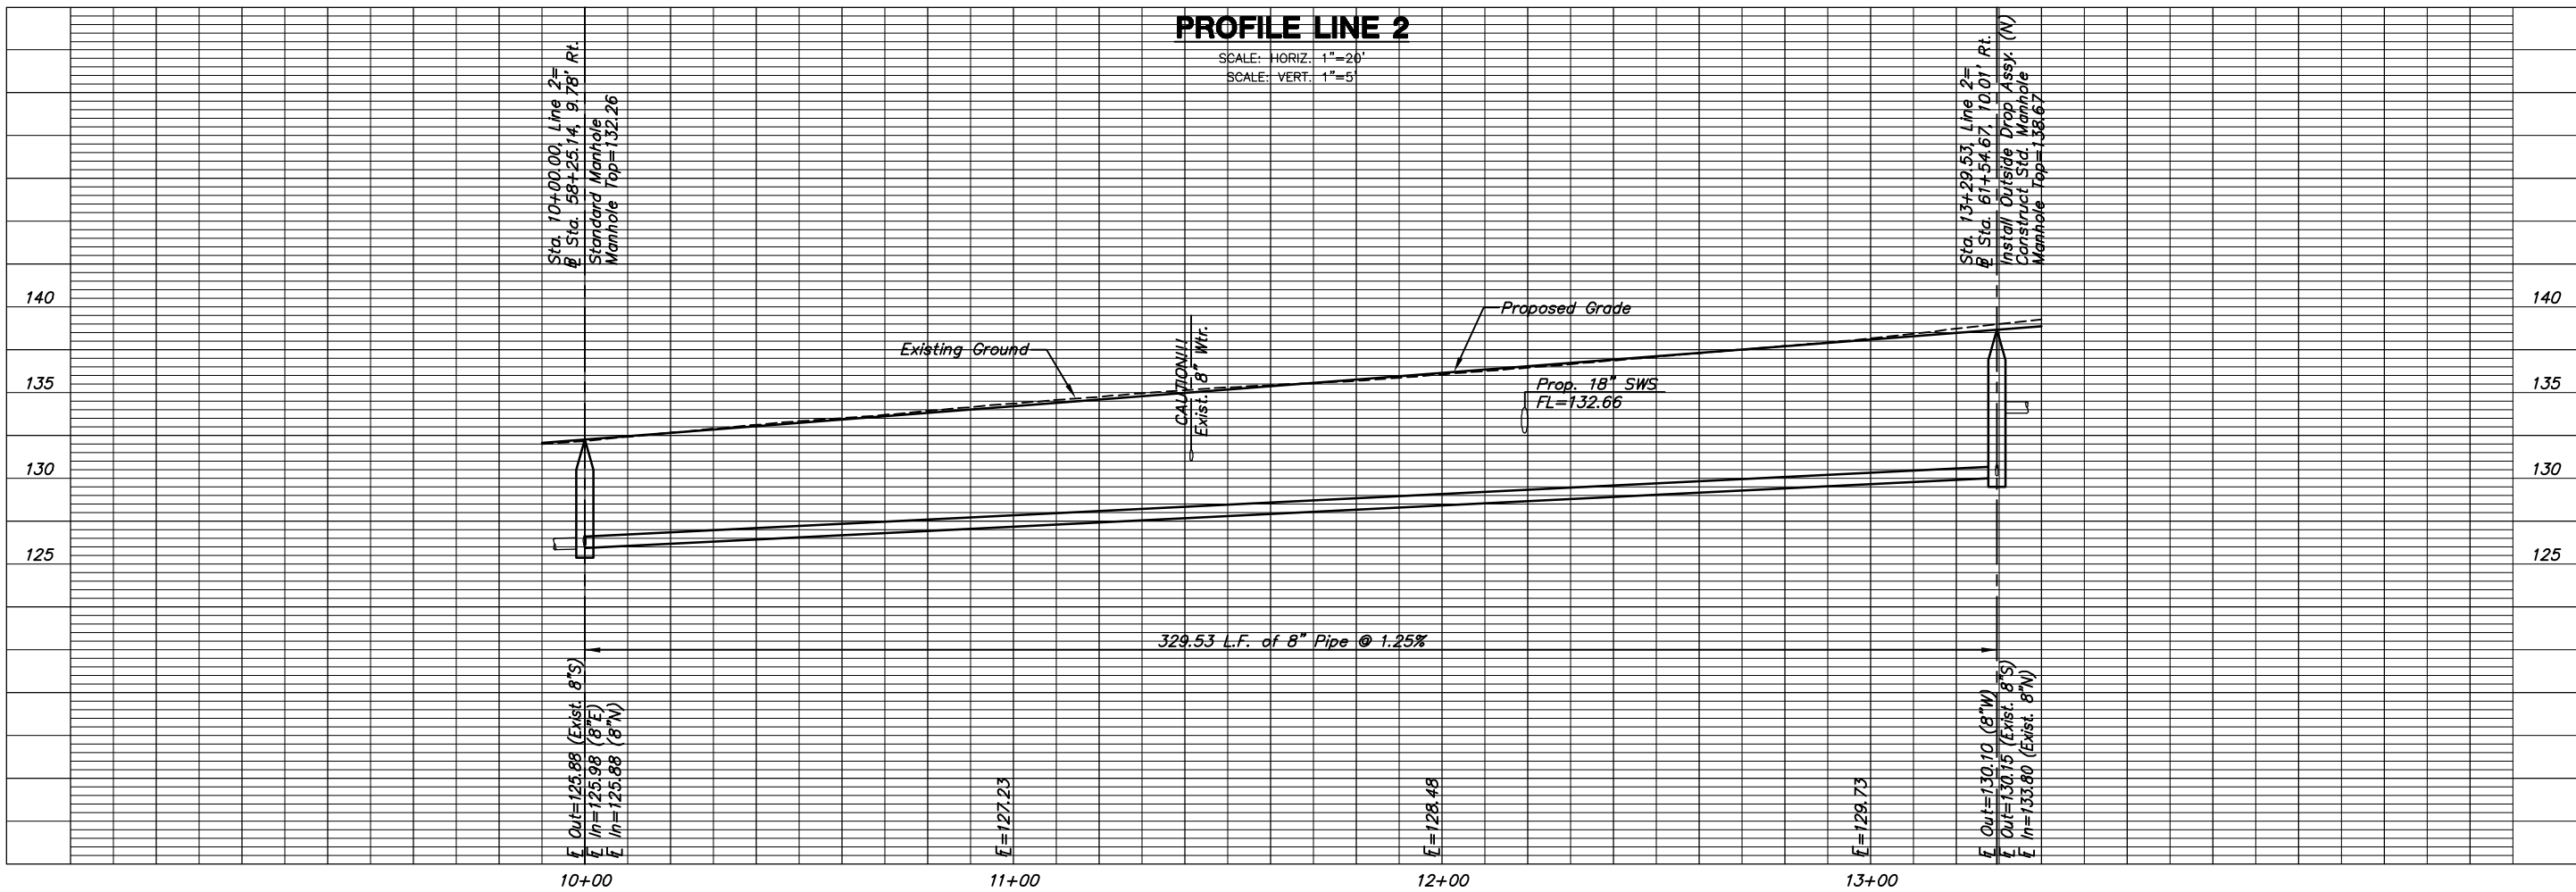

**17th STREET
FROM GROVE TO HILLSIDE**

**Sanitary Sewer
Line 2**

SHEET TITLE
87 N-0349-01
PROJECT NUMBER

DESIGN BY JRA
DRAWN BY JWC
CHECKED BY JRA

ISSUED
May 28, 2009
REVISED

SHEET NO.
65 of 133