
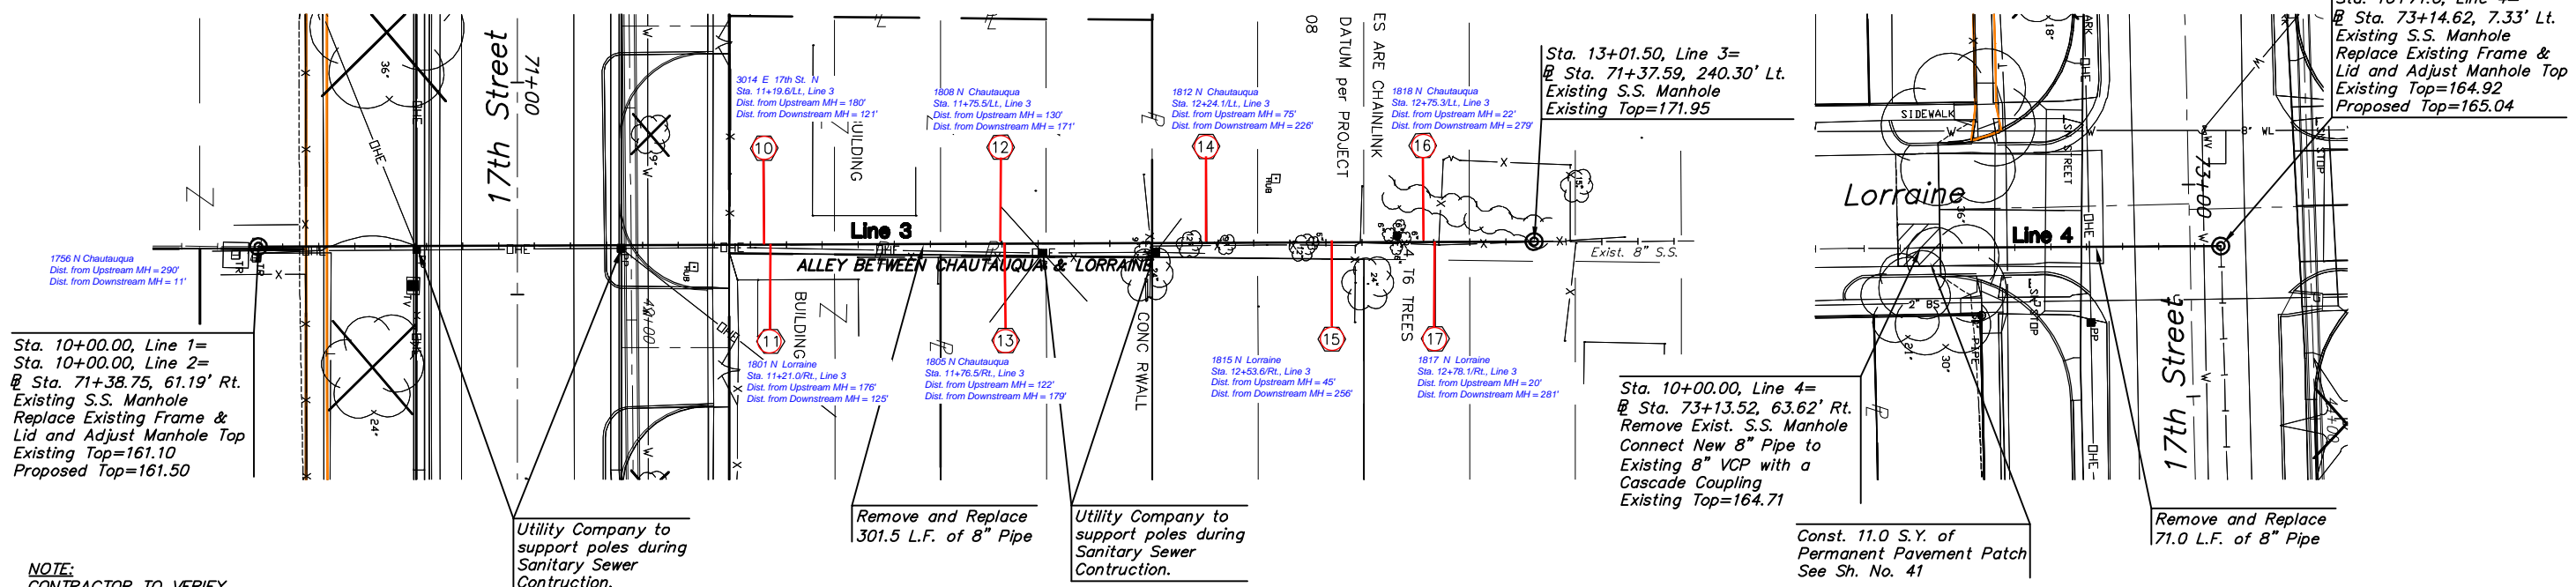
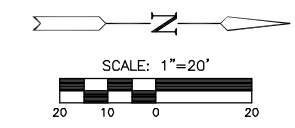


STATE	PROJECT NO.	YEAR	SHEET NO.	SHEETS
KANSAS	87 N-0349-01	2009	66	133


**MKEC**  
ENGINEERING  
CONSULTANTS, INC.  
411 N. WEBB ROAD  
WICHITA, KS. 67206  
316 - 684 - 9600

④ Service location. See Sht. 55 for Station and direction.

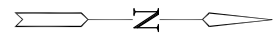

**PLAN LINE 3**

**PLAN LINE 4**

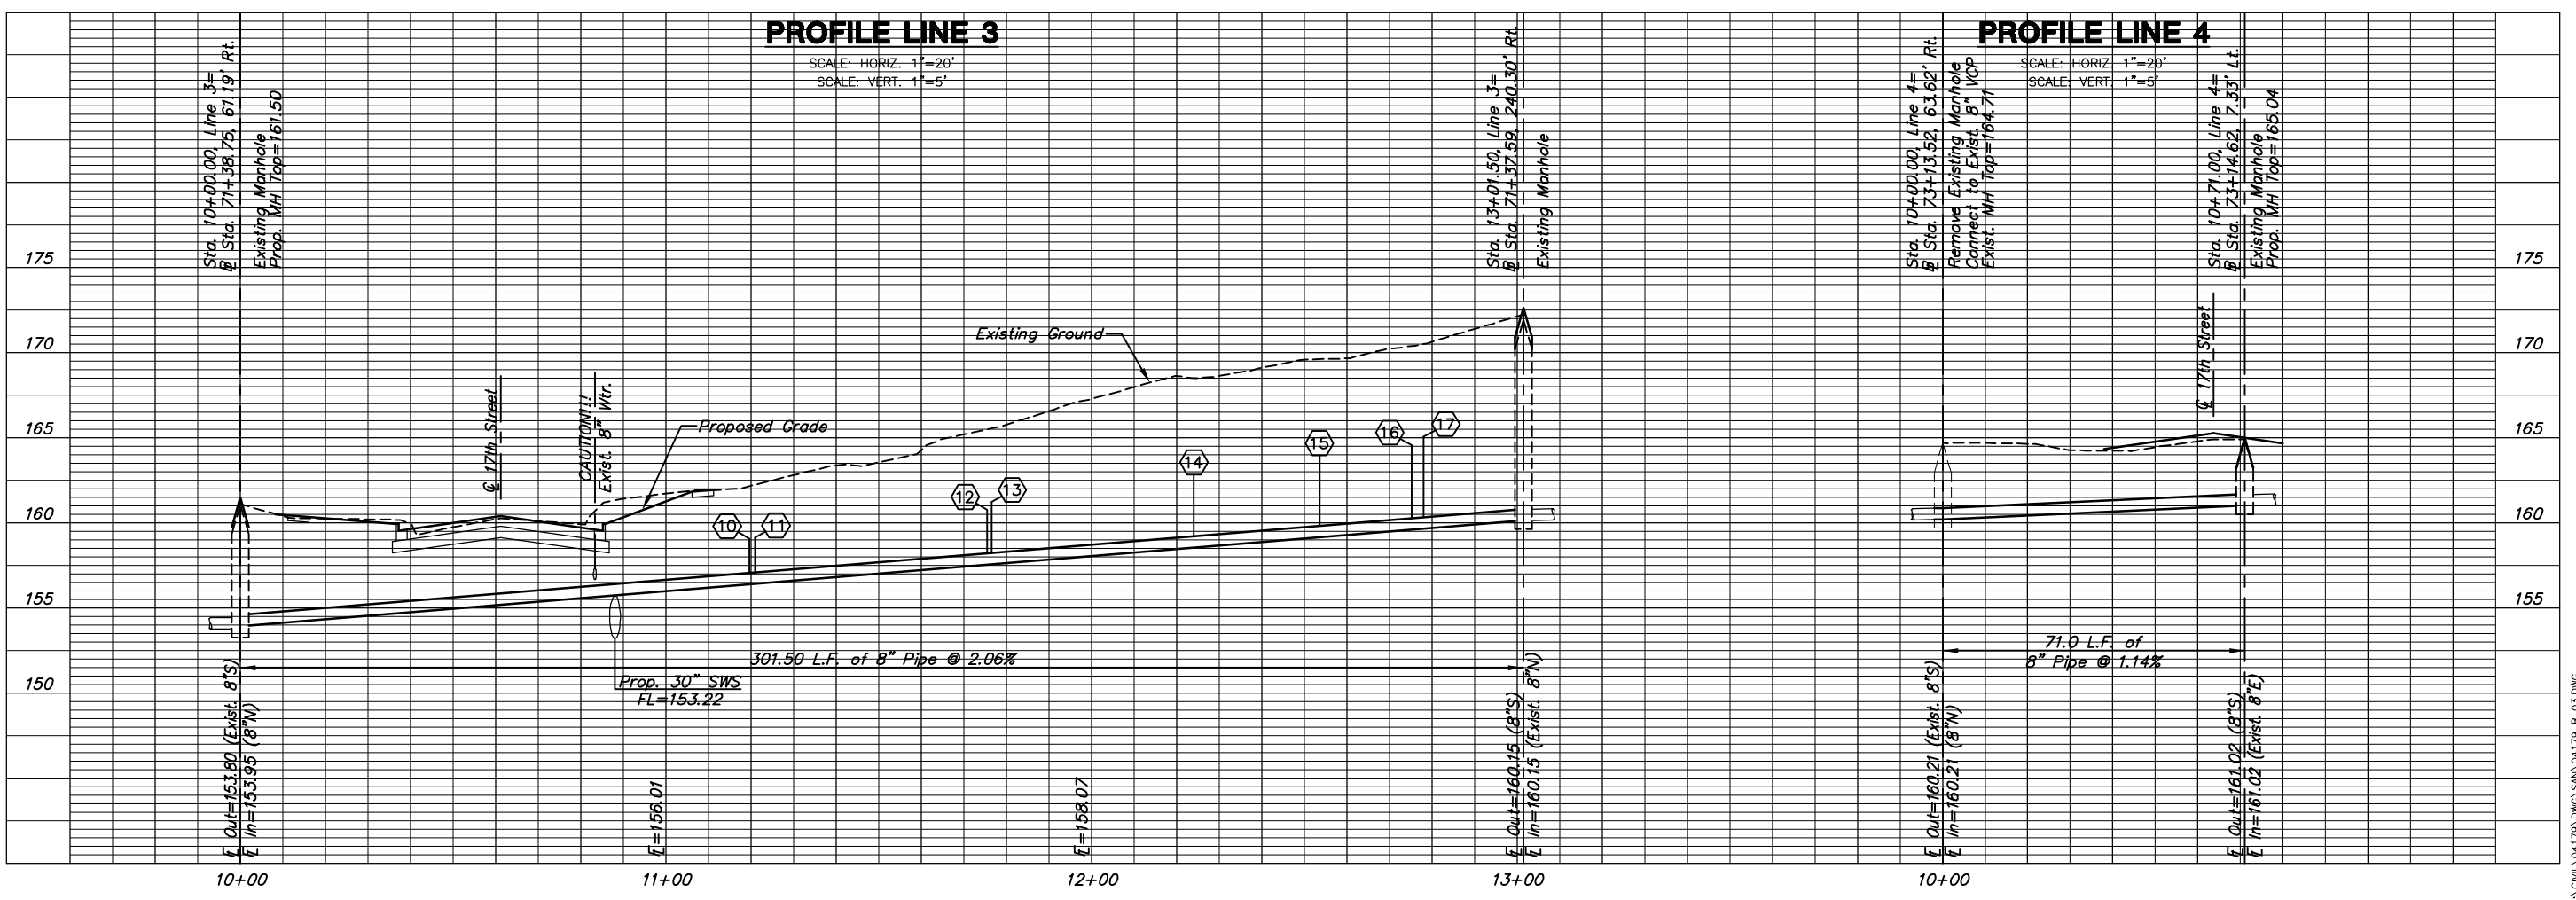

**PROFILE LINE 3**

**PROFILE LINE 4**

**17th STREET  
FROM GROVE TO HILLSIDE**

**Sanitary Sewer  
Lines 3 and 4**  
SHEET TITLE  
87 N-0349-01  
PROJECT NUMBER

DESIGN BY JRA  
DRAWN BY JWC  
CHECKED BY JRA

ISSUED  
May 28, 2009  
REVISED

SHEET NO.  
**66 of 133**

PLOTFILE: Thursday, May 28, 2009 10:22:39AM

J:\CIVIL\04179 DWG\SAW\04179 B 03.DWG