
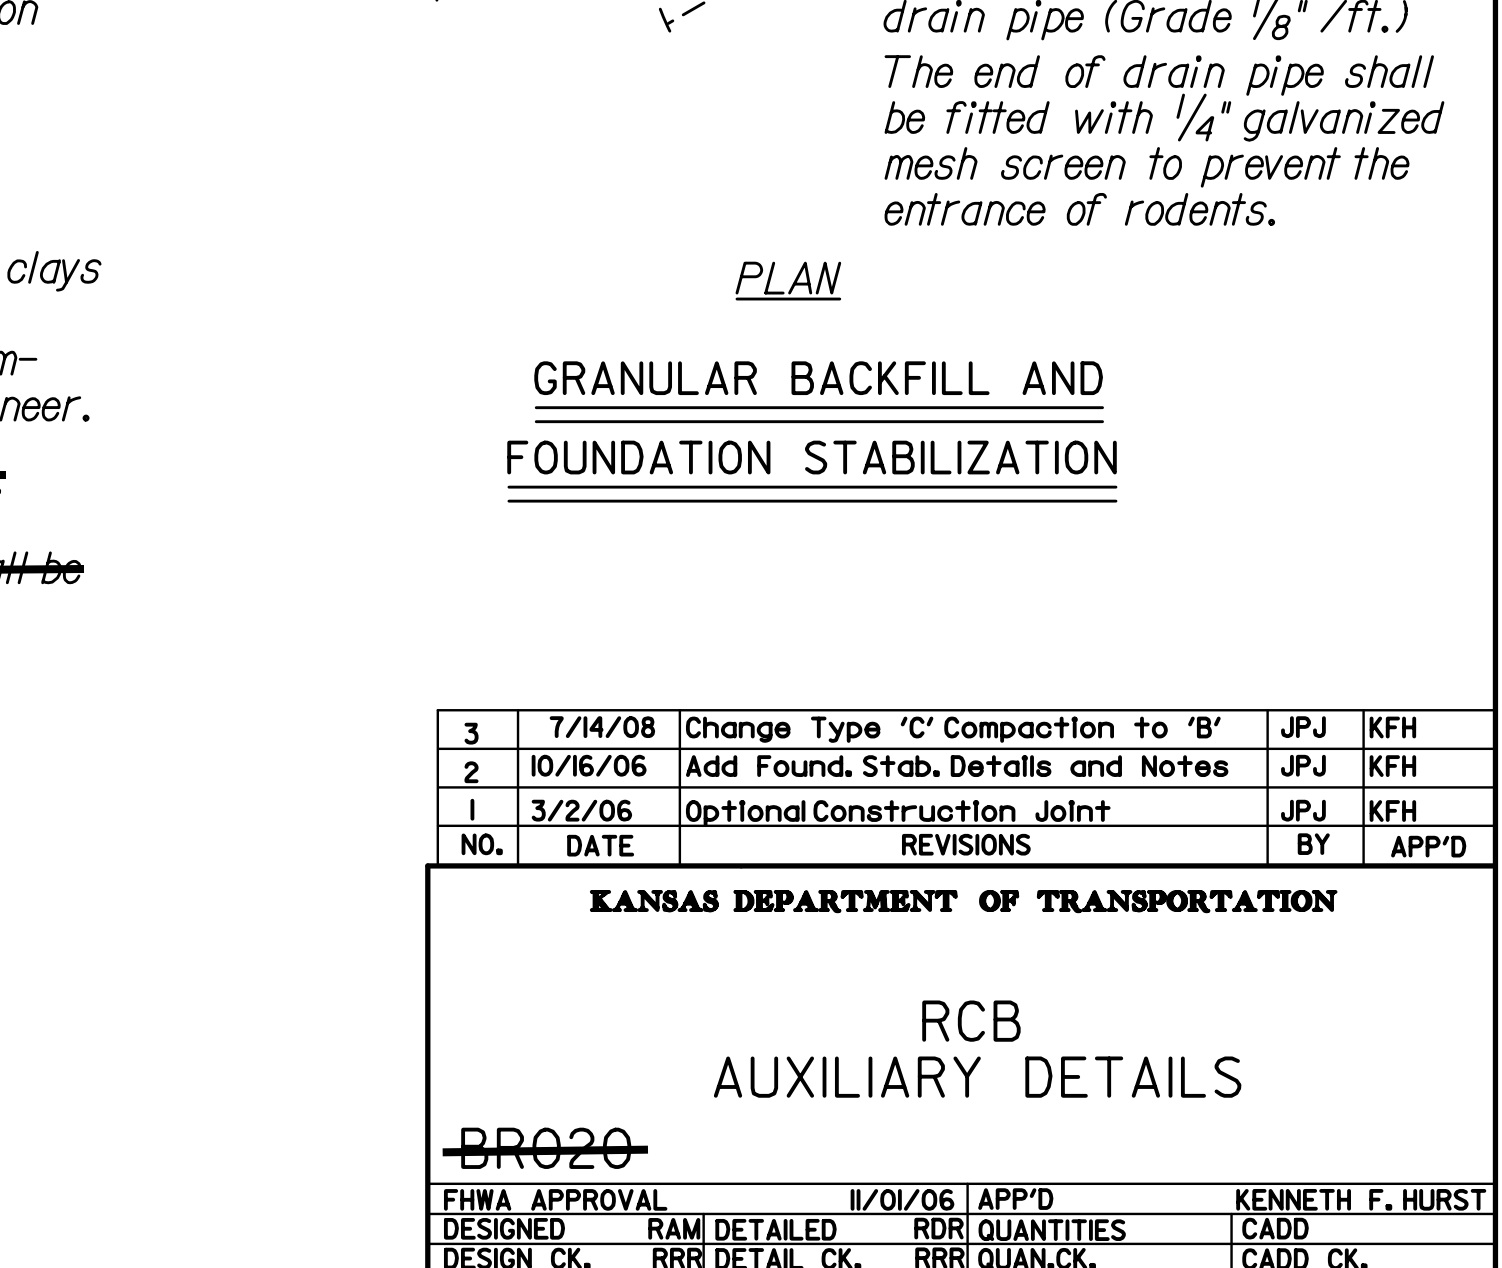
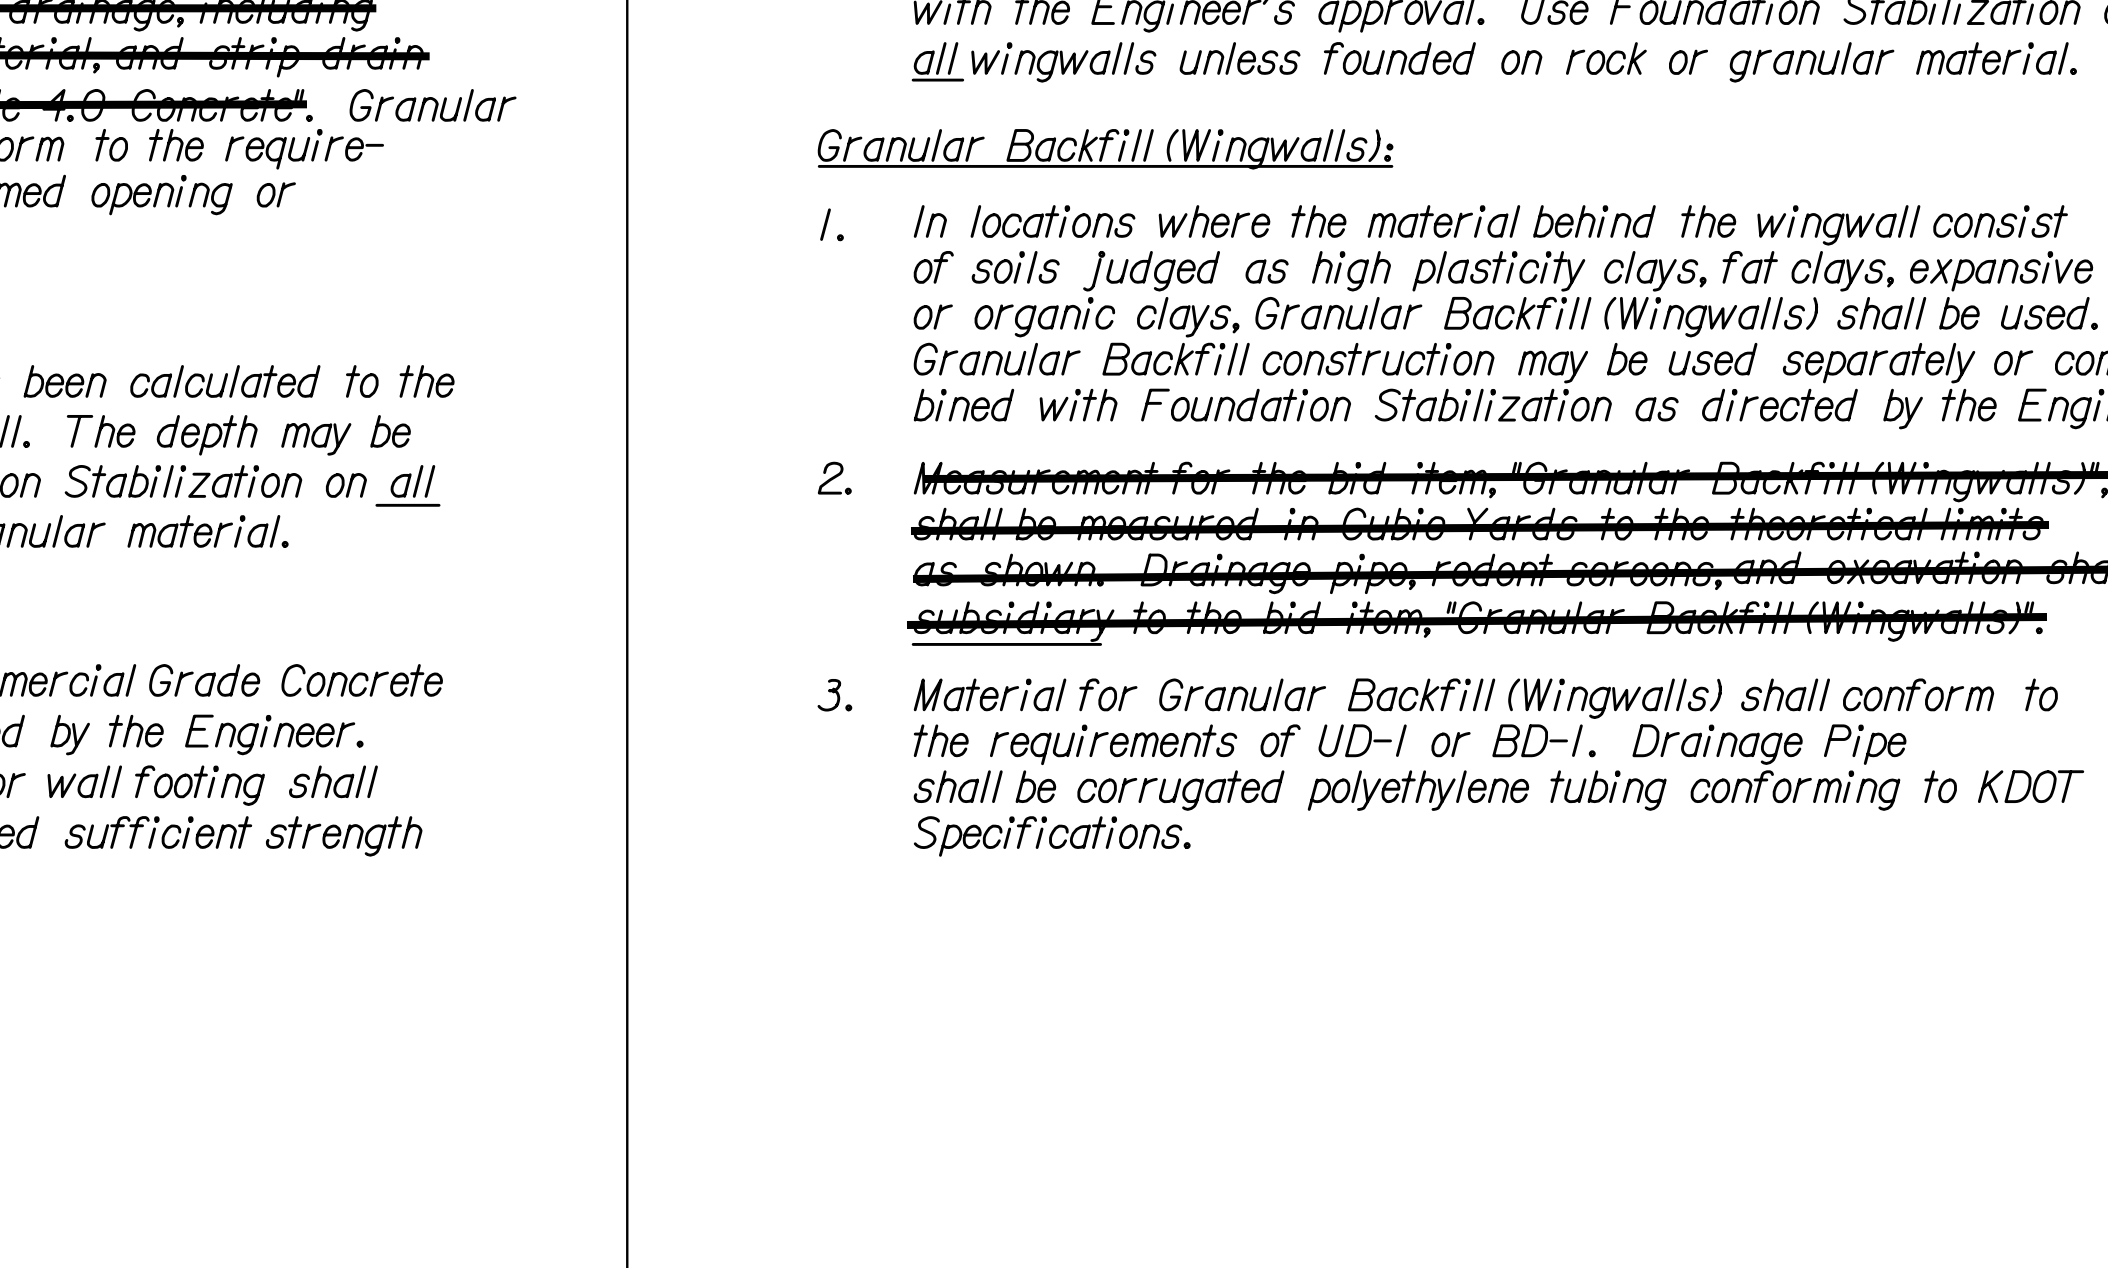
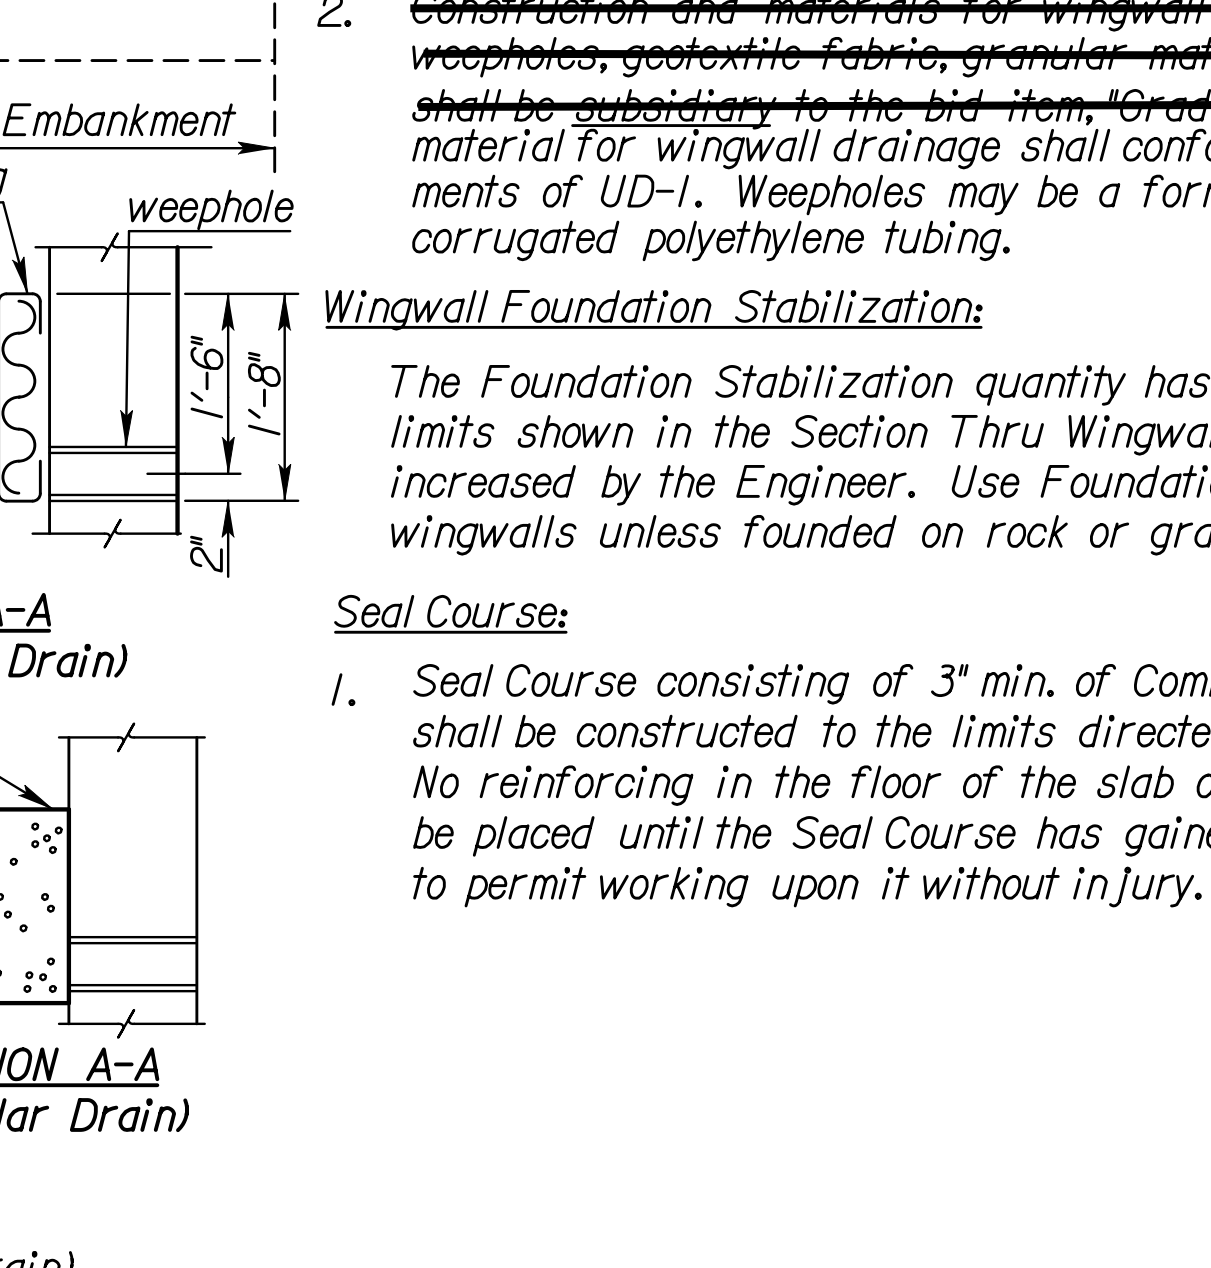
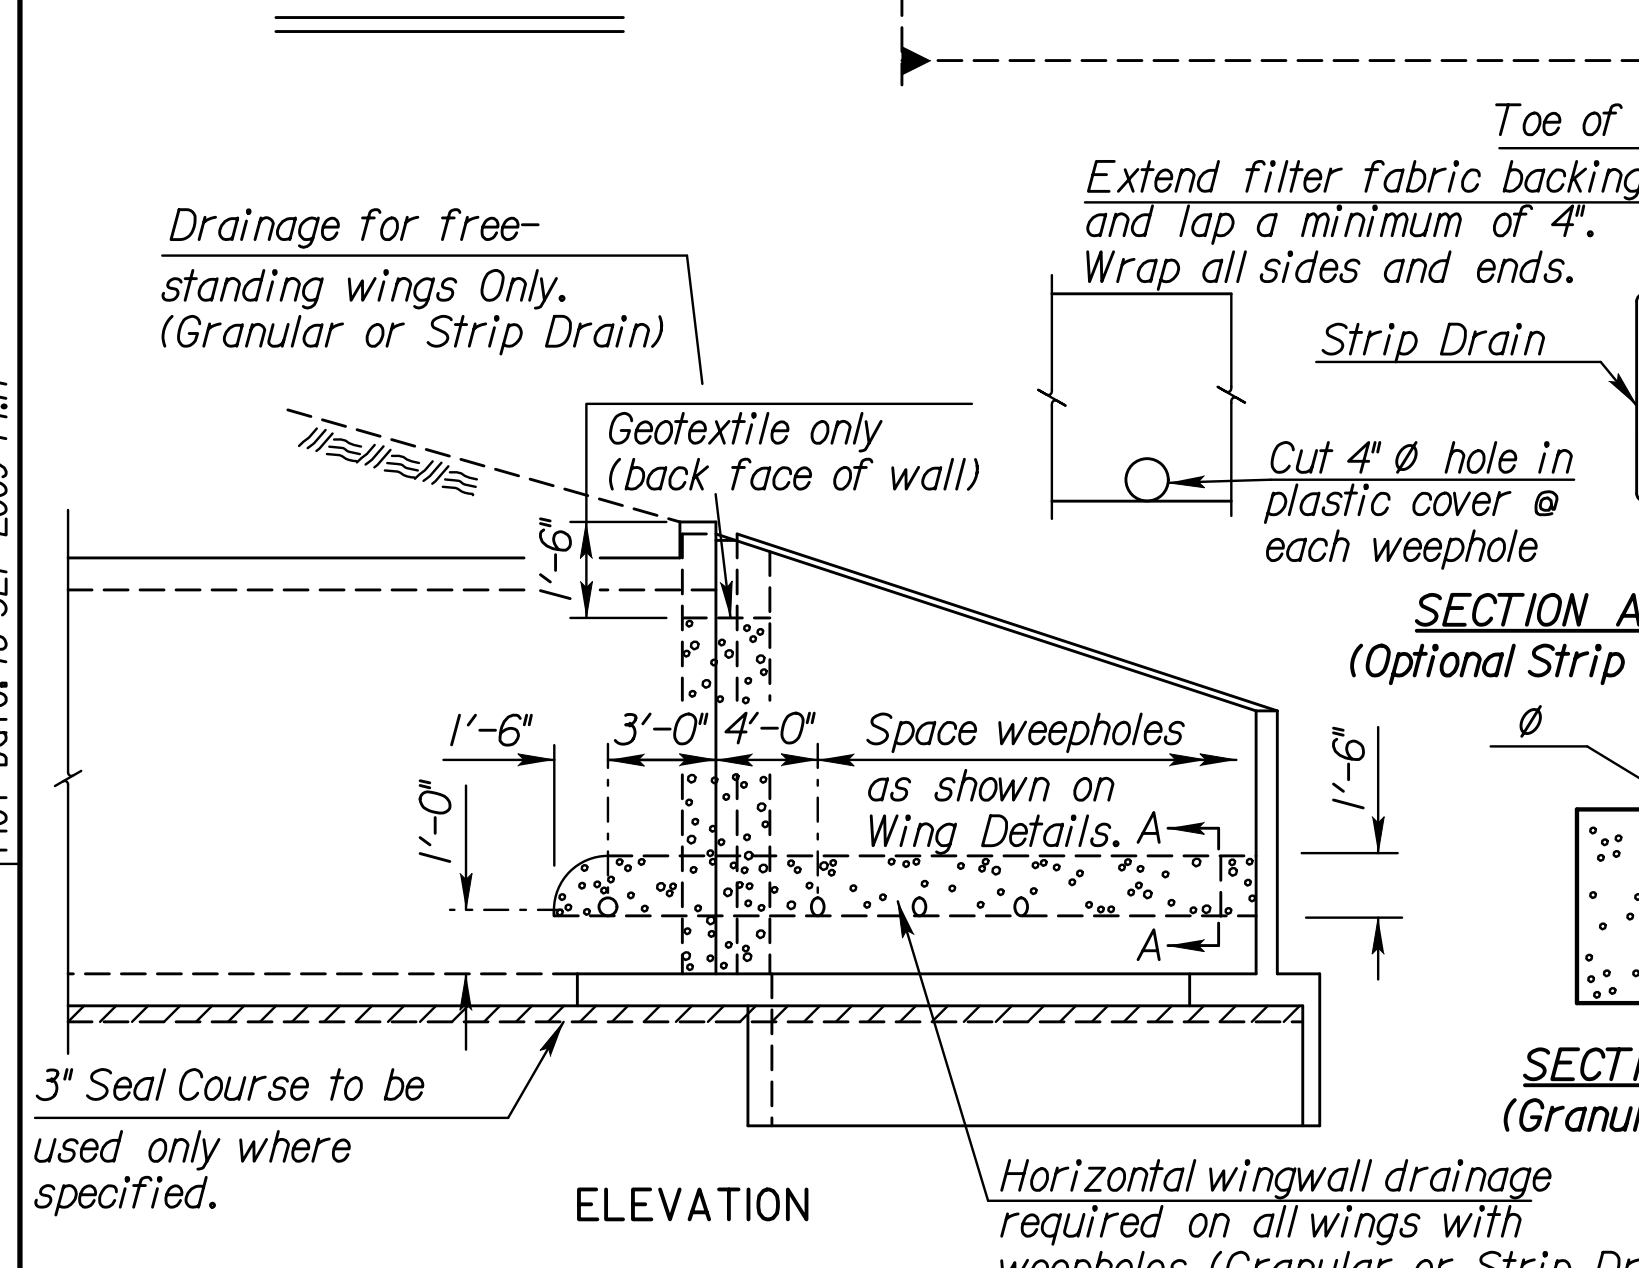
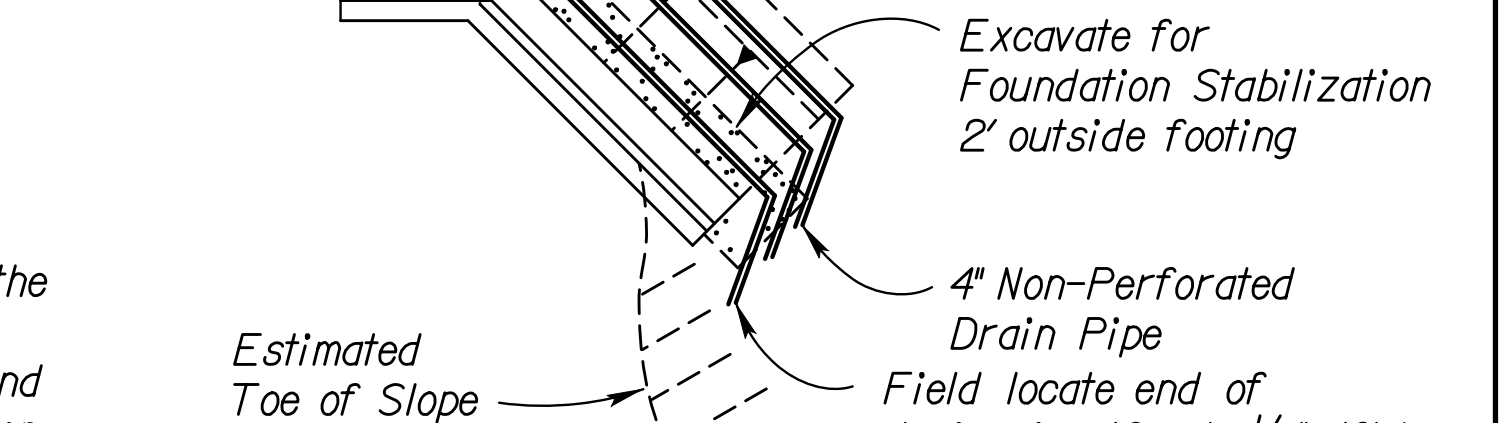
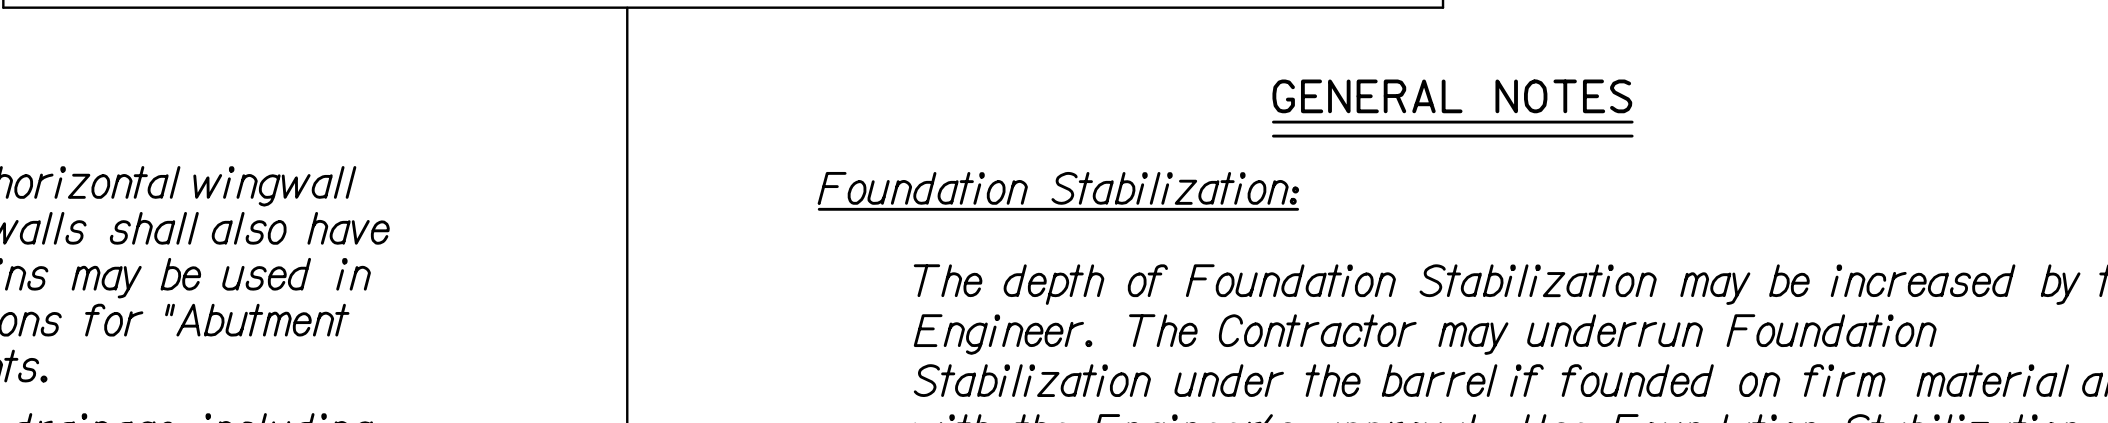
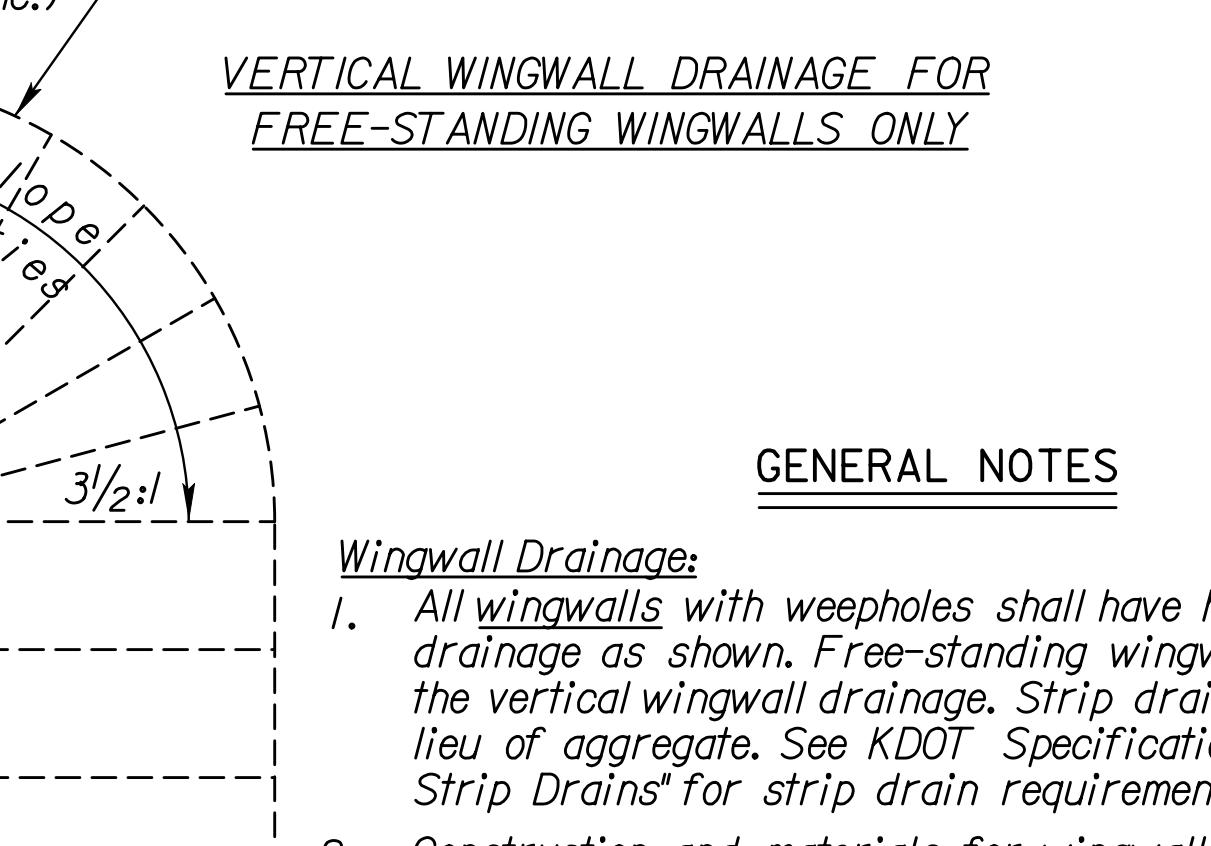
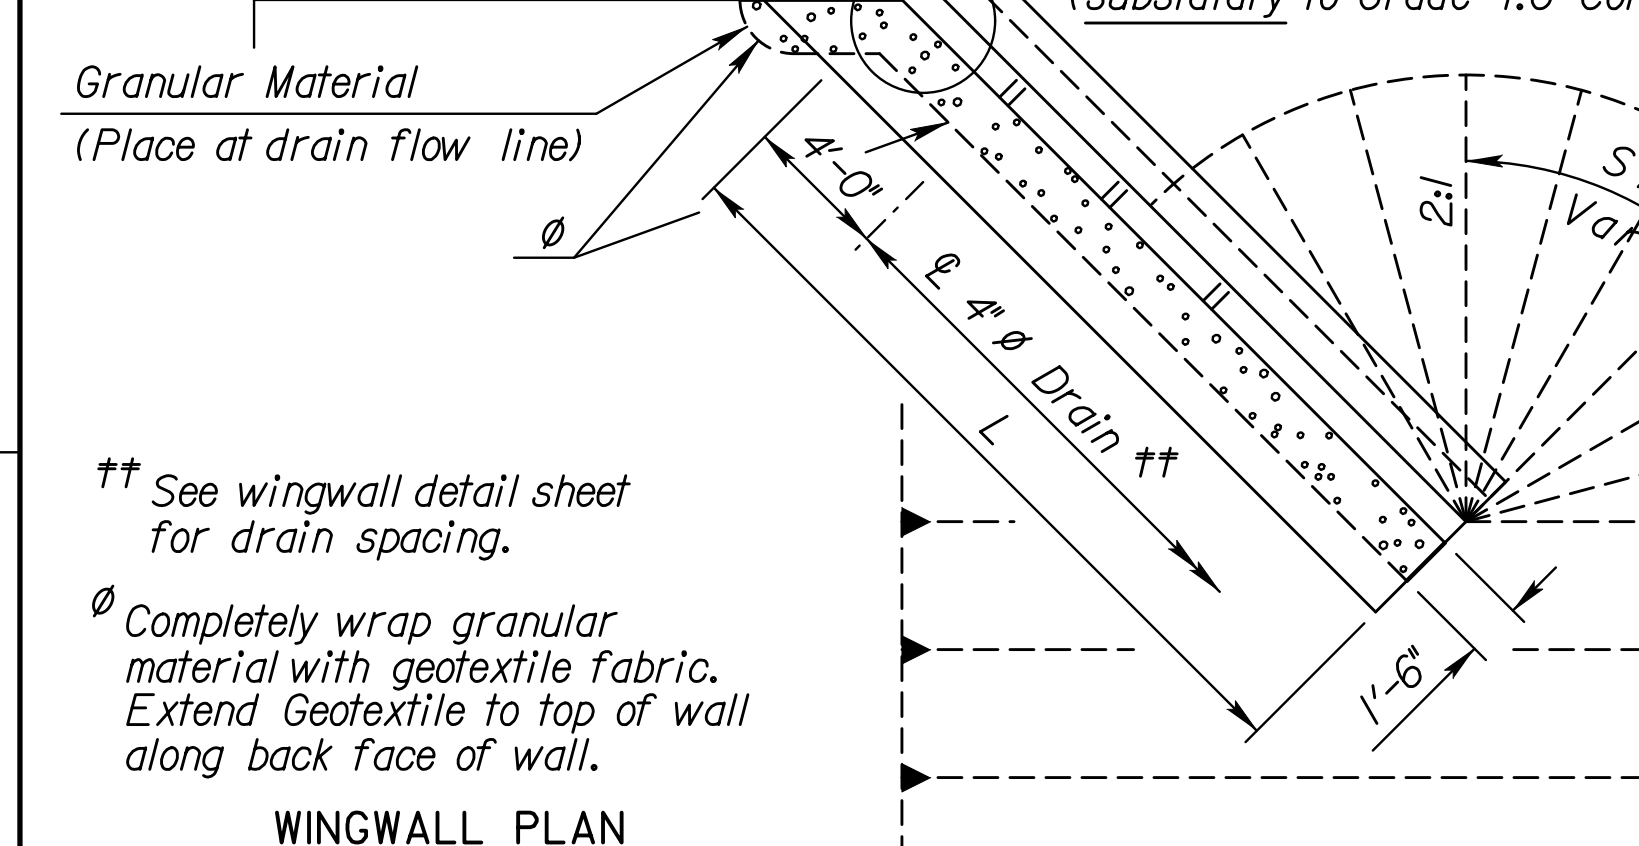
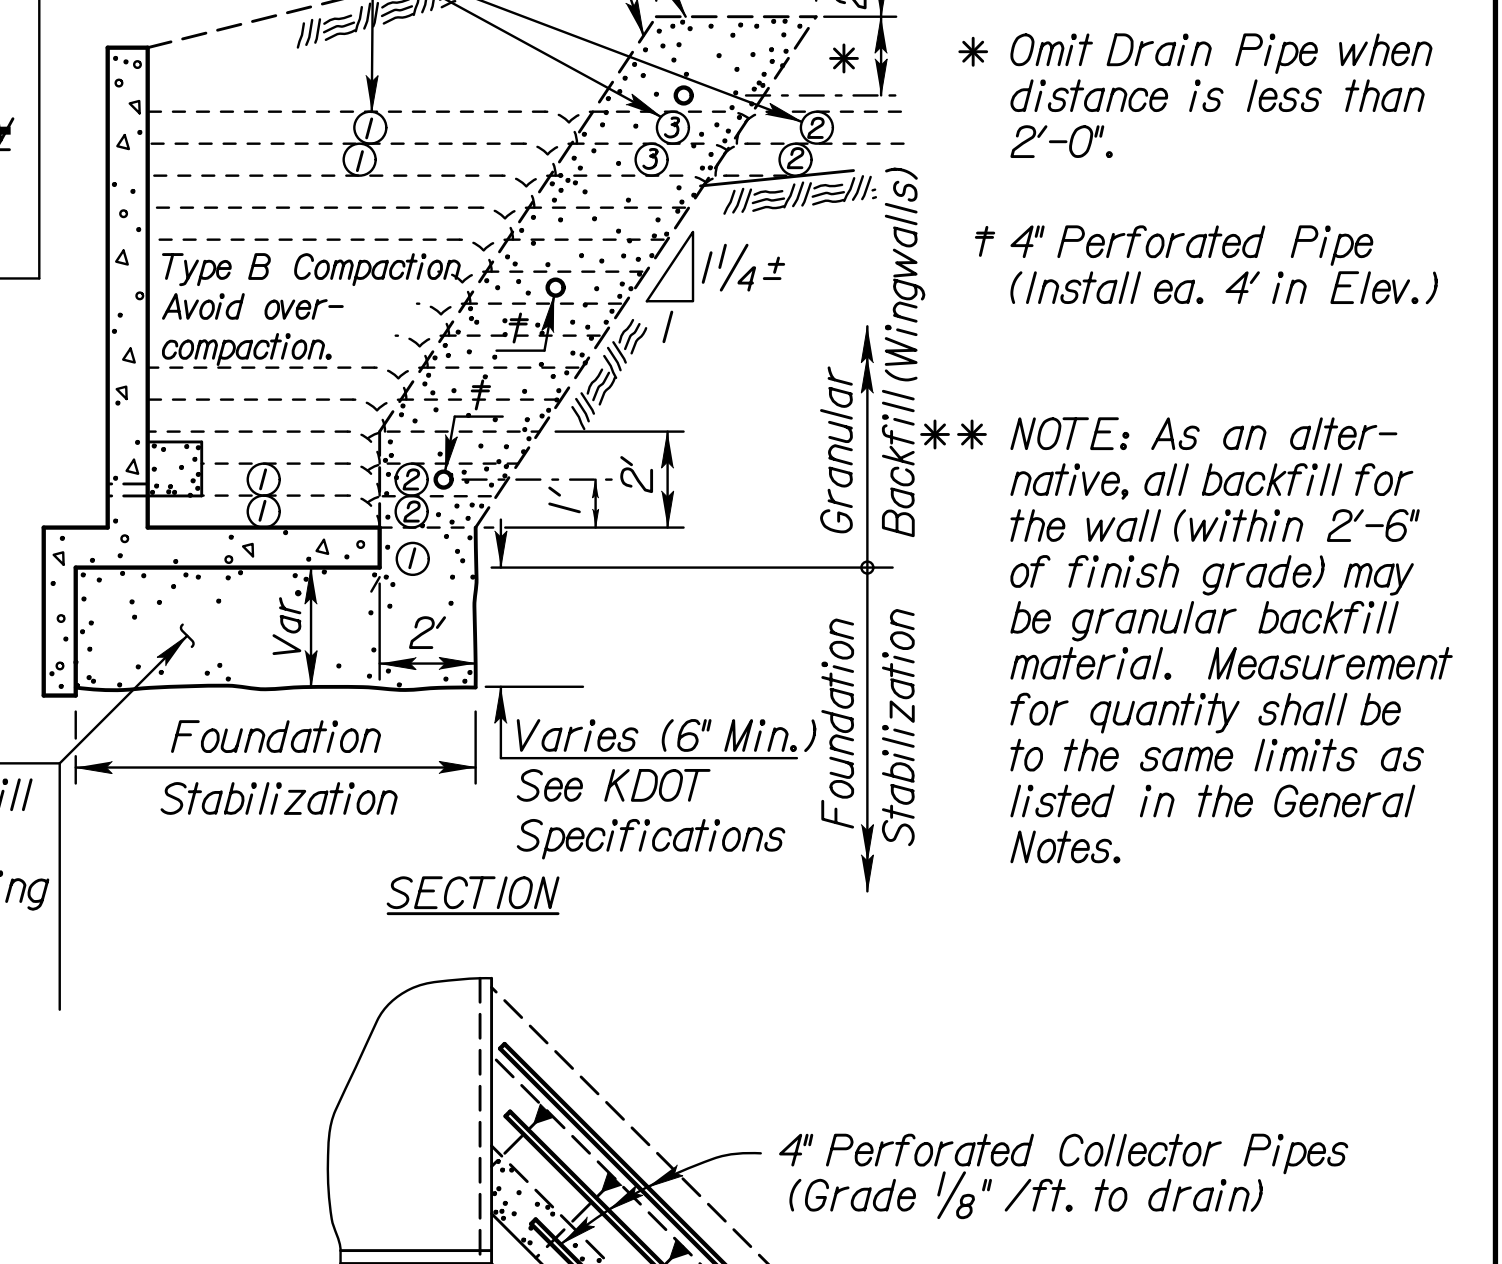
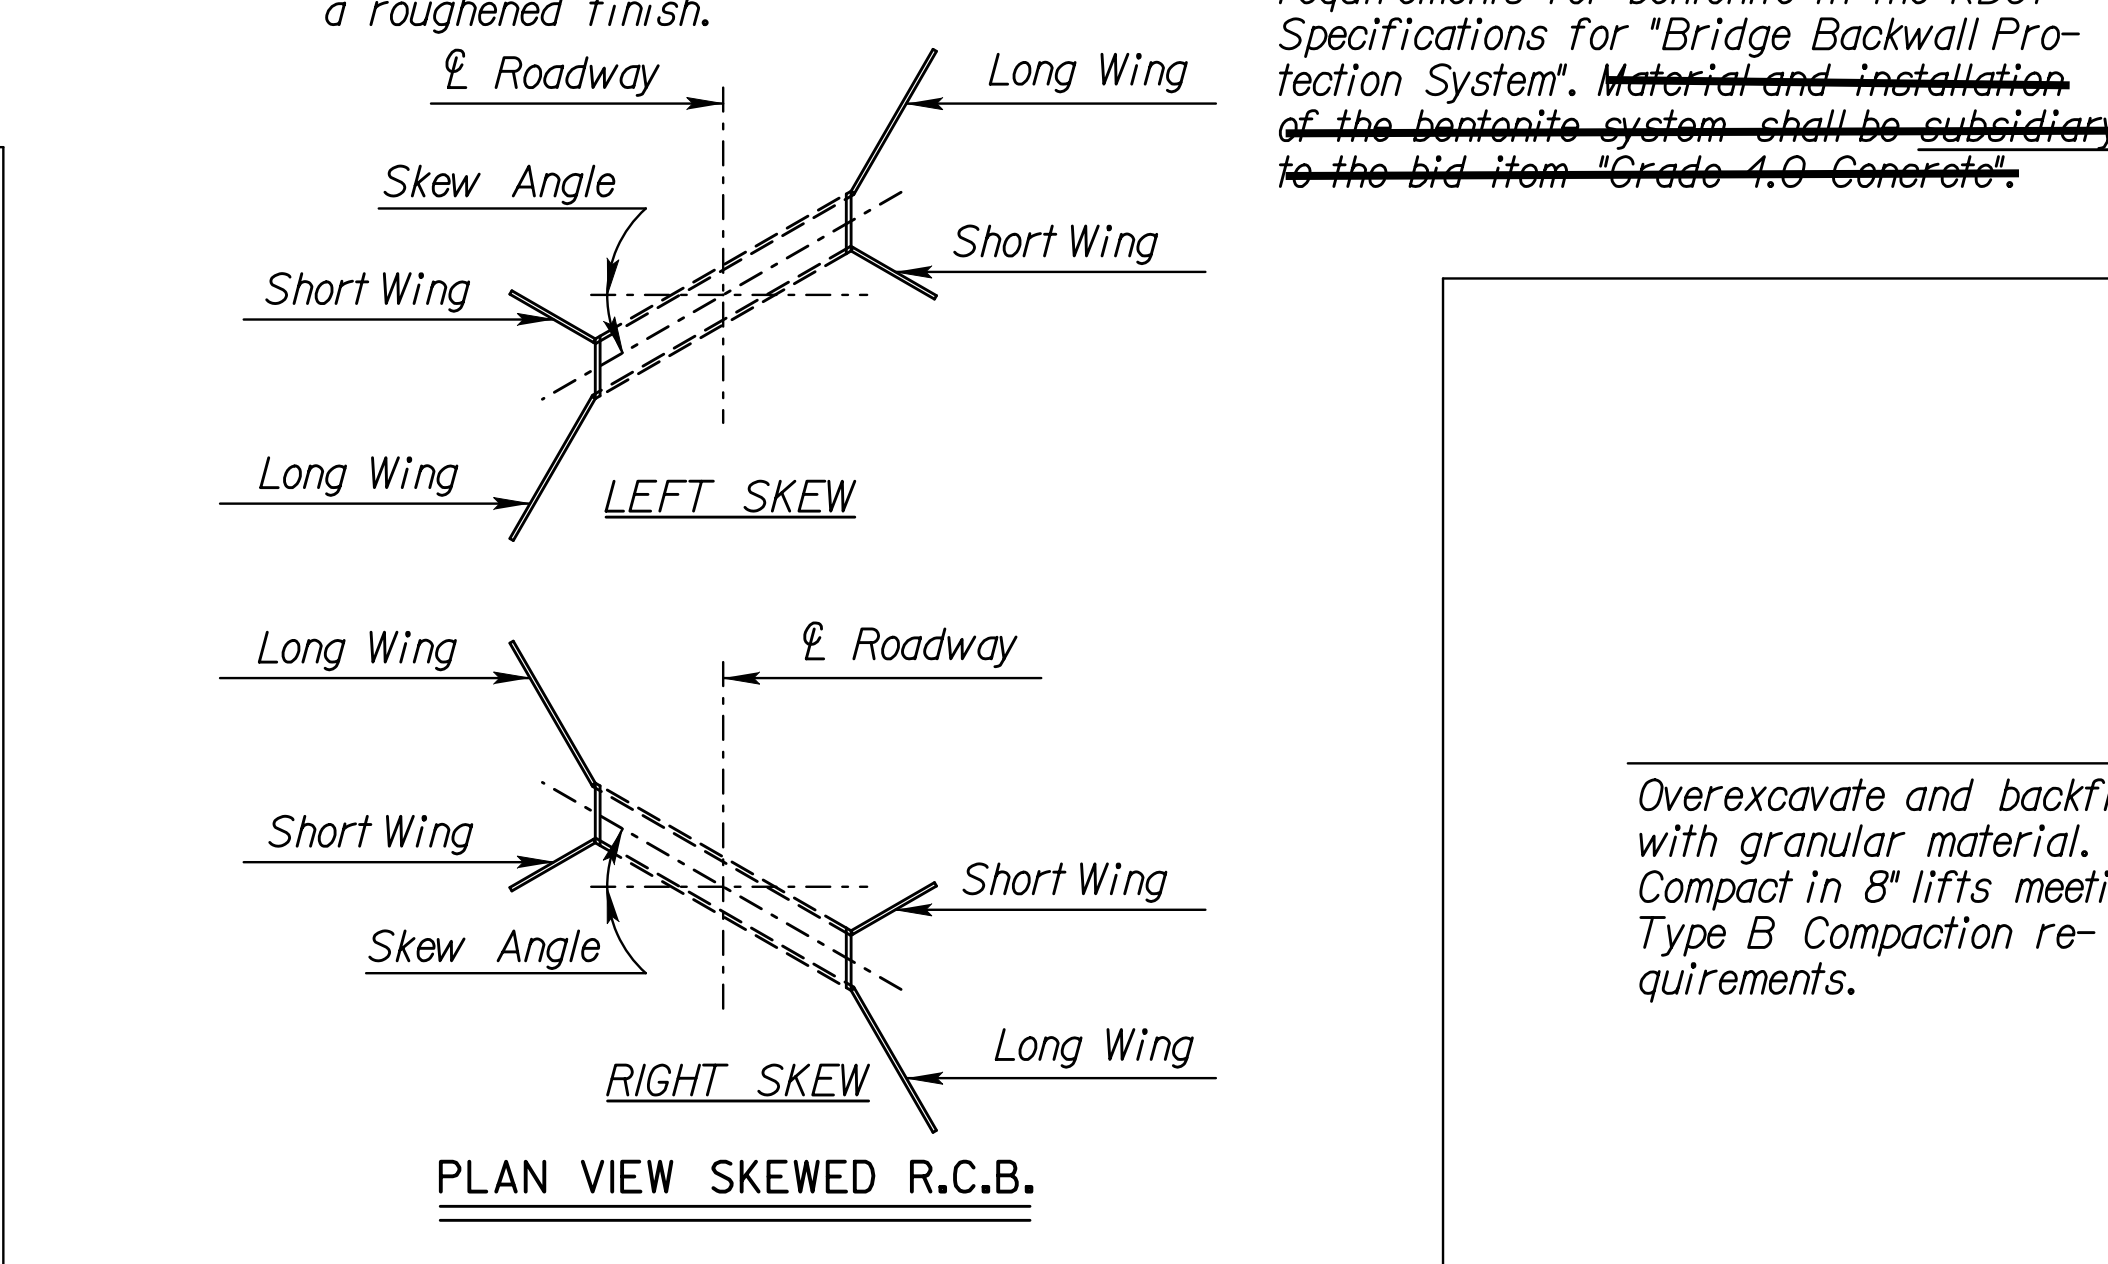
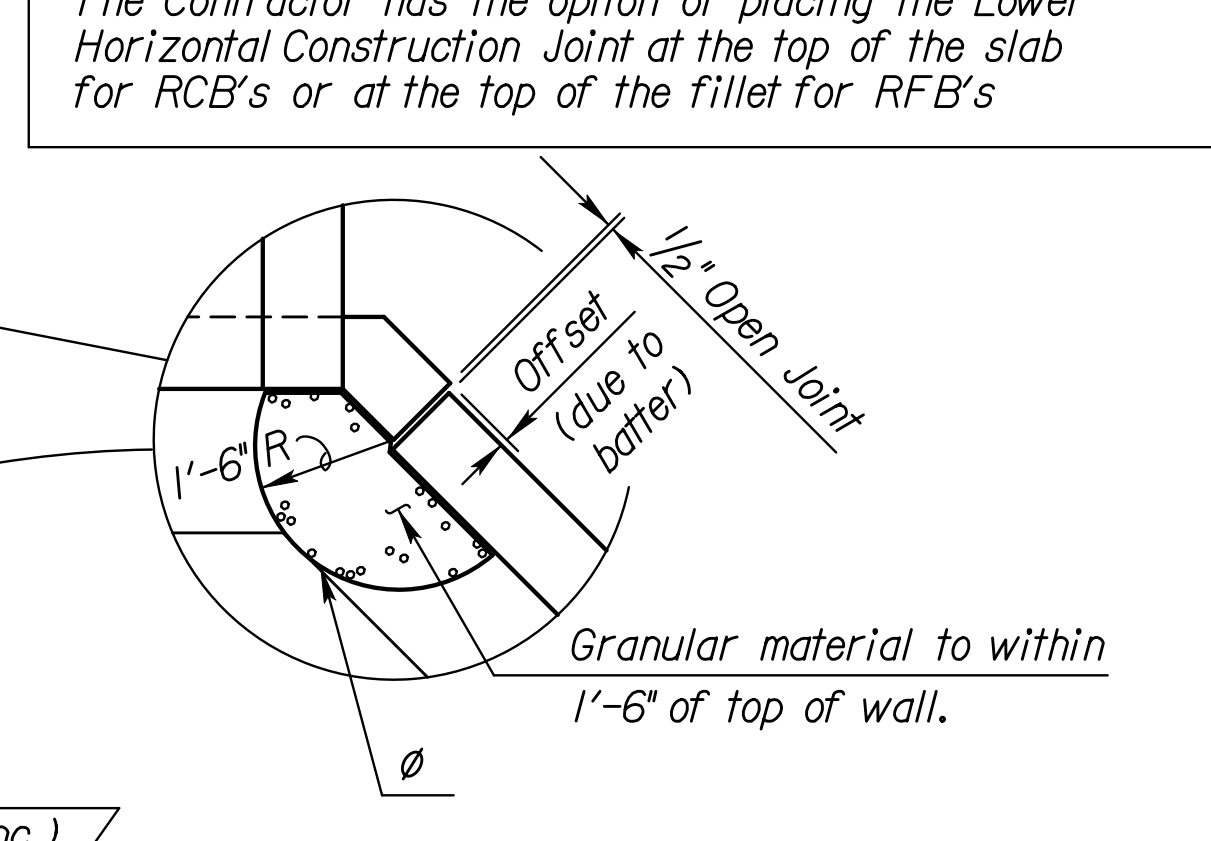
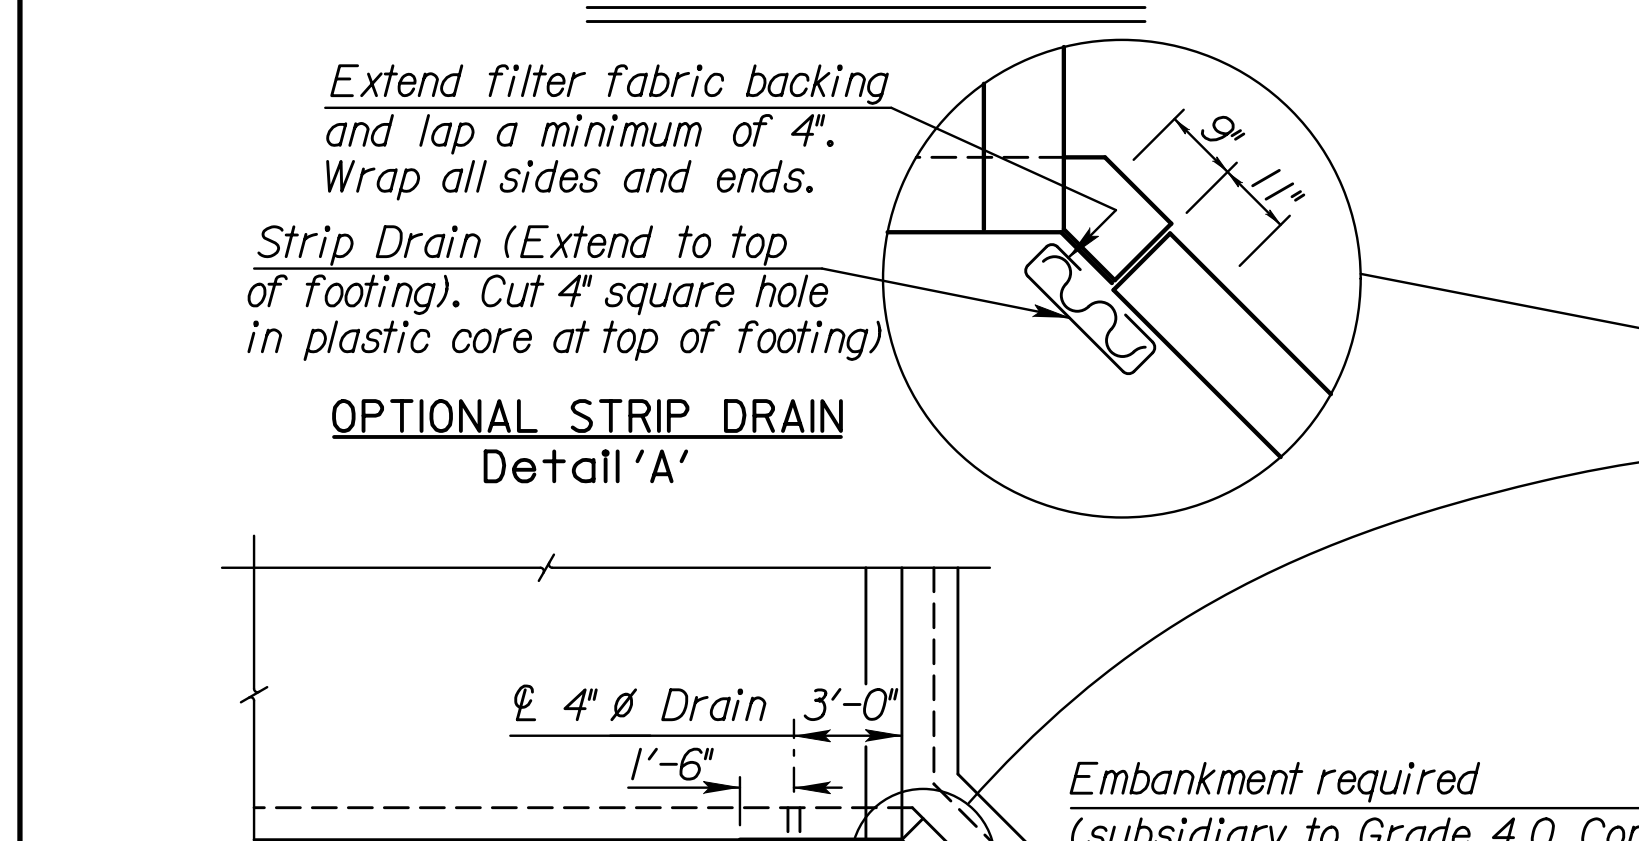
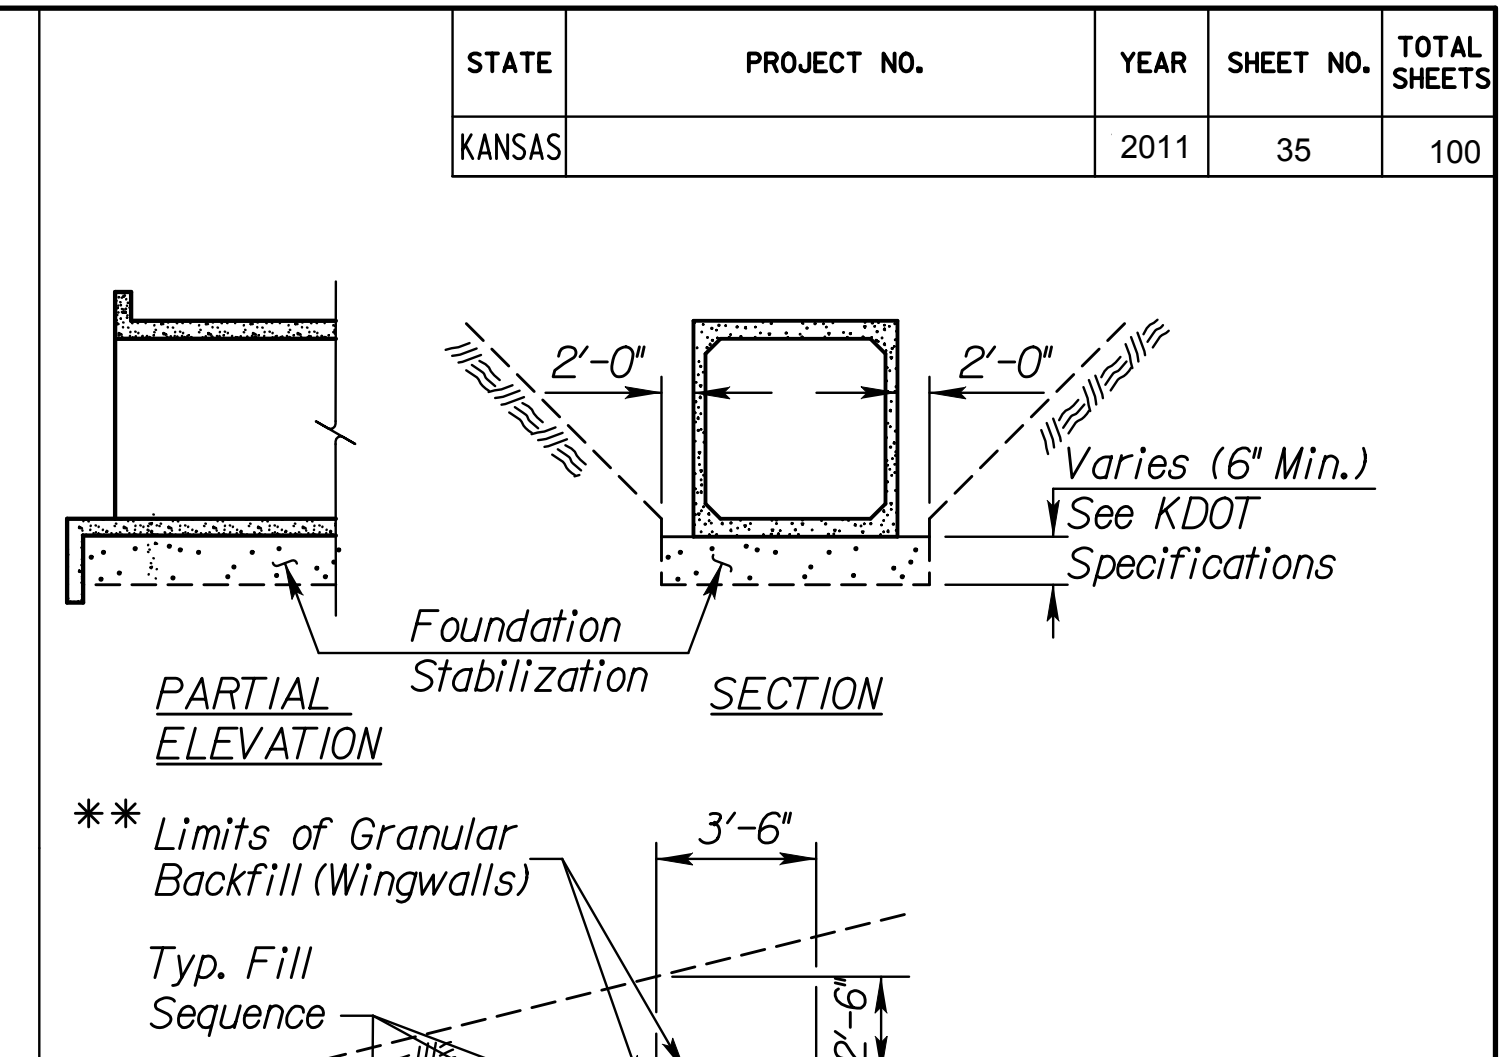
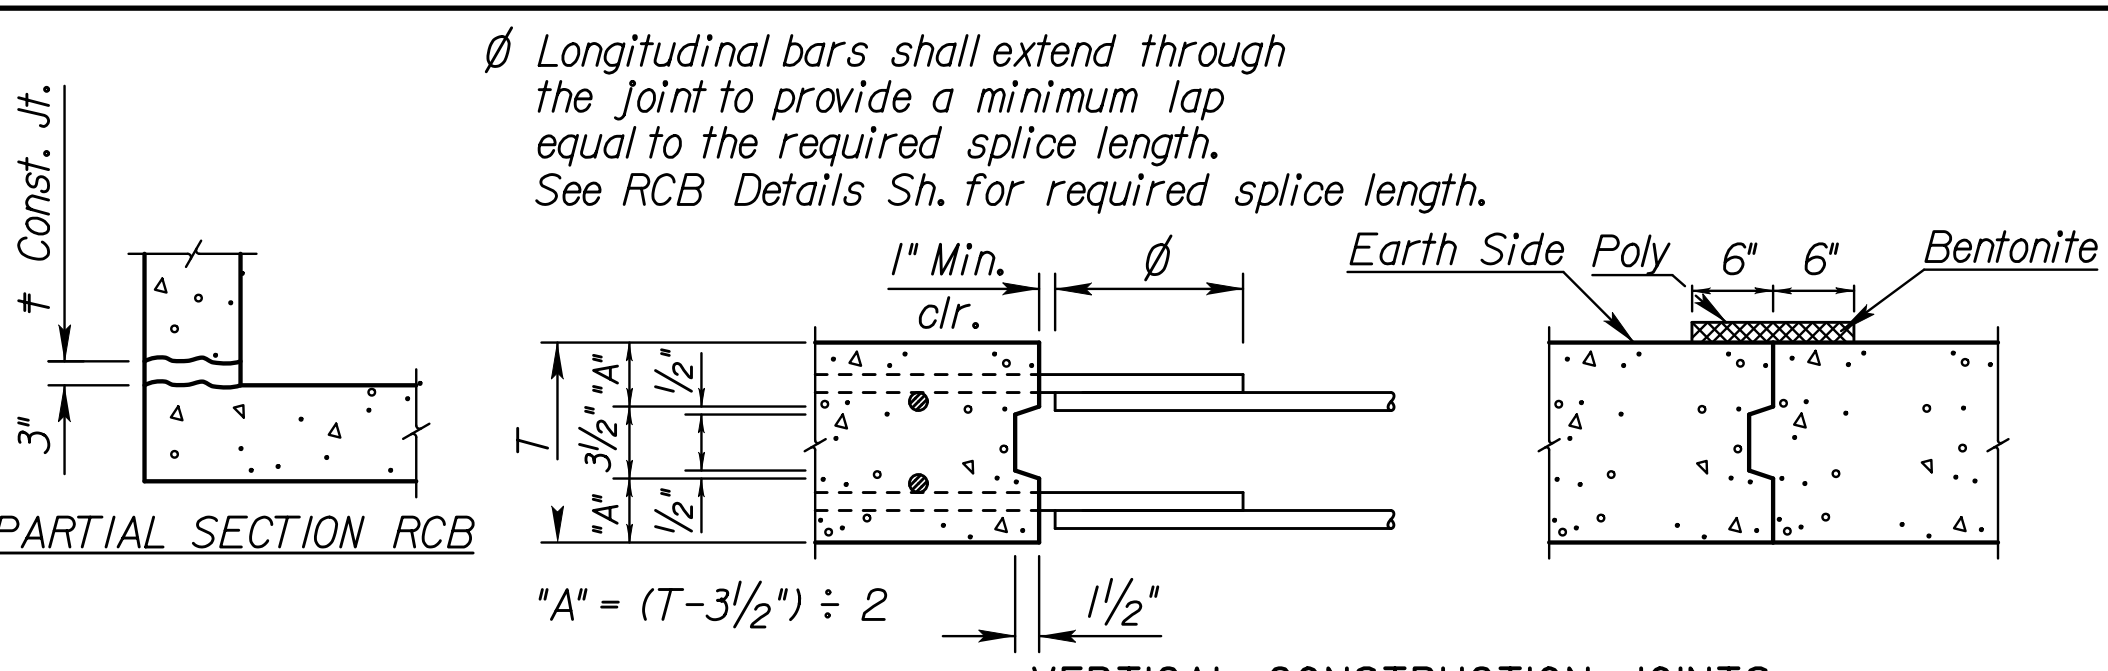
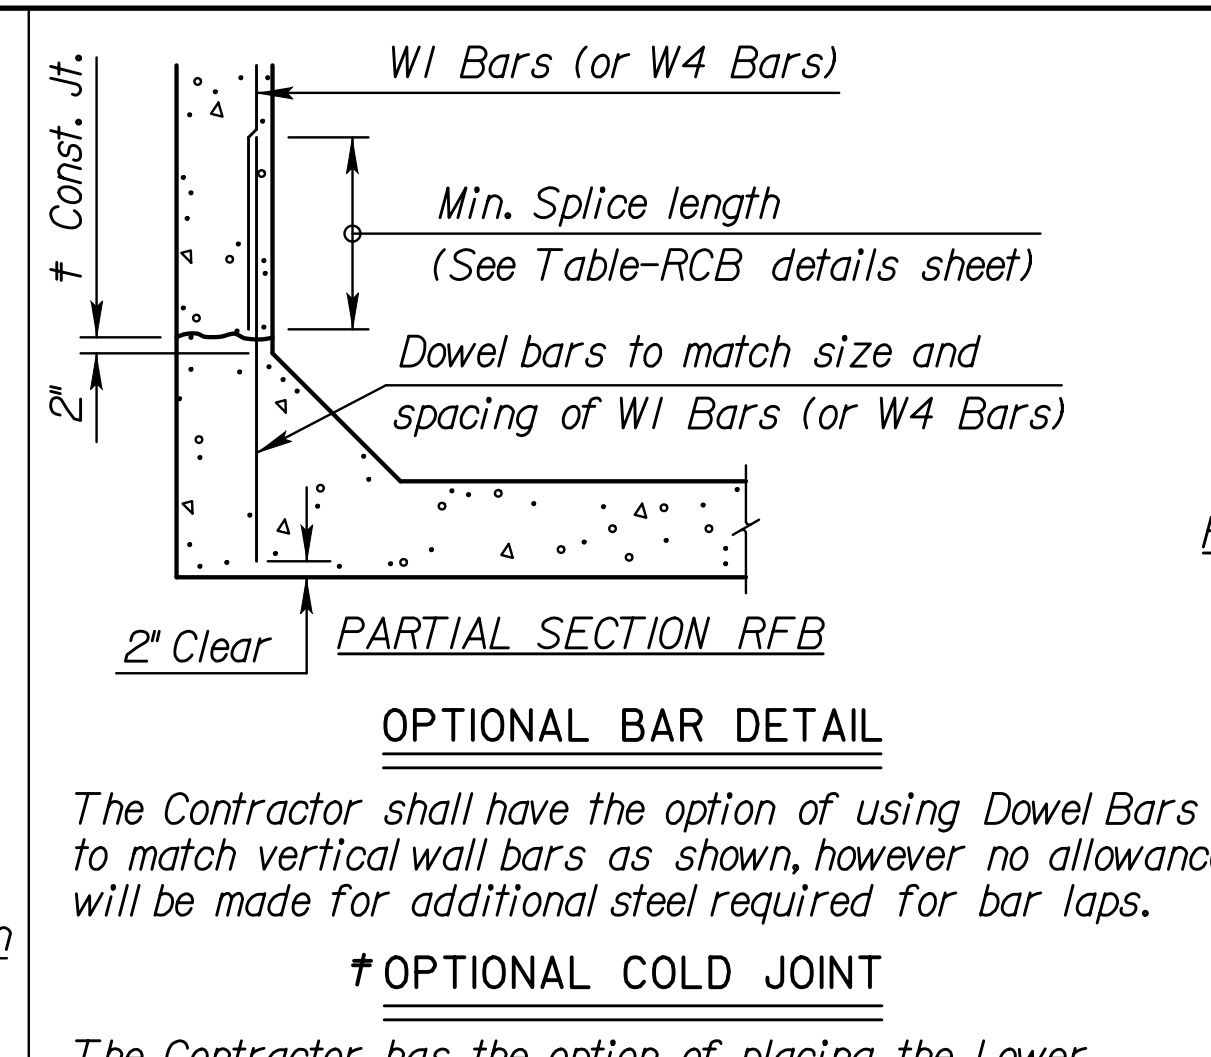


| STATE | PROJECT NO. | YEAR | SHEET NO. | TOTAL SHEETS |
|--------|-------------|------|-----------|--------------|
| KANSAS | | 2011 | 35 | 100 |

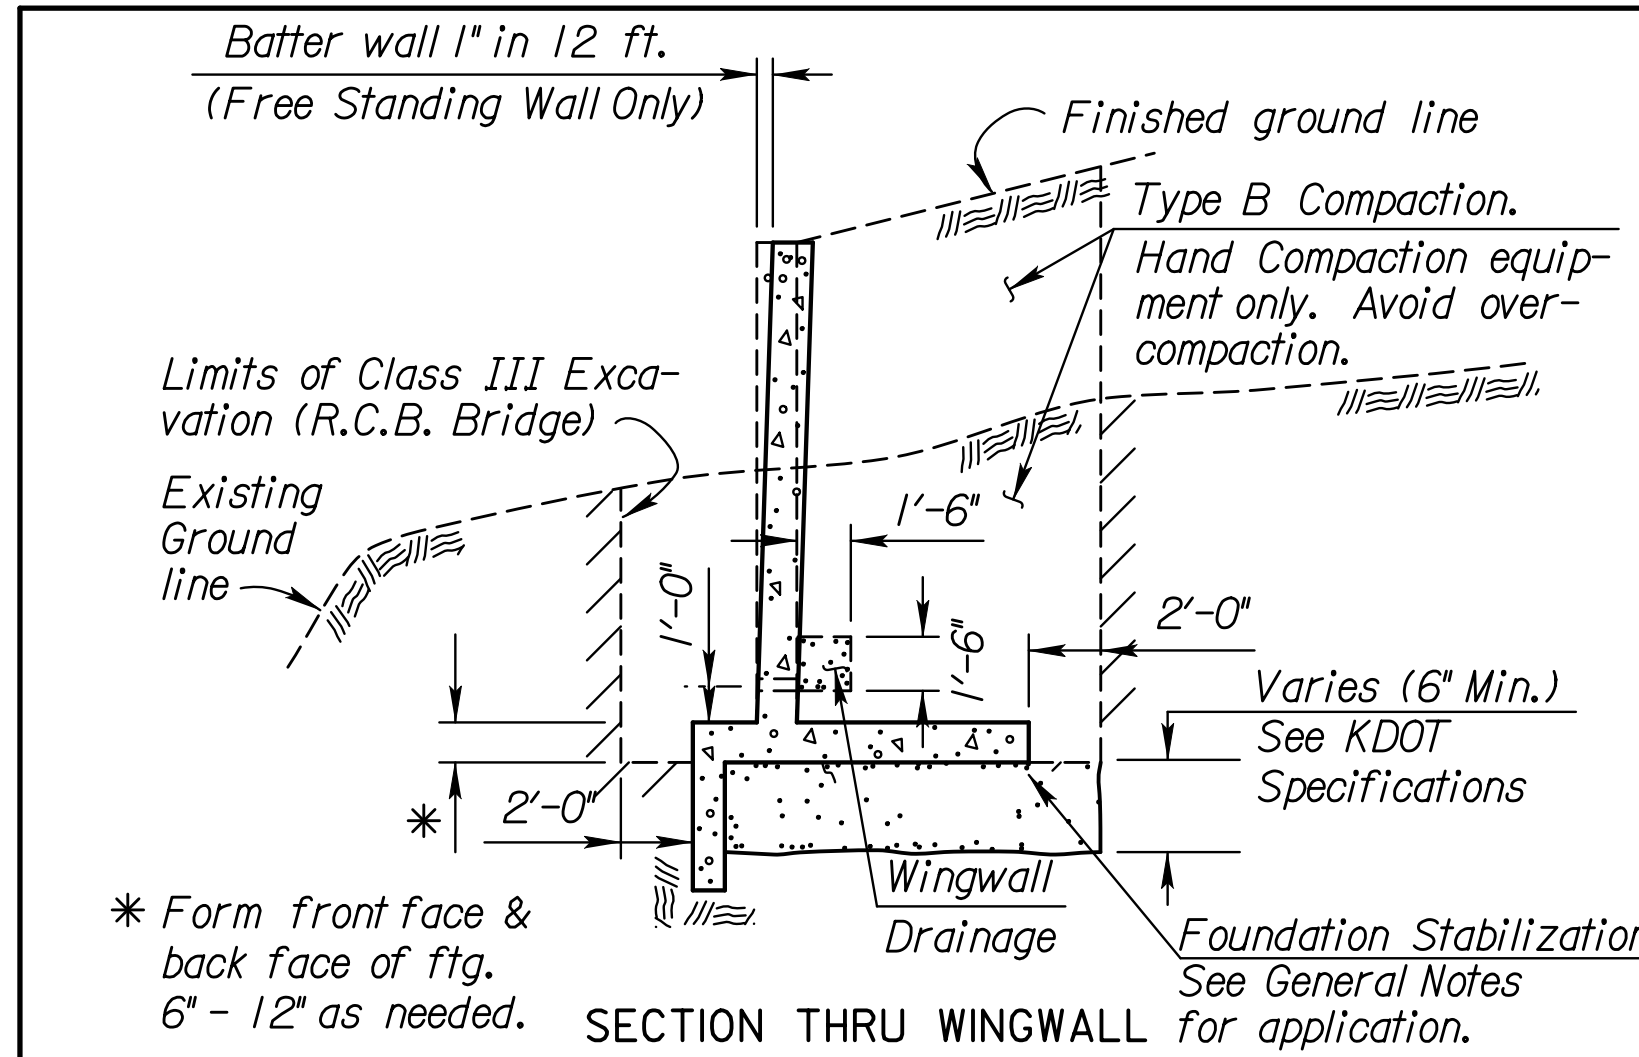

Std. Base File: br020.dgn
 Plot Location: Bridge Design
 Plotted By: smarquis
 File: br020.dgn (br020)
 Plot Date: 18-SEP-2009 14:11

| NO. | DATE | REVISIONS | BY | APP'D |
|-----|----------|------------------------------------|-----|-------|
| 3 | 7/14/08 | Change Type 'C' Compaction to 'B' | JPJ | KFH |
| 2 | 10/16/06 | Add Found. Stab. Details and Notes | JPJ | KFH |
| 1 | 3/2/06 | Optional Construction Joint | JPJ | KFH |

KANSAS DEPARTMENT OF TRANSPORTATION

RCB AUXILIARY DETAILS

BR020

| | | | | |
|------------|----------------|---------------|-------|------------------|
| DESIGNED | RAMI DETAILED | II/01/06 | APP'D | KENNETH F. HURST |
| DESIGN CK. | RRR DETAIL CK. | RRR QUAN. CK. | CADD | CADD CK. |