


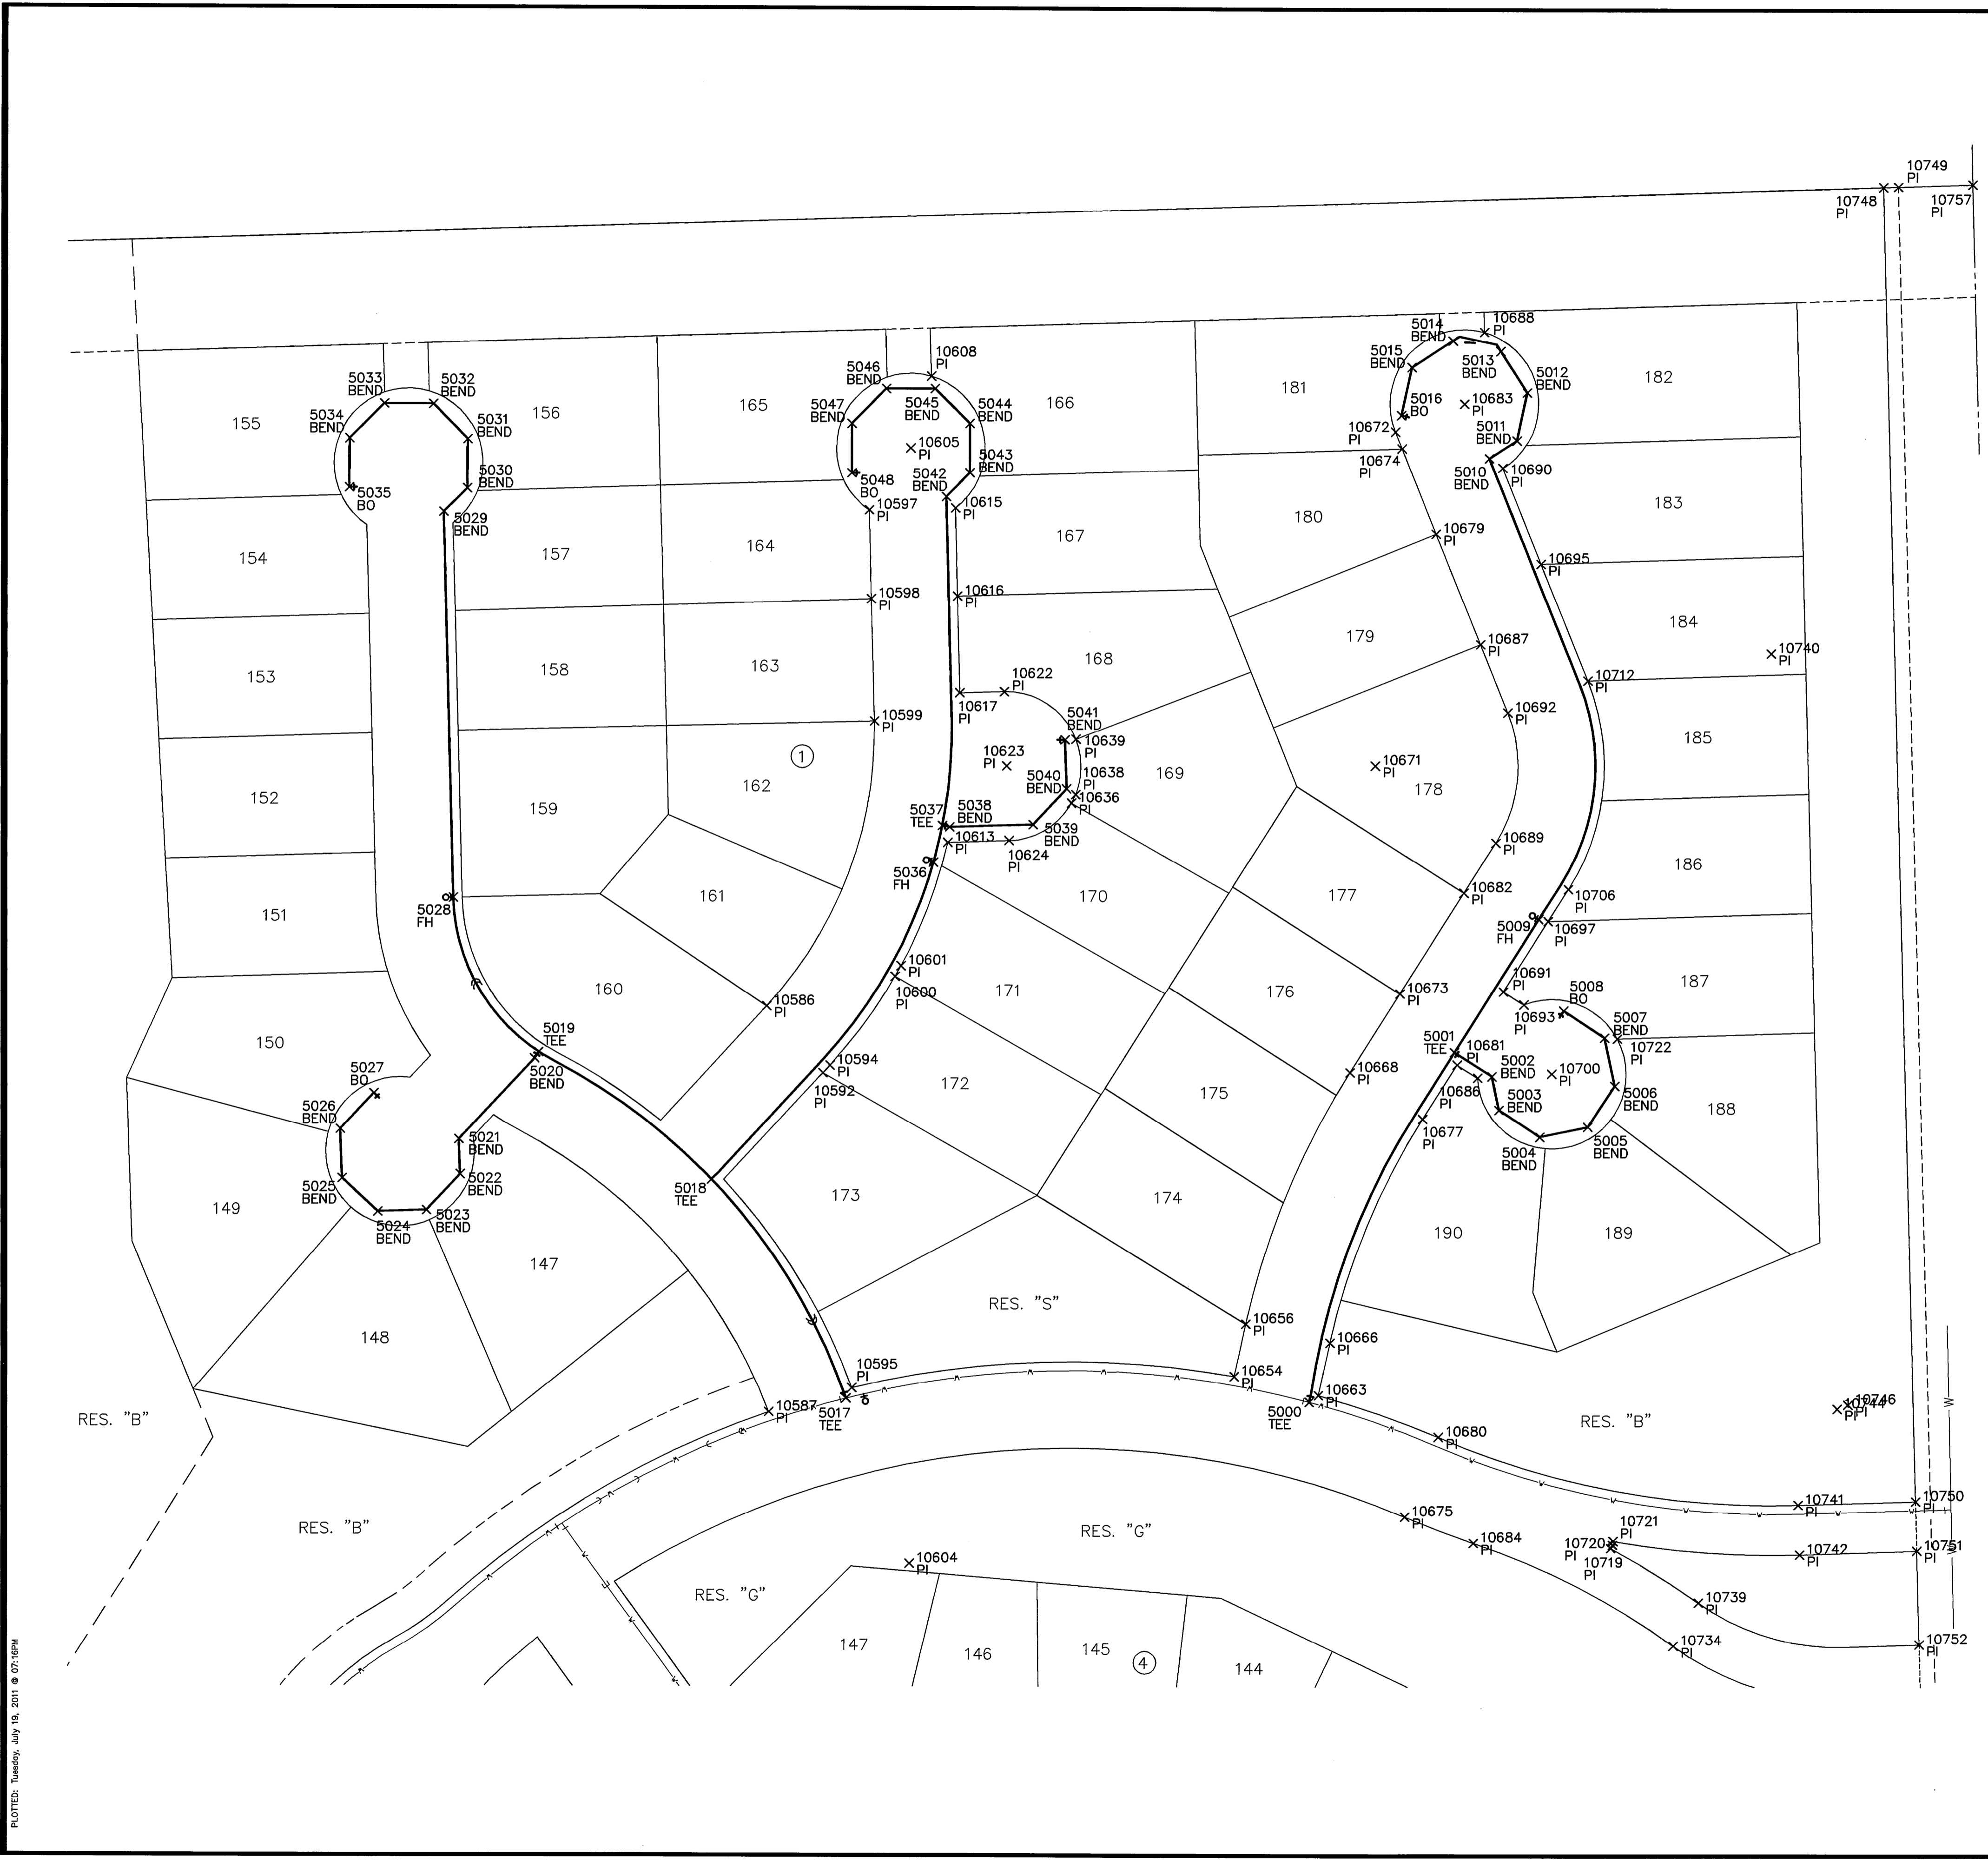


**WATER DISTRIBUTION PLANS FOR
FOX RIDGE ADDITION
PHASE 14**



WATER POINTS			
Point #	Northing	Easting	Desc.
3100	1705995.00	1617239.96	TEE
3101	1706229.38	1617337.62	TEE
3102	1706213.35	1617362.82	BEND
3103	1706190.81	1617367.51	BEND
3104	1706172.77	1617395.03	BEND
3105	1706179.47	1617427.25	BEND
3106	1706206.99	1617445.30	BEND
3107	1706239.21	1617438.60	BEND
3108	1706257.25	1617411.08	BO
3109	1706318.38	1617394.25	FH
3110	1706627.70	1617360.75	BEND
3111	1706639.62	1617379.27	BEND
3112	1706671.79	1617386.24	BEND
3113	1706699.46	1617368.42	BEND
3114	1706706.43	1617336.26	BEND
3115	1706688.61	1617308.59	BEND
3116	1706656.45	1617301.62	BO
3117	1705996.85	1616928.57	TEE
3118	1706143.38	1616837.88	TEE
3119	1706228.46	1616721.72	TEE
3120	1706224.27	1616718.99	BEND
3121	1706170.08	1616668.05	BEND
3122	1706146.55	1616668.83	BEND
3123	1706122.52	1616646.35	BEND
3124	1706121.42	1616613.46	BEND
3125	1706143.91	1616589.43	BEND
3126	1706176.80	1616588.33	BEND
3127	1706200.83	1616610.82	BO
3128	1706331.53	1616664.29	FH
3129	1706590.29	1616657.62	BEND
3130	1706606.03	1616673.55	BEND
3131	1706638.94	1616673.75	BEND
3132	1706662.35	1616650.62	BEND
3133	1706662.56	1616617.71	BEND
3134	1706639.43	1616594.30	BEND
3135	1706606.52	1616594.09	BO
3136	1706355.92	1616987.28	FH
3137	1706380.54	1616993.21	TEE
3138	1706379.56	1616998.11	BEND
3139	1706381.86	1617054.22	BEND
3140	1706405.36	1617076.73	BEND
3141	1706438.25	1617075.68	BEND
3142	1706601.19	1616995.58	BEND
3143	1706617.22	1617011.53	BEND
3144	1706650.13	1617011.44	BEND
3145	1706673.34	1616988.10	BEND
3146	1706673.25	1616955.19	BEND
3147	1706649.91	1616931.98	BEND
3148	1706617.00	1616932.07	BO

PLAT IRONS			
Point #	Northing	Easting	Desc.
10586	1706259.40	1616875.08	PI
10587	1705987.66	1616876.54	PI
10592	1706214.78	1616912.79	PI
10594	1706219.94	1616917.58	PI
10595	1706003.97	1616932.37	PI
10597	1706592.11	1616943.79	PI
10598	1706532.67	1616945.30	PI
10599	1706450.61	1616947.37	PI
10600	1706279.40	1616961.46	PI
10601	1706286.54	1616965.46	PI
10604	1705886.10	1616971.12	PI
10605	1706633.57	1616971.76	PI
10608	1706681.63	1616985.55	PI
10613	1706369.24	1616996.91	PI
10615	1706593.58	1617001.78	PI
10616	1706534.53	1617003.27	PI
10617	1706469.55	1617004.91	PI
10622	1706470.51	1617034.89	PI
10623	1706420.53	1617036.50	PI
10624	1706370.56	1617038.10	PI
10636	1706395.89	1617080.00	PI
10638	1706401.55	1617082.75	PI
10639	1706438.68	1617083.09	PI
10654	1706012.21	1617189.55	PI
10656	1706047.29	1617197.40	PI
10663	1705999.55	1617246.15	PI
10666	1706034.62	1617254.00	PI
10668	1706215.78	1617267.33	PI
10671	1706421.30	1617284.31	PI
10672	1706645.44	1617297.55	PI
10673	1706268.63	1617300.96	PI
10674	1706634.15	1617302.09	PI
10675	1705918.14	1617304.19	PI
10677	1706184.64	1617316.26	PI
10679	1706577.14	1617325.05	PI
10680	1705971.51	1617326.90	PI
10681	1706221.10	1617339.46	PI
10682	1706336.13	1617343.91	PI
10683	1706664.12	1617343.93	PI
10684	1705900.58	1617350.44	PI
10686	1706212.41	1617353.12	PI
10687	1706502.93	1617354.94	PI
10688	1706712.27	1617357.39	PI
10689	1706369.76	1617365.31	PI
10690	1706621.32	1617369.79	PI
10691	1706270.04	1617370.60	PI
10692	1706457.16	1617373.37	PI
10693	1706261.34	1617384.26	PI
10695	1706557.11	1617395.64	PI
10697	1706317.15	1617400.58	PI
10700	1706215.01	1617403.05	PI
10706	1706338.63	1617414.24	PI
10712	1706478.82	1617427.17	PI
10719	1705897.16	1617442.72	PI
10720	1705899.36	1617443.90	PI
10721	1705901.83	1617444.34	PI
10722	1706238.60	1617447.14	PI
10734	1705831.40	1617484.87	PI
10739	1705860.47	1617501.82	PI
10740	1706496.95	1617550.41	PI
10741	1705926.24	1617568.72	PI
10742	1705892.76	1617569.79	PI
10744	1705990.61	1617594.90	PI
10746	1705993.35	1617602.22	PI
10747	1705793.45	1617608.63	PI
10748	1706809.61	1617625.51	PI
10749	1706809.93	1617635.51	PI
10750	1705928.77	1617647.77	PI
10751	1705895.28	1617648.62	PI
10752	1705832.30	1617650.21	PI
10753	1705794.81	1617651.16	PI
10757	1706811.53	1617685.48	PI
10758	1705931.79	1617713.64	PI
18900	1705794.81	1617651.16	PI

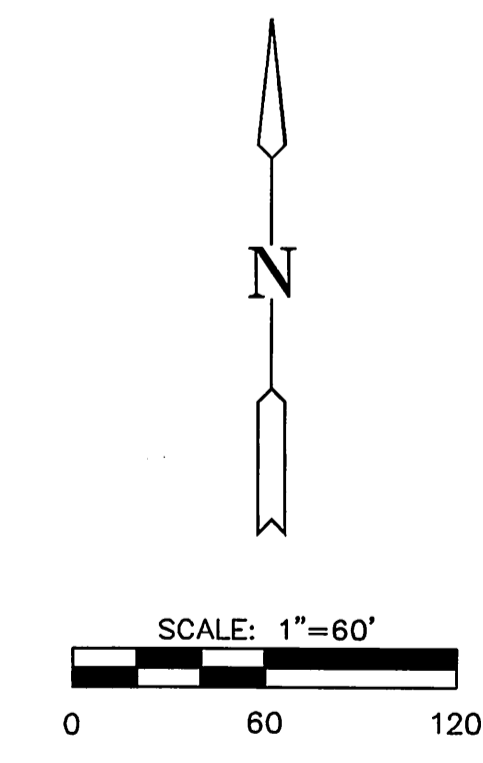


G:\CIVIL\99118.DWG\WTR\PL_14_99118_BLD.DWG

BUBBLE MAP
SHEET TITLE
448-89839
PROJECT NUMBER

DFL / JWC / GJA
DESIGNED DRAWN CHECKED

ISSUED July 2011
REVISED

SHEET NO.
7 of 13