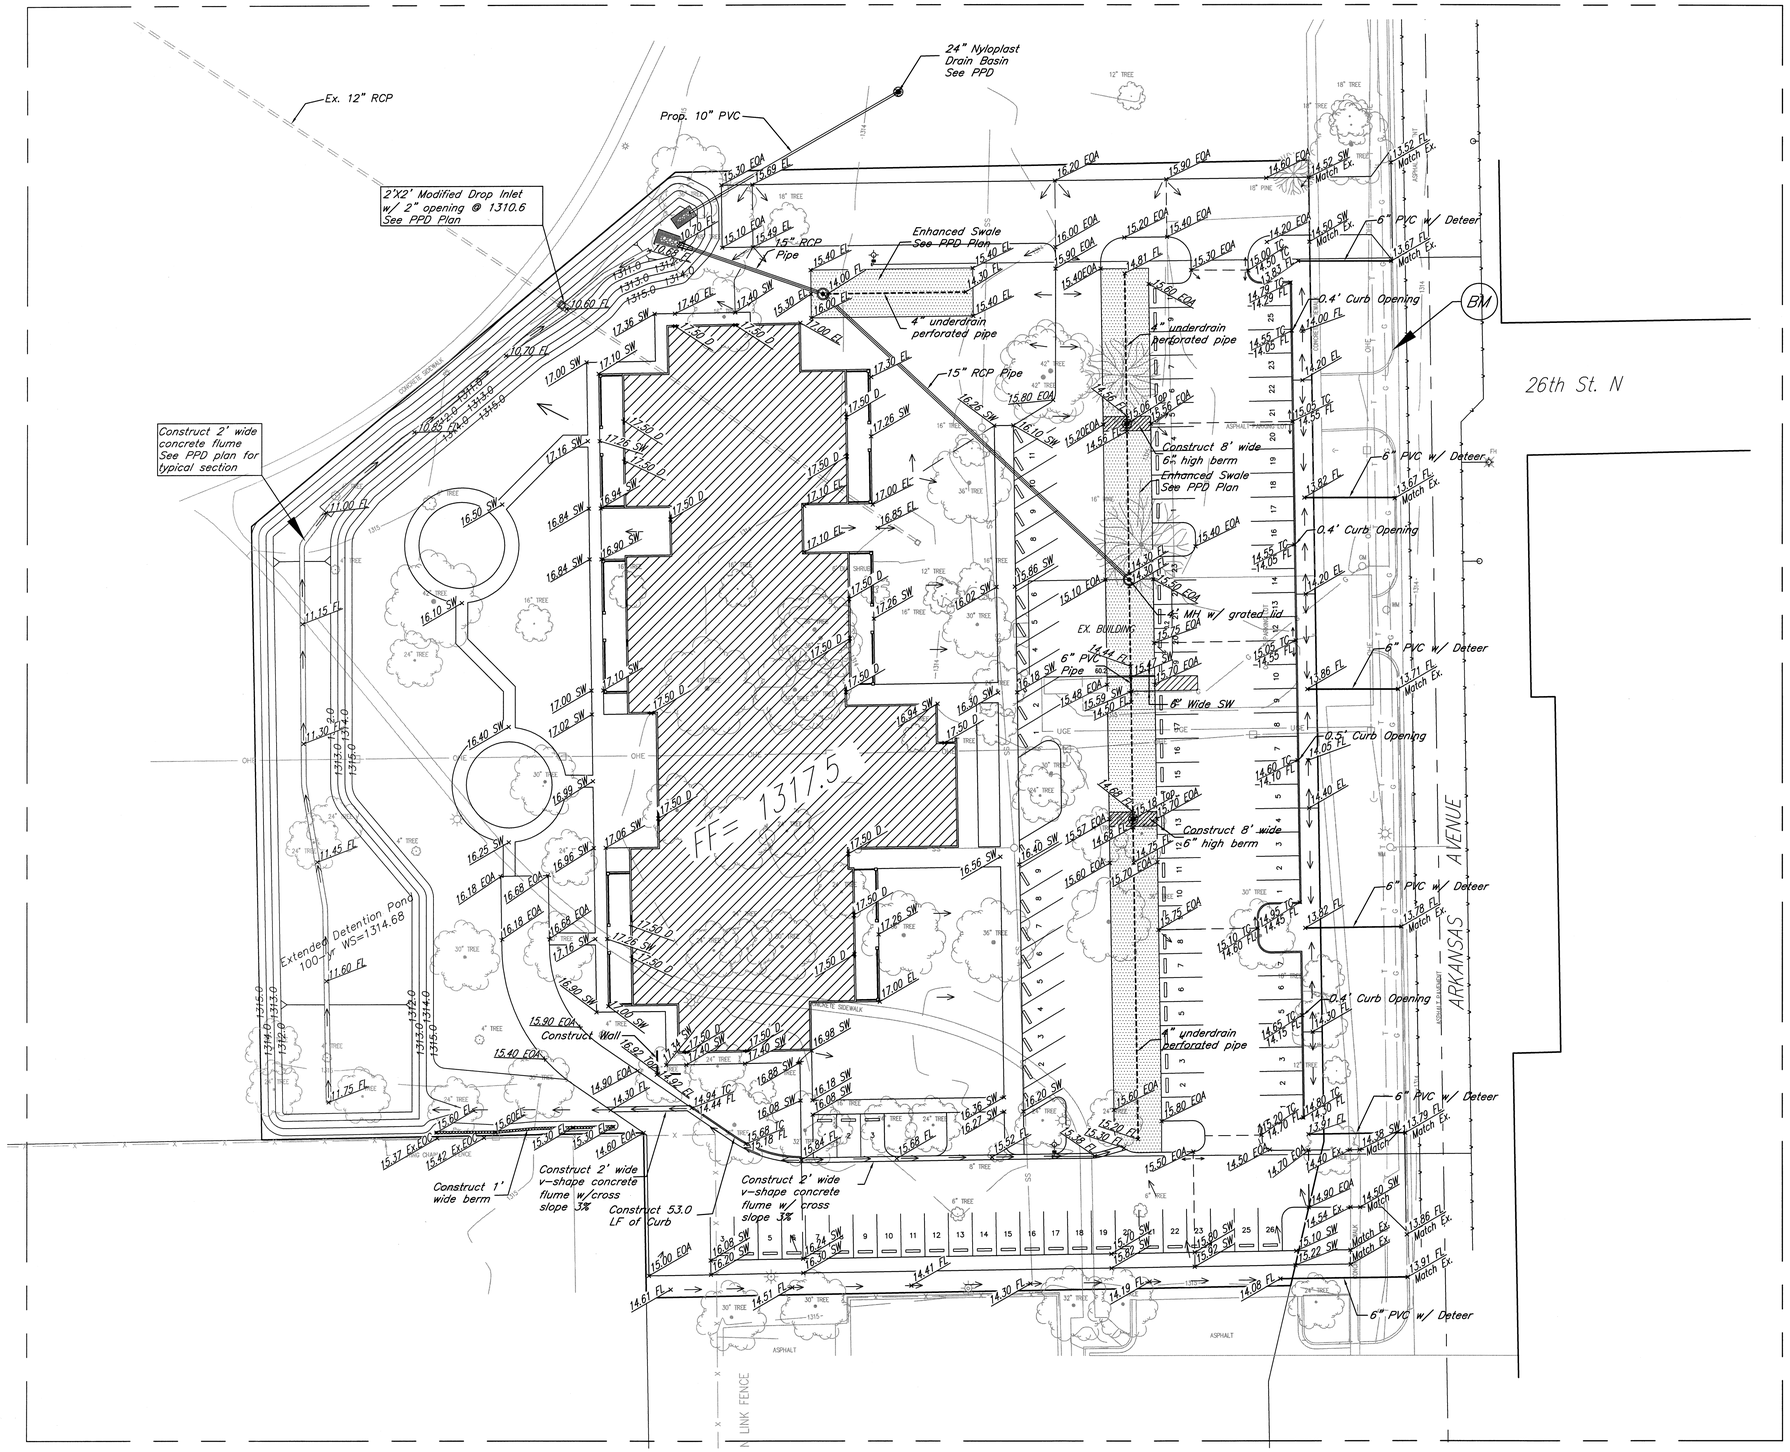

AS BUILTS

kemiller engineering
516 S. Market,
Wichita, KS 67202
(316)264-0242

Benchmark
See drawing for location.
Elevation =1314.13

KIRK E. MILLER
LICENSED
11283
KANSAS
PROFESSIONAL ENGINEER

30 0 15 30 60 120
(IN FEET)
1 inch = 30 ft.

TOP - North Central
Grading Plan
Wichita, Kansas

kemiller engineering
516 S. Market, Wichita, KS 67202 (316)264-0242

PROJECT NUMBER			
KEM NO. 10147	FILE	DATE 01/19/2011	SHEET 4.0
DESIGN KM	DRAWN NS	REVISED	