


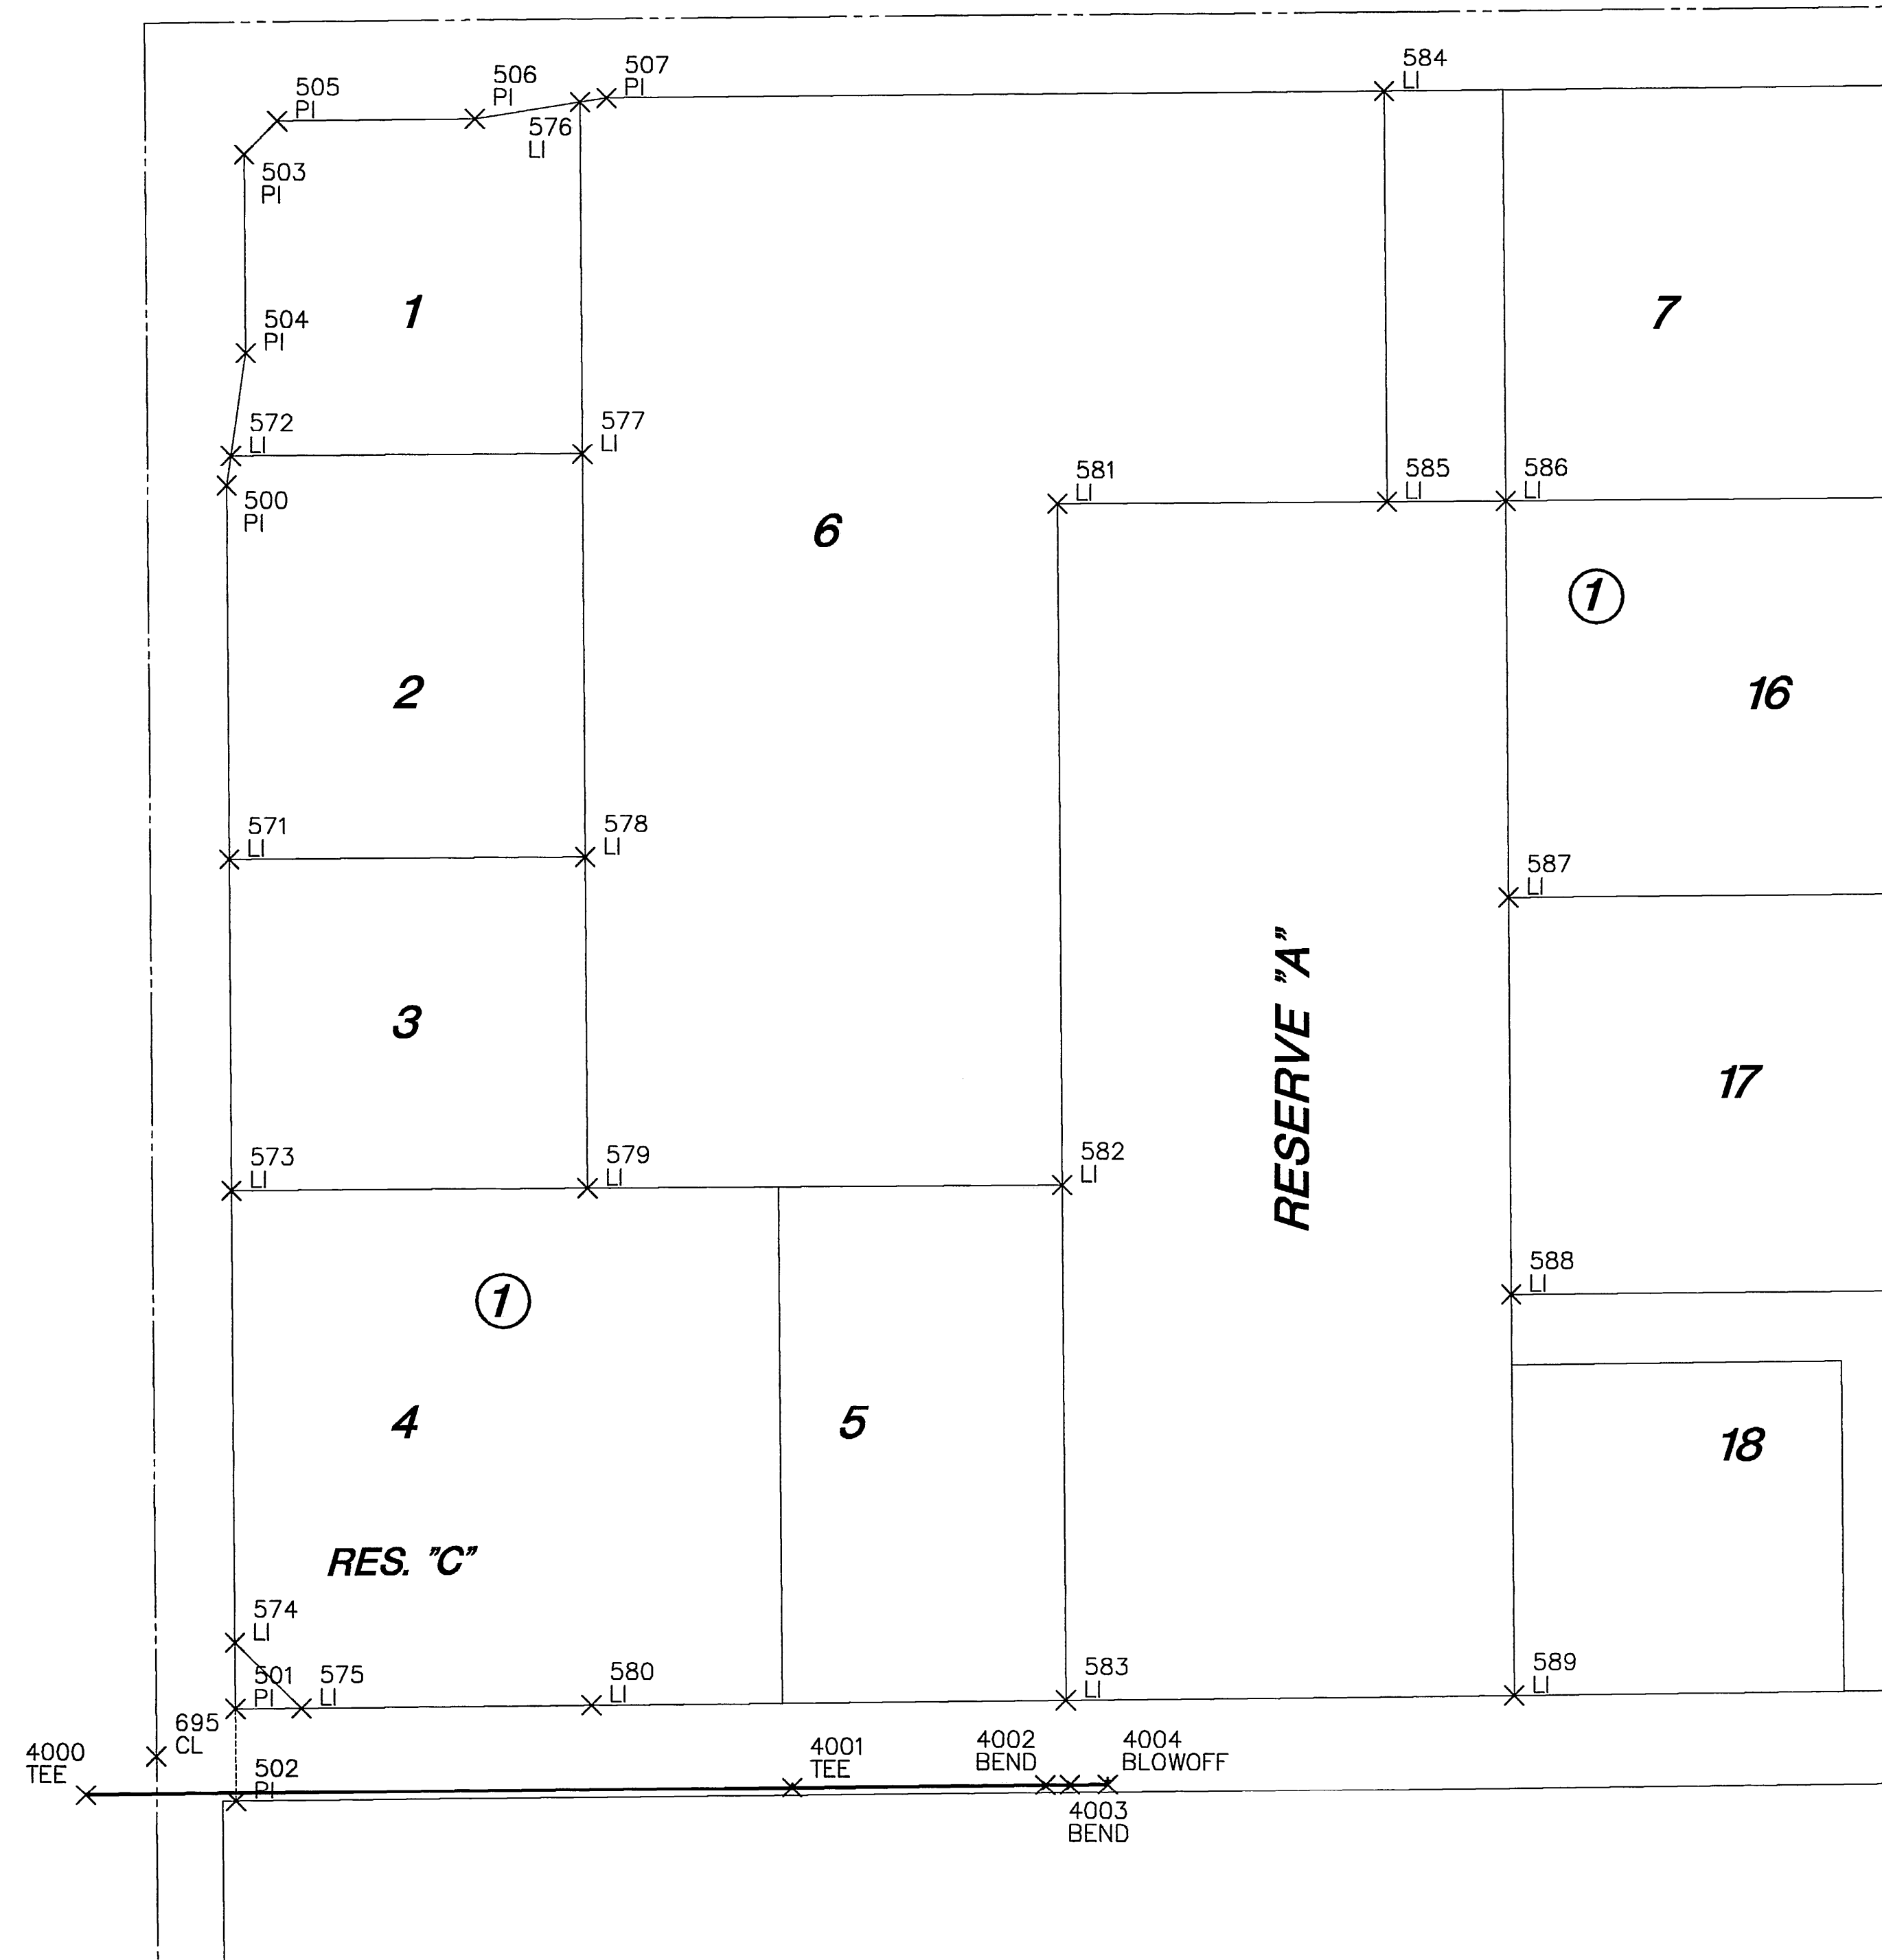

WATER DISTRIBUTION PLAN
GREENWICH BUSINESS CENTER
PHASE 1



PLAT POINTS			
Point #	Northing	Easting	Desc.
500	1704774.00	1686225.15	PI
501	1703849.56	1686233.88	PI
502	1703779.56	1686234.54	PI
503	1705024.13	1686237.79	PI
504	1704874.14	1686239.21	PI
505	1705049.45	1686262.55	PI
506	1705051.35	1686412.54	PI
507	1705067.63	1686512.34	PI
523	1706477.93	1688495.53	RP
571	1704491.42	1686227.82	LI
572	1704796.44	1686228.30	LI
573	1704241.44	1686230.18	LI
574	1703899.56	1686233.41	LI
575	1703850.22	1686283.88	LI
576	1705064.38	1686492.42	LI
577	1704798.96	1686494.93	LI
578	1704493.97	1686497.81	LI
579	1704243.98	1686500.17	LI
580	1703853.13	1686503.86	LI
581	1704762.36	1686855.29	LI
582	1704247.39	1686860.15	LI
583	1703857.89	1686863.83	LI
584	1705075.13	1687102.35	LI
585	1704764.72	1687105.28	LI
586	1704765.57	1687195.27	LI
587	1704465.59	1687198.11	LI
588	1704165.60	1687200.94	LI
589	1703862.39	1687203.80	LI
664	1706477.93	1688495.53	RP
695	1703813.77	1686174.22	CL

WATER POINTS			
Point #	Northing	Easting	Desc.
4000	1703784.06	1686120.71	TEE
4001	1703791.14	1686656.45	TEE
4002	1703793.68	1686848.50	BEND
4003	1703793.93	1686867.04	BEND
4004	1703794.31	1686895.75	BLOWOFF

BUBBLE MAP

SHEET TITLE
448-90517
PROJECT NUMBER

DFL / JWC / GJA
DESIGNED DRAWN CHECKED

ISSUED
August 2011

REVISED

SHEET NO.