



WATER DISTRIBUTION PLAN
GREENWICH BUSINESS CENTER
PHASE 1B

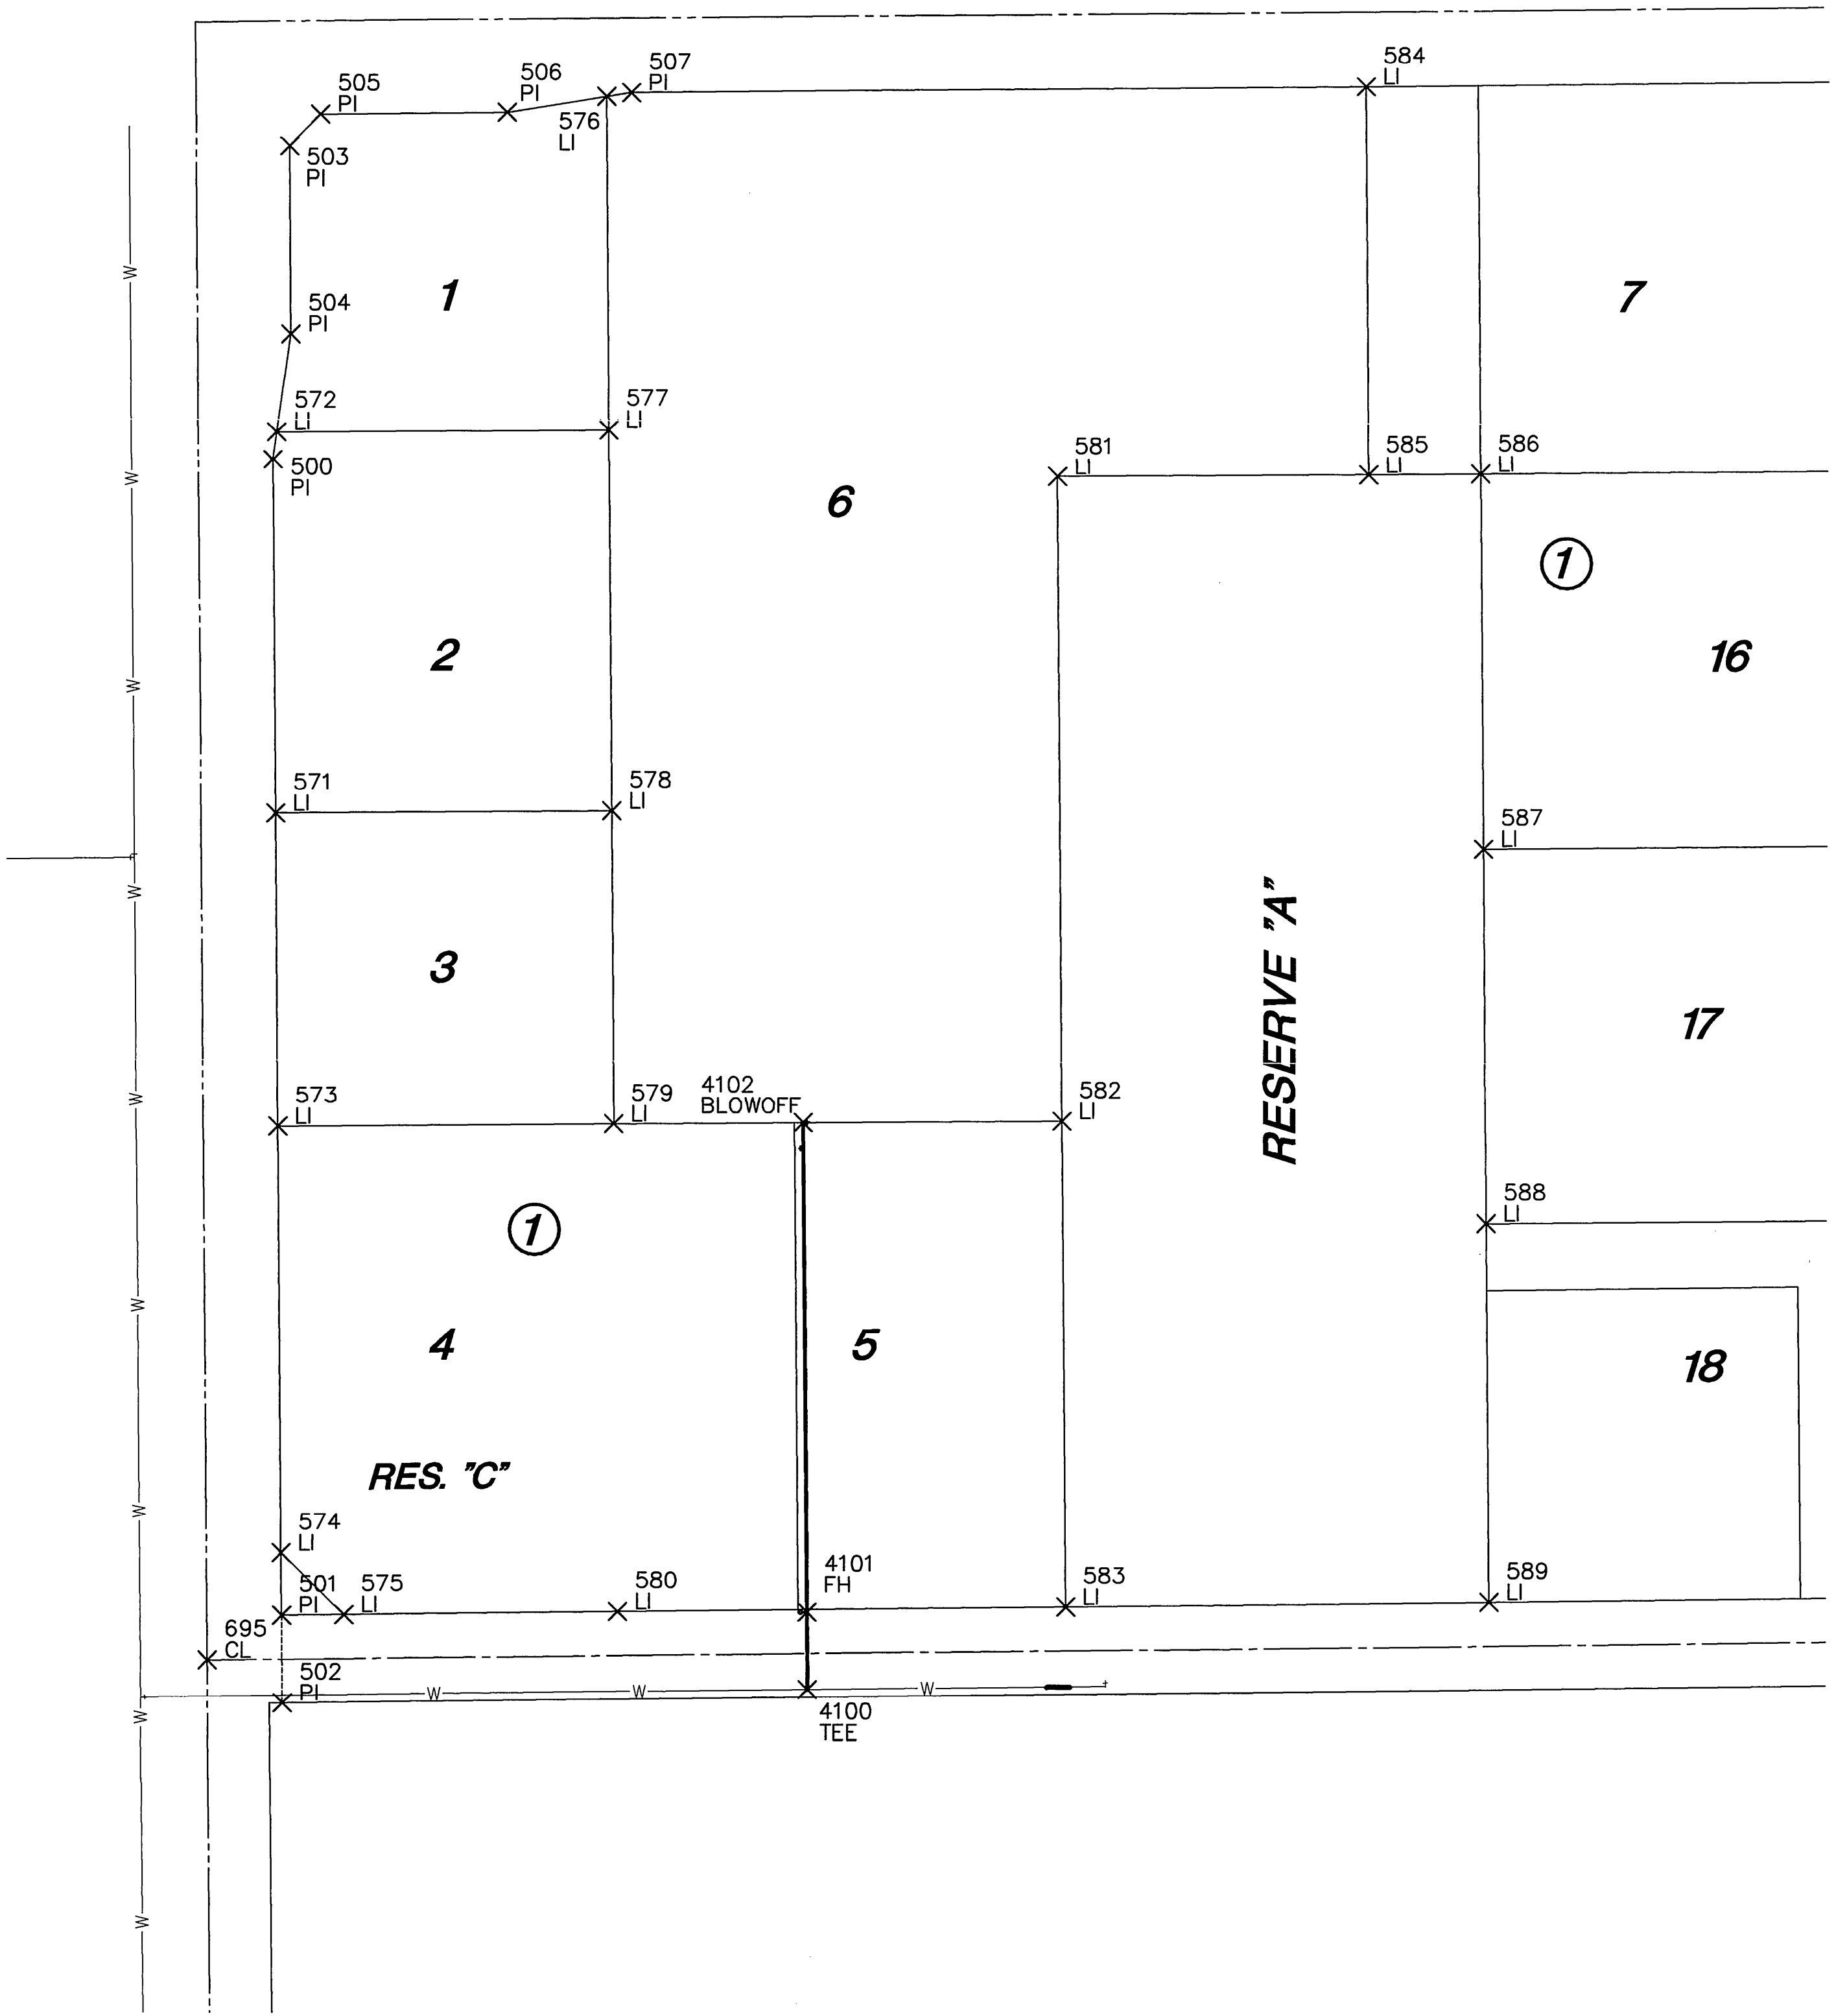

PLAT POINTS			
Point #	Northing	Easting	Desc.
500	1704774.00	1686225.15	PI
501	1703849.56	1686233.88	PI
502	1703779.56	1686234.54	PI
503	1705024.13	1686237.79	PI
504	1704874.14	1686239.21	PI
505	1705049.45	1686262.55	PI
506	1705051.35	1686412.54	PI
507	1705067.63	1686512.34	PI
571	1704491.42	1686227.82	LI
572	1704796.44	1686228.30	LI
573	1704241.44	1686230.18	LI
574	1703899.56	1686233.41	LI
575	1703850.22	1686283.88	LI
576	1705064.38	1686492.42	LI
577	1704798.96	1686494.93	LI
578	1704493.97	1686497.81	LI
579	1704243.98	1686500.17	LI
580	1703853.13	1686503.86	LI
581	1704762.36	1686855.29	LI
582	1704247.39	1686860.15	LI
583	1703857.89	1686863.83	LI
584	1705075.13	1687102.35	LI
585	1704764.72	1687105.28	LI
586	1704765.57	1687195.27	LI
587	1704465.59	1687198.11	LI
588	1704165.60	1687200.94	LI
589	1703862.39	1687203.80	LI
695	1703813.77	1686174.22	CL

WATER POINTS			
Point #	Northing	Easting	Desc.
4100	1703791.14	1686656.45	TEE
4101	1703853.13	1686655.86	FH
4102	1704245.42	1686652.16	BLOWOFF

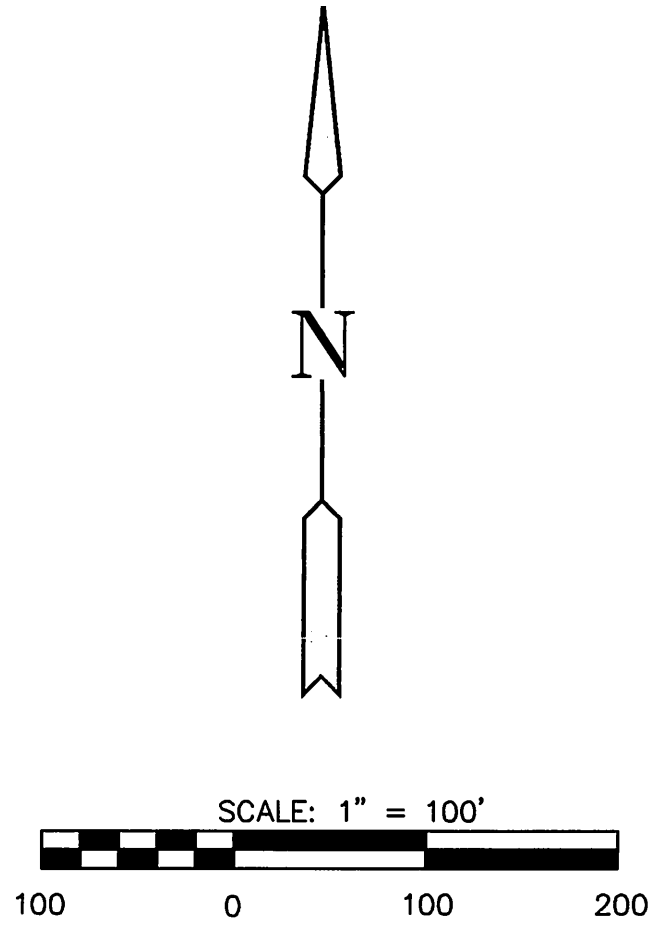

PLOTED: Tuesday, September 13, 2011 @ 03:51PM

J:\CIVIL\05039\DWG\CIVIL3D\WTR\PHASE 2\05039_BM.DWG

BUBBLE MAP
SHEET TITLE
448-90533
PROJECT NUMBER

DFL / JWC / GJA
DESIGNED / DRAWN / CHECKED

ISSUED
August 2011
REVISED

SHEET NO.
4 of 10