
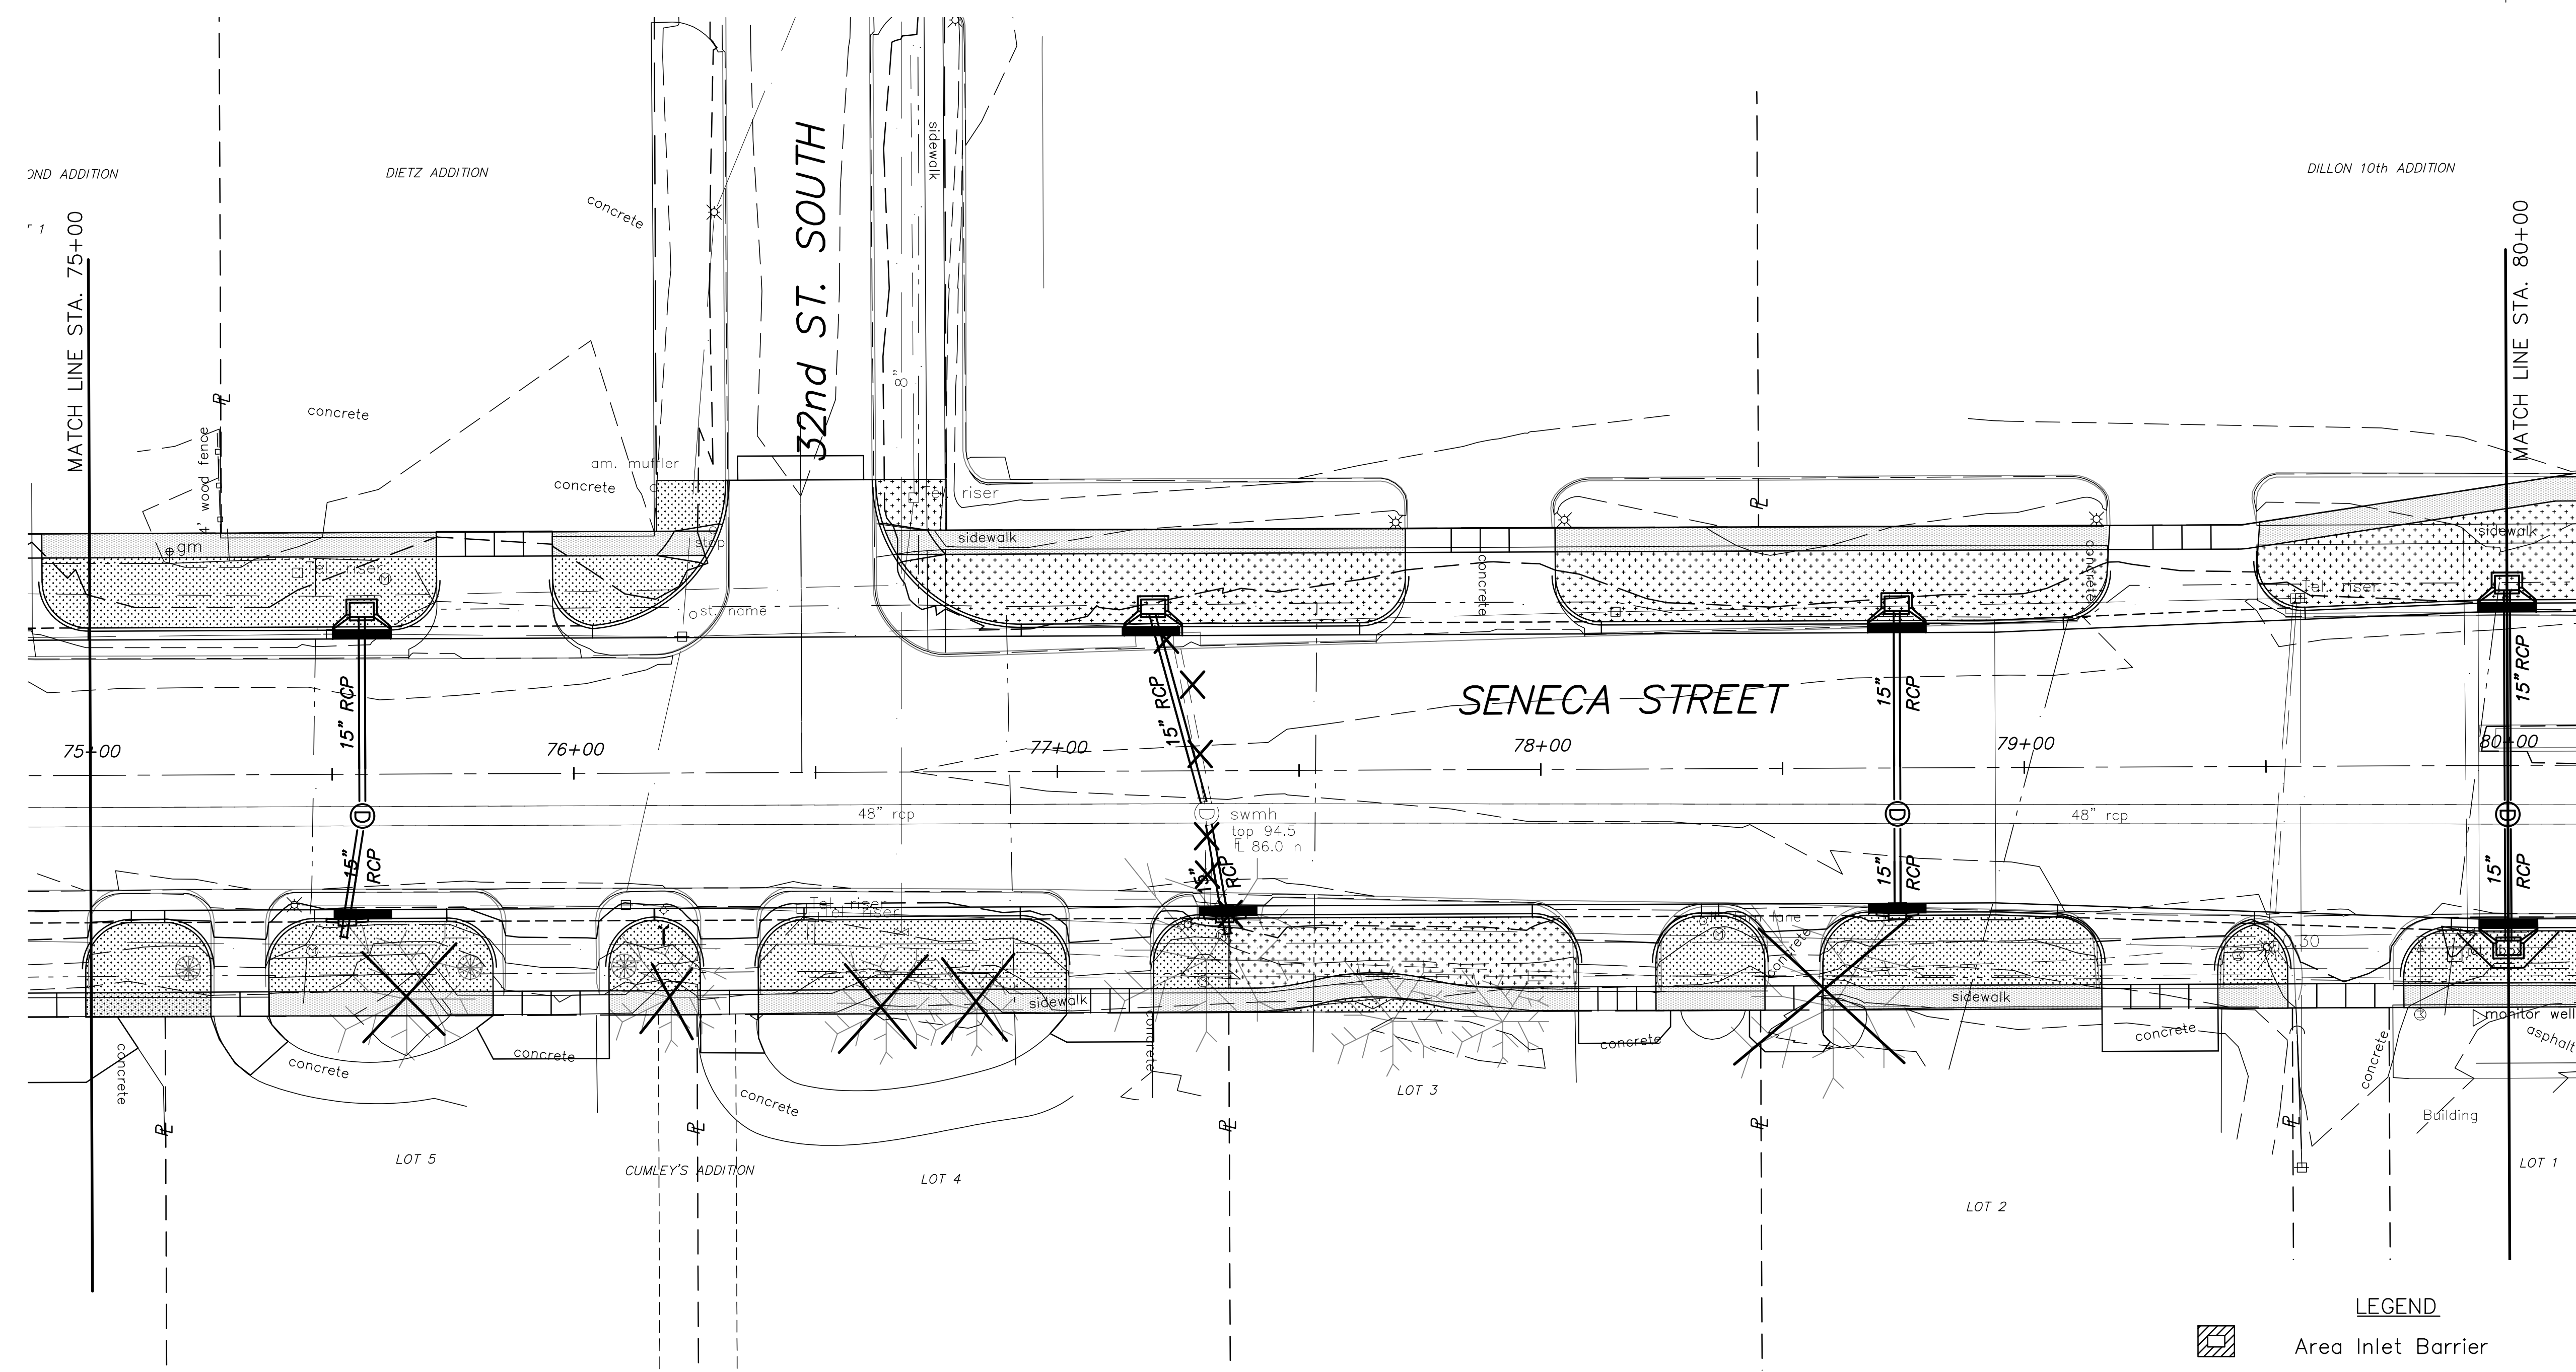


STATE	PROJECT NO.	YEAR	SHEET NO.	TOTAL SHEETS
KANSAS	87 N-0243-01	2005	78	169
Federal Aid No. STP N024(301)				

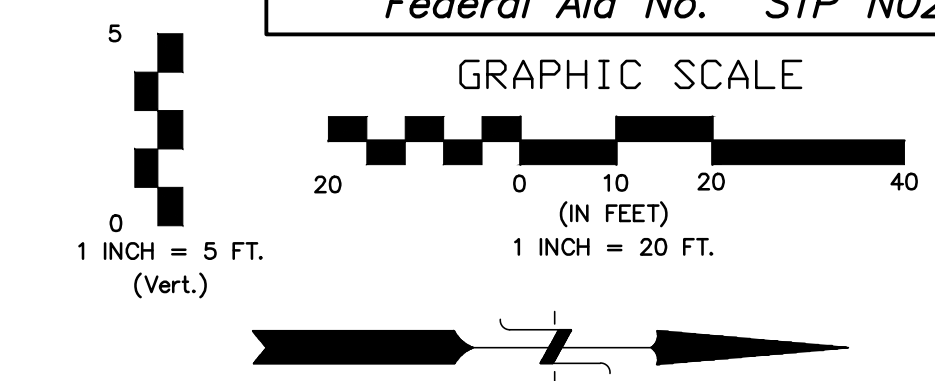

LEGEND

	Area Inlet Barrier
	Curb Inlet Filter
	Ditch Check
	Rock Ditch Check
	Silt Fence
	Bermuda Grass Sod
	Fescue Sod

No.	Date	By	Approved	Revision
1				
<p>POE & ASSOCIATES, INC. CONSULTING ENGINEERS 5940 E. Central, Suite 200 □ Wichita, KS 67208-4242 Phone 316.685-4114 □ FAX 316.685-4444</p>				
<p>SENeca STREET 1-235 TO 31ST STREET CITY OF WICHITA, KANSAS EROSION PLAN 75+00 to 80+00</p>				
<p>FINAL</p>				
<p>Engineer: P. FERGUSON Designer: J. UNRUH KDOT Job No.: 87 N-0502-01 Poee Job No.: 1794 Date: JANUARY 2010</p>				
<p>Sheet 78 of 169</p>				