



PAVING PLANS
HAMPTON SQUARE SECOND

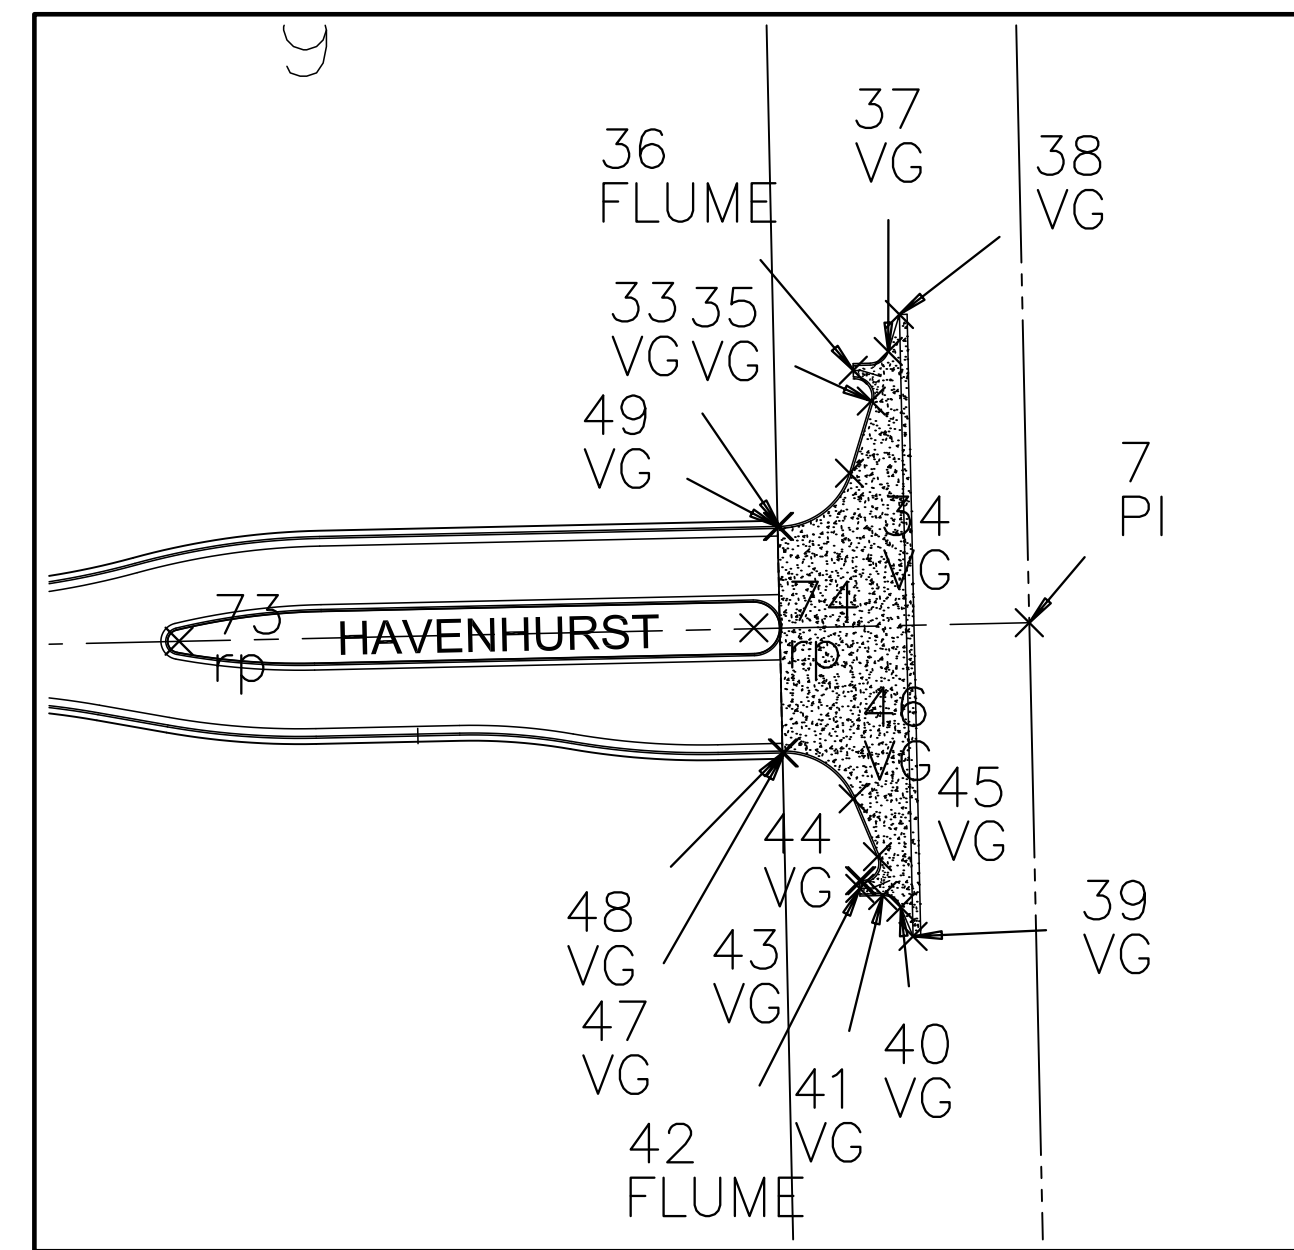


INSET B
SCALE: 1"=50'

NOTE:
POINTS ALONG CURB
ARE ON TOP OF CURB.

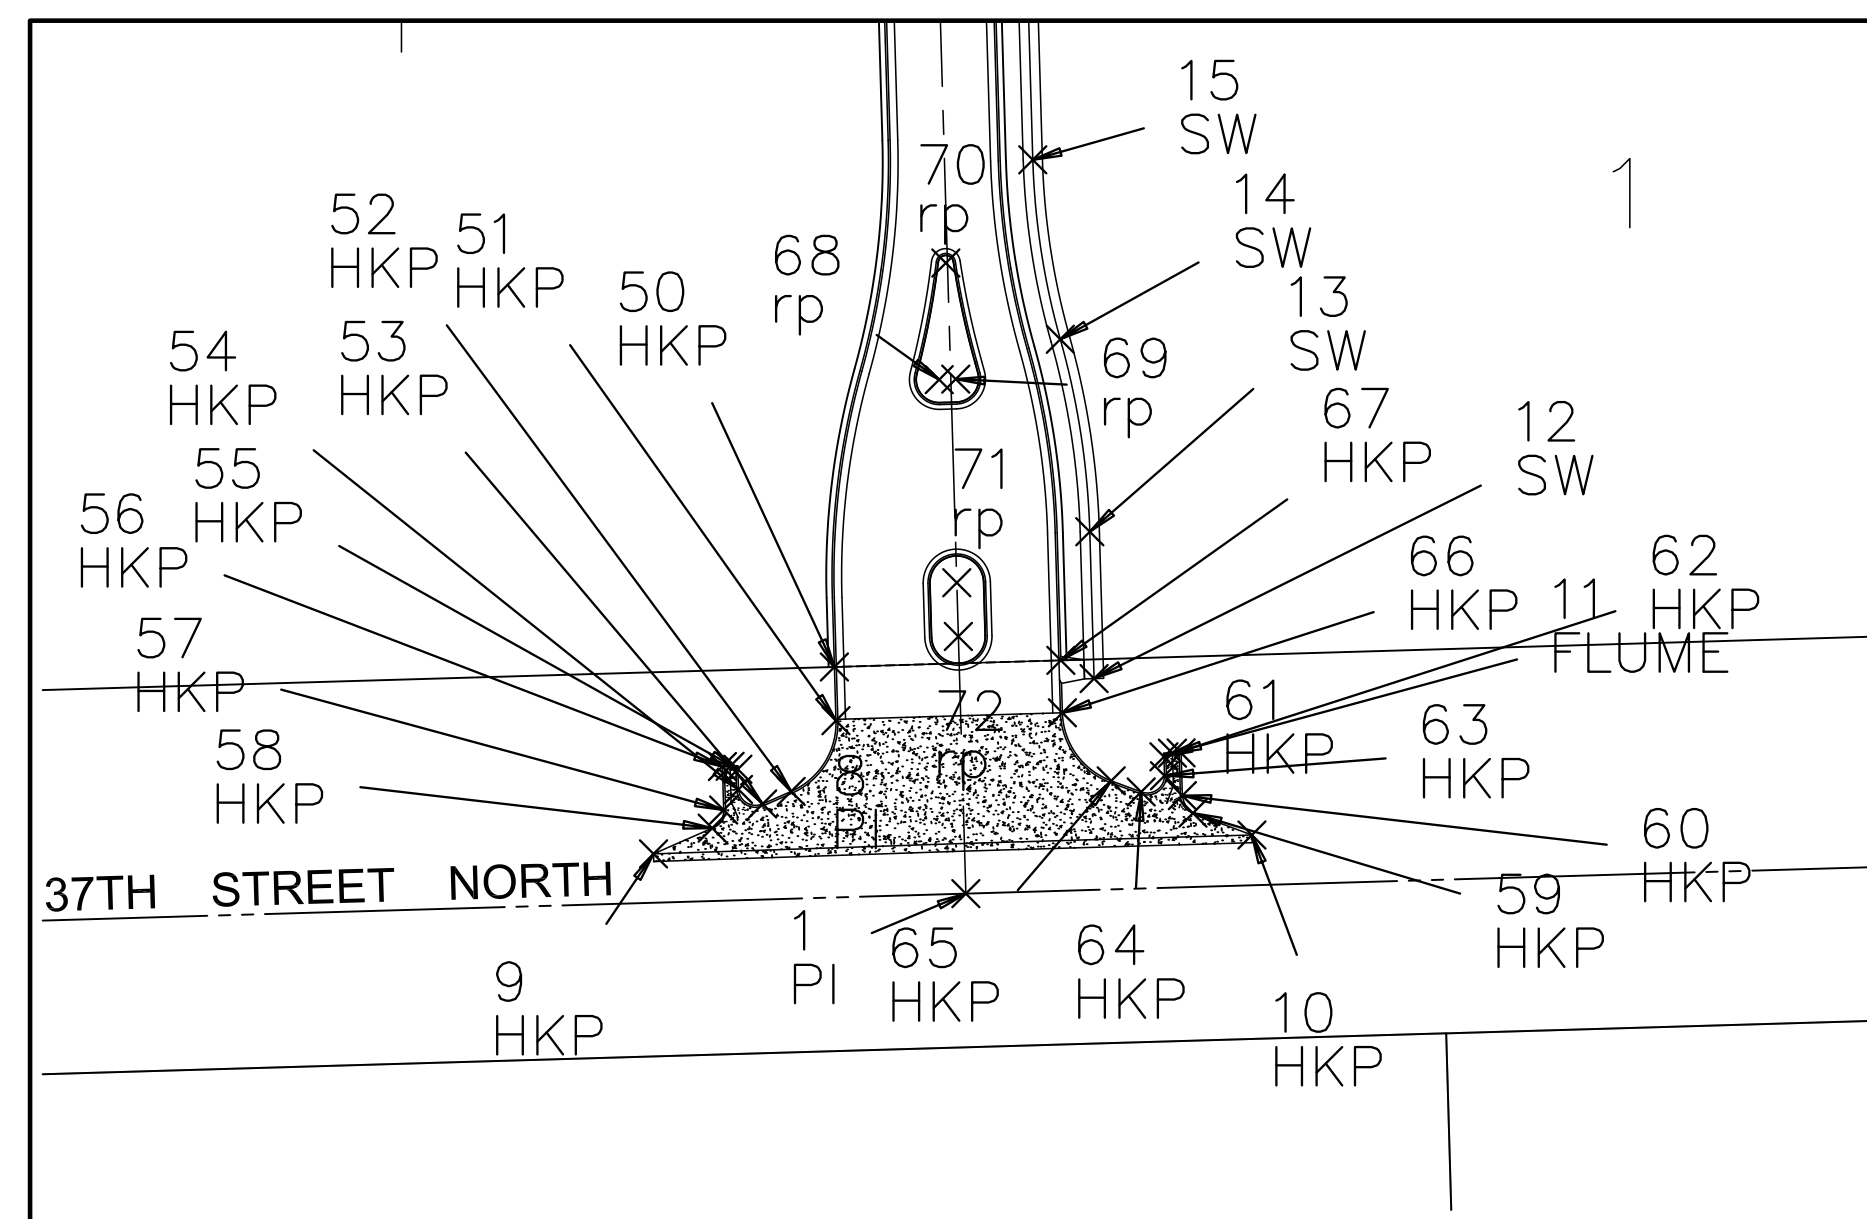

INSET A
SCALE: 1"=50'

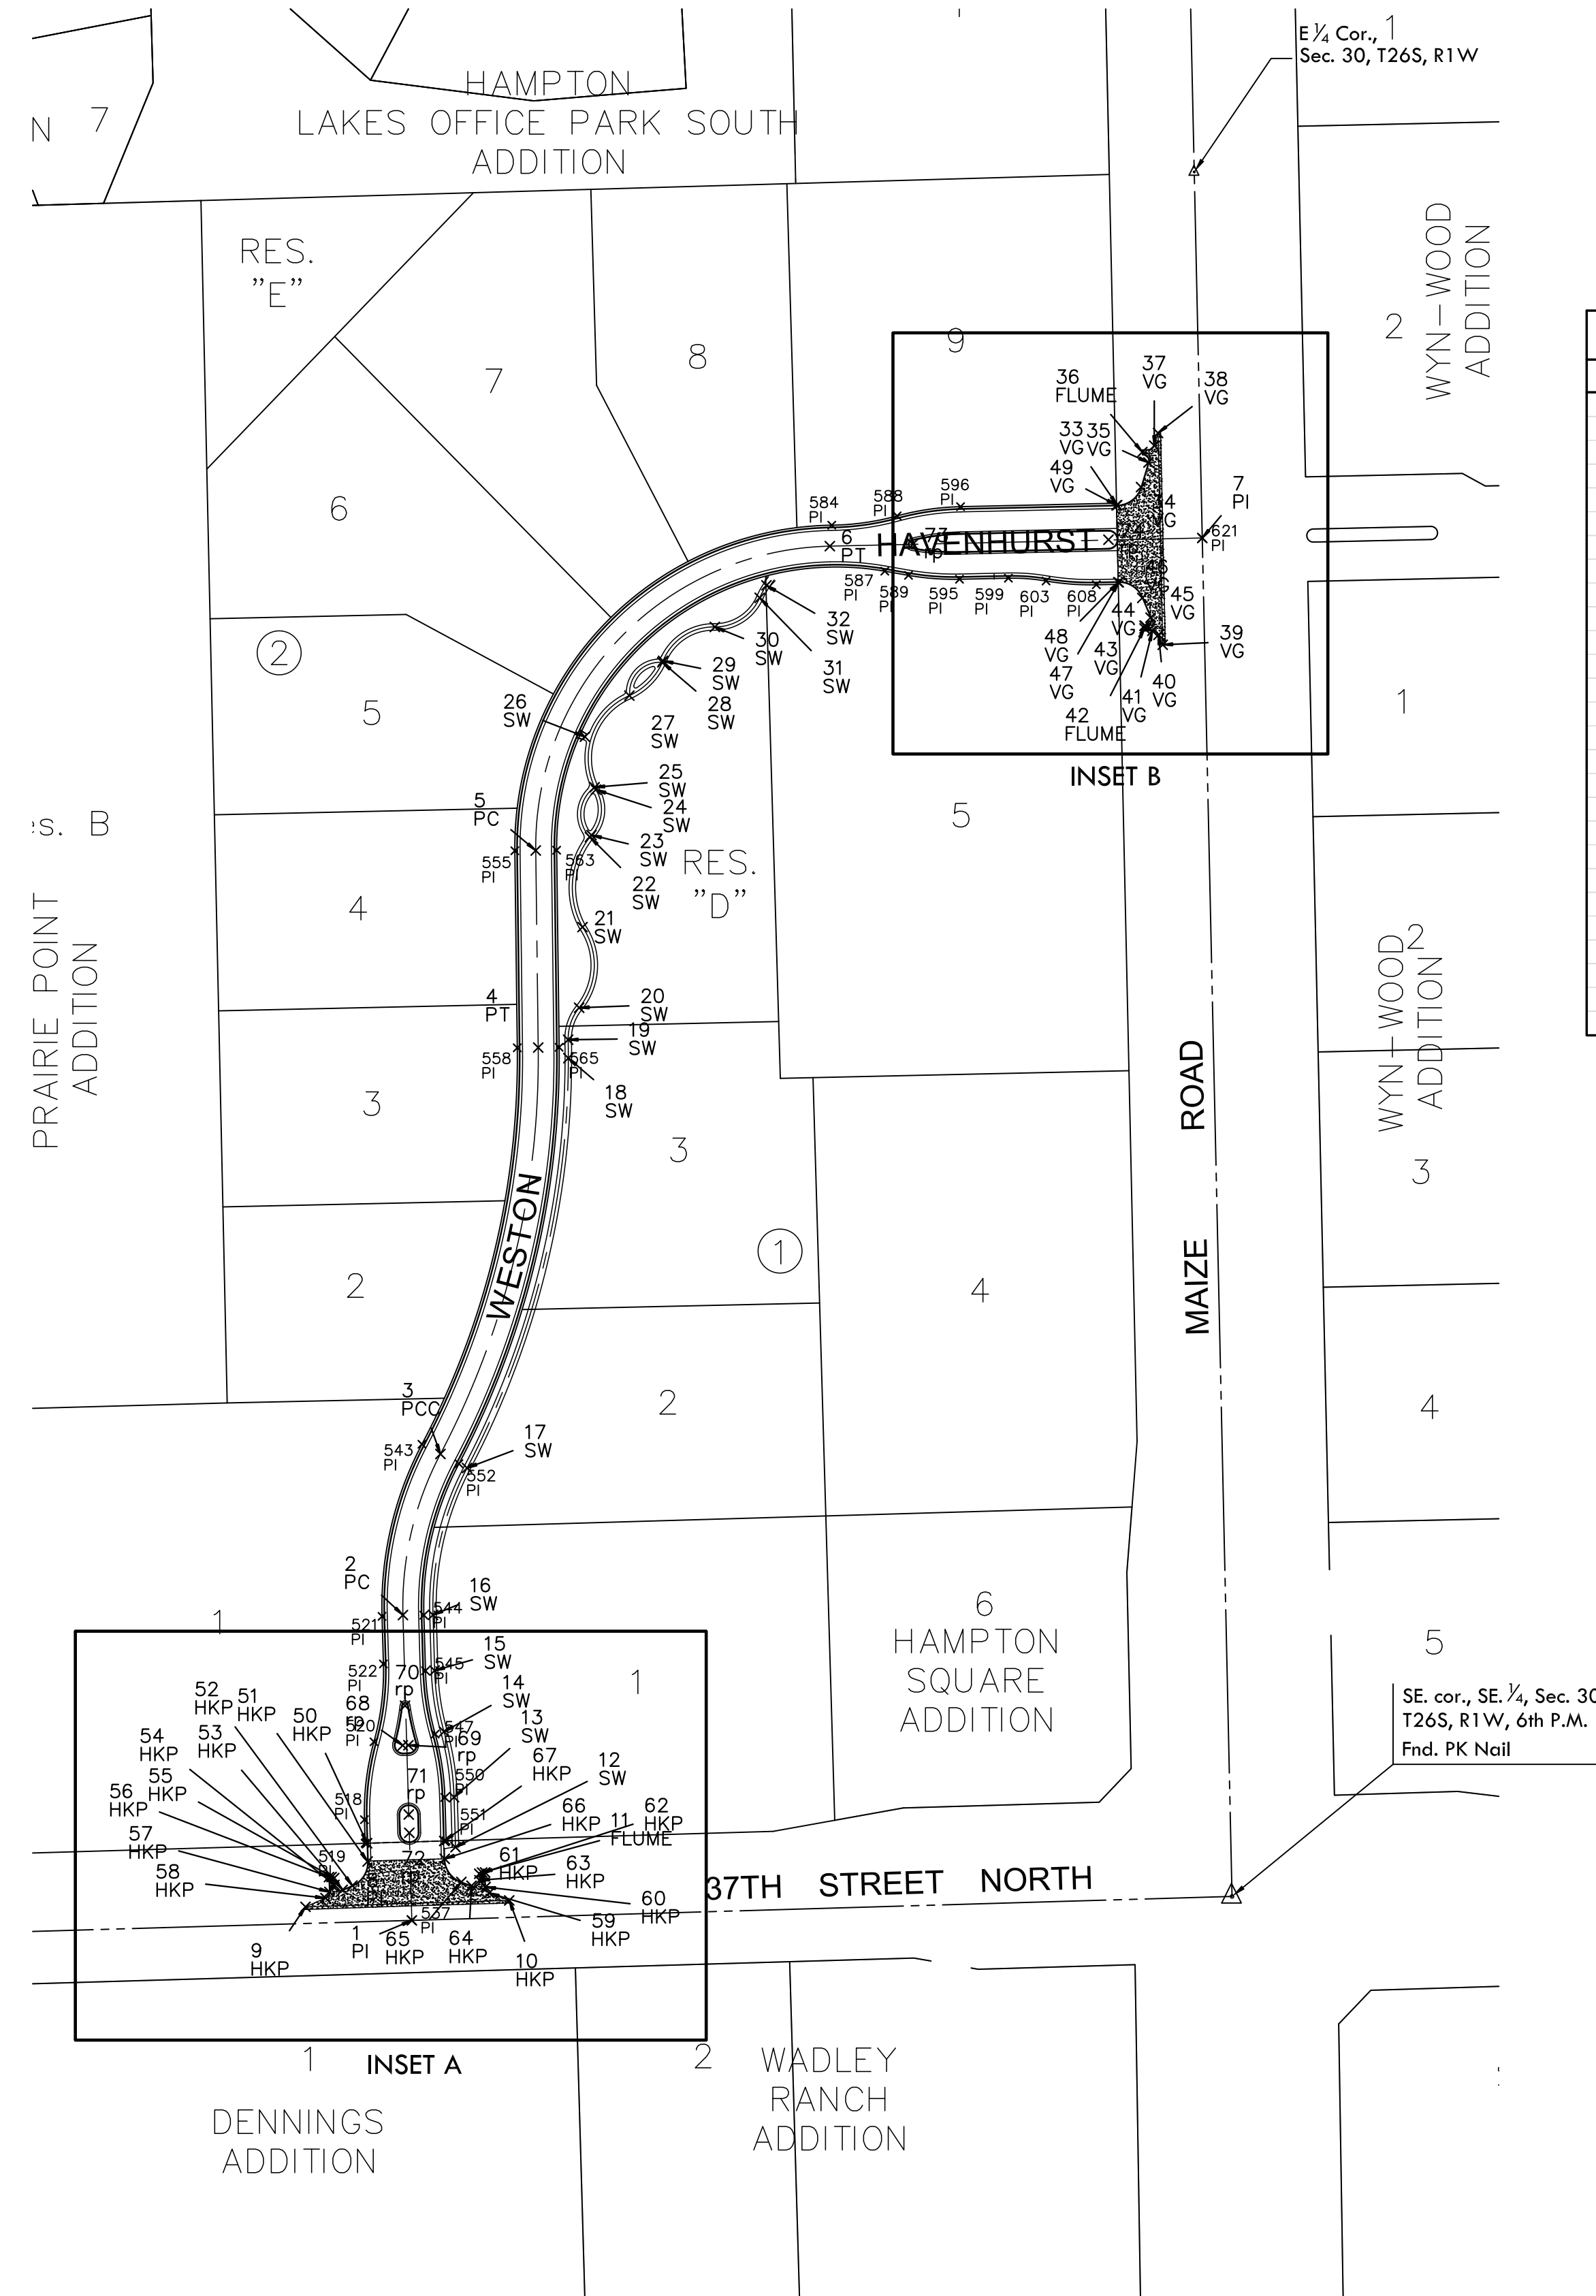

SCALE: 1"=100'

PLAT IRONS			
POINT #	NORTHING	EASTING	DESC.
518	1709346.61	1611701.95	PI
519	1709328.57	1611702.48	PI
520	1709406.17	1611709.22	PI
521	1709502.12	1611715.42	PI
522	1709465.73	1611716.48	PI
537	1709269.58	1611738.21	PI
543	1709633.79	1611745.93	PI
544	1709503.05	1611747.40	PI
545	1709460.47	1611748.65	PI
547	1709412.05	1611756.06	PI
550	1709363.62	1611763.48	PI
551	1709330.38	1611764.45	PI
552	1709618.89	1611774.24	PI
555	1710087.76	1611816.99	PI
558	1709937.03	1611818.87	PI
563	1710088.16	1611848.99	PI
565	1709937.43	1611850.87	PI
584	1710336.80	1612059.44	PI
587	1710301.60	1612100.01	PI
588	1710343.90	1612109.45	PI
589	1710298.41	1612118.15	PI
595	1710295.44	1612157.15	PI
596	1710350.97	1612157.95	PI
599	1710296.26	1612194.55	PI
603	1710294.10	1612223.37	PI
608	1710291.23	1612261.81	PI
621	1710327.01	1612342.84	PI

PAVING IRONS			
POINT #	NORTHING	EASTING	DESC.
1	1709269.57	1611738.23	PI
2	1709503.13	1611731.41	PC
3	1709626.33	1611760.11	PCC
4	1709937.22	1611834.89	PT
5	1710087.95	1611833.01	PC
6	1710320.76	1612057.96	PT
7	1710327.00	1612342.86	PI
8	1709302.73	1611676.83	PI
9	1709279.93	1611656.90	HKP
10	1709284.84	1611812.73	HKP
11	1709306.16	1611792.03	FLUME
12	1709325.57	1611771.63	SW
13	1709363.82	1611770.51	SW
14	1709413.94	1611762.83	SW
15	1709460.67	1611755.66	SW
16	1709503.24	1611754.42	SW
17	1709615.61	1611780.46	SW
18	1709929.12	1611857.94	SW
19	1709943.19	1611857.79	SW
20	1709967.67	1611866.21	SW
21	1710029.38	1611868.79	SW
22	1710098.25	1611874.43	SW
23	1710099.73	1611875.65	SW
24	1710134.46	1611879.01	SW
25	1710136.33	1611878.08	SW
26	1710174.98	1611870.60	SW
27	1710206.42	1611904.61	SW
28	1710231.85	1611929.88	SW
29	1710233.02	1611930.38	SW
30	1710258.95	1611970.03	SW
31	1710281.25	1612004.31	SW
32	1710290.78	1612009.49	SW
33	1710352.09	1612277.79	VG
34	1710365.95	1612296.03	VG
35	1710384.72	1612301.70	VG
36	1710392.74	1612297.01	FLUME
37	1710397.64	1612306.12	VG
38	1710407.28	1612309.03	VG
39	171045.32	1612312.58	VG
40	1710252.90	1612309.40	VG
41	1710255.96	1612304.68	VG
42	1710257.83	1612298.71	FLUME
43	1710259.82	1612298.66	VG
44	1710259.83	1612299.21	VG
45	1710266.08	1612303.32	VG
46	1710281.14	1612296.99	VG
47	1710293.09	1612279.01	VG
48	1710293.09	1612278.58	VG
49	1710352.08	1612277.29	VG
50	1709328.60	1611704.00	HKP
51	1709314.62	1611704.40	HKP
52	1709296.19	1611692.74	HKP
53	1709292.93	1611685.31	HKP
54	1709296.71	1611679.02	HKP
55	1709301.97	1611678.86	HKP
56	1709302.67	1611674.84	HKP
57	1709291.35	1611675.17	HKP
58	1709286.63	1611672.18	HKP
59	1709290.53	1611797.37	HKP
60	1709295.09	1611794.61	HKP
61	1709306.22	1611794.28	HKP
62	1709305.21	1611789.81	HKP
63	1709300.28	1611789.95	HKP
64	1709296.06	1611783.89	HKP
65	1709298.95	1611776.09	HKP
66	1709316.67	1611763.37	HKP
67	1709330.32	1611762.97	HKP
68	1709403.43	1611731.29	rp
69	1709403.55	1611735.60	rp
70	1709433.79	1611733.02	rp
71	1709350.54	1611735.87	rp
72	1709336.54	1611736.28	rp
73	1710322.19	1612121.46	rp
74	1710325.68	1612271.12	rp

BUBBLE MAP

SHEET TITLE
472-85001
PROJECT NUMBER

DFL / JWC / GJA
DESIGNED DRAWN CHECKED

ISSUED
November 2011

REVISED

SHEET NO.