STORM SEWER & DITCH INFORMATION TABLE		
Line No.	Sheet No.	Description
SWS Line 1	28–36, 48–50	SWS & DITCH
SWS Line 2	37	SWS
SWS Line 3	37	SWS
SWS Line 4	37	SWS
SWS Line 5	39	SWS
SWS Line 6	39	SWS
SWS Line 7	39	SWS
SWS Line 8	40	SWS
SWS Line 9	40	SWS
SWS Line 10	40	SWS
SWS Line 11	40	SWS
SWS Line 12	41	SWS
SWS Line 13	42	SWS
1 SWS Line 13B	42.001	SWS
SWS Line 14	42	SWS
SWS Line 15	43	SWS
SWS Line 16	43	SWS
SWS Line 17	44	SWS
SWS Line 18	45	SWS
SWS Line 19	45	SWS
SWS Line 20	46	SWS
SWS Line 21	46	SWS
SWS Line 22	44	SWS
SWS Line 23	47	SWS
SWS Line 24	47	SWS
SWS Line 25	47	SWS
SWS Line 26	47	SWS
SWS Line 27	48 – 50	DITCH and BOX CULVERT
SWS Line 28	51	SWS
SWS Line 29	51	SWS

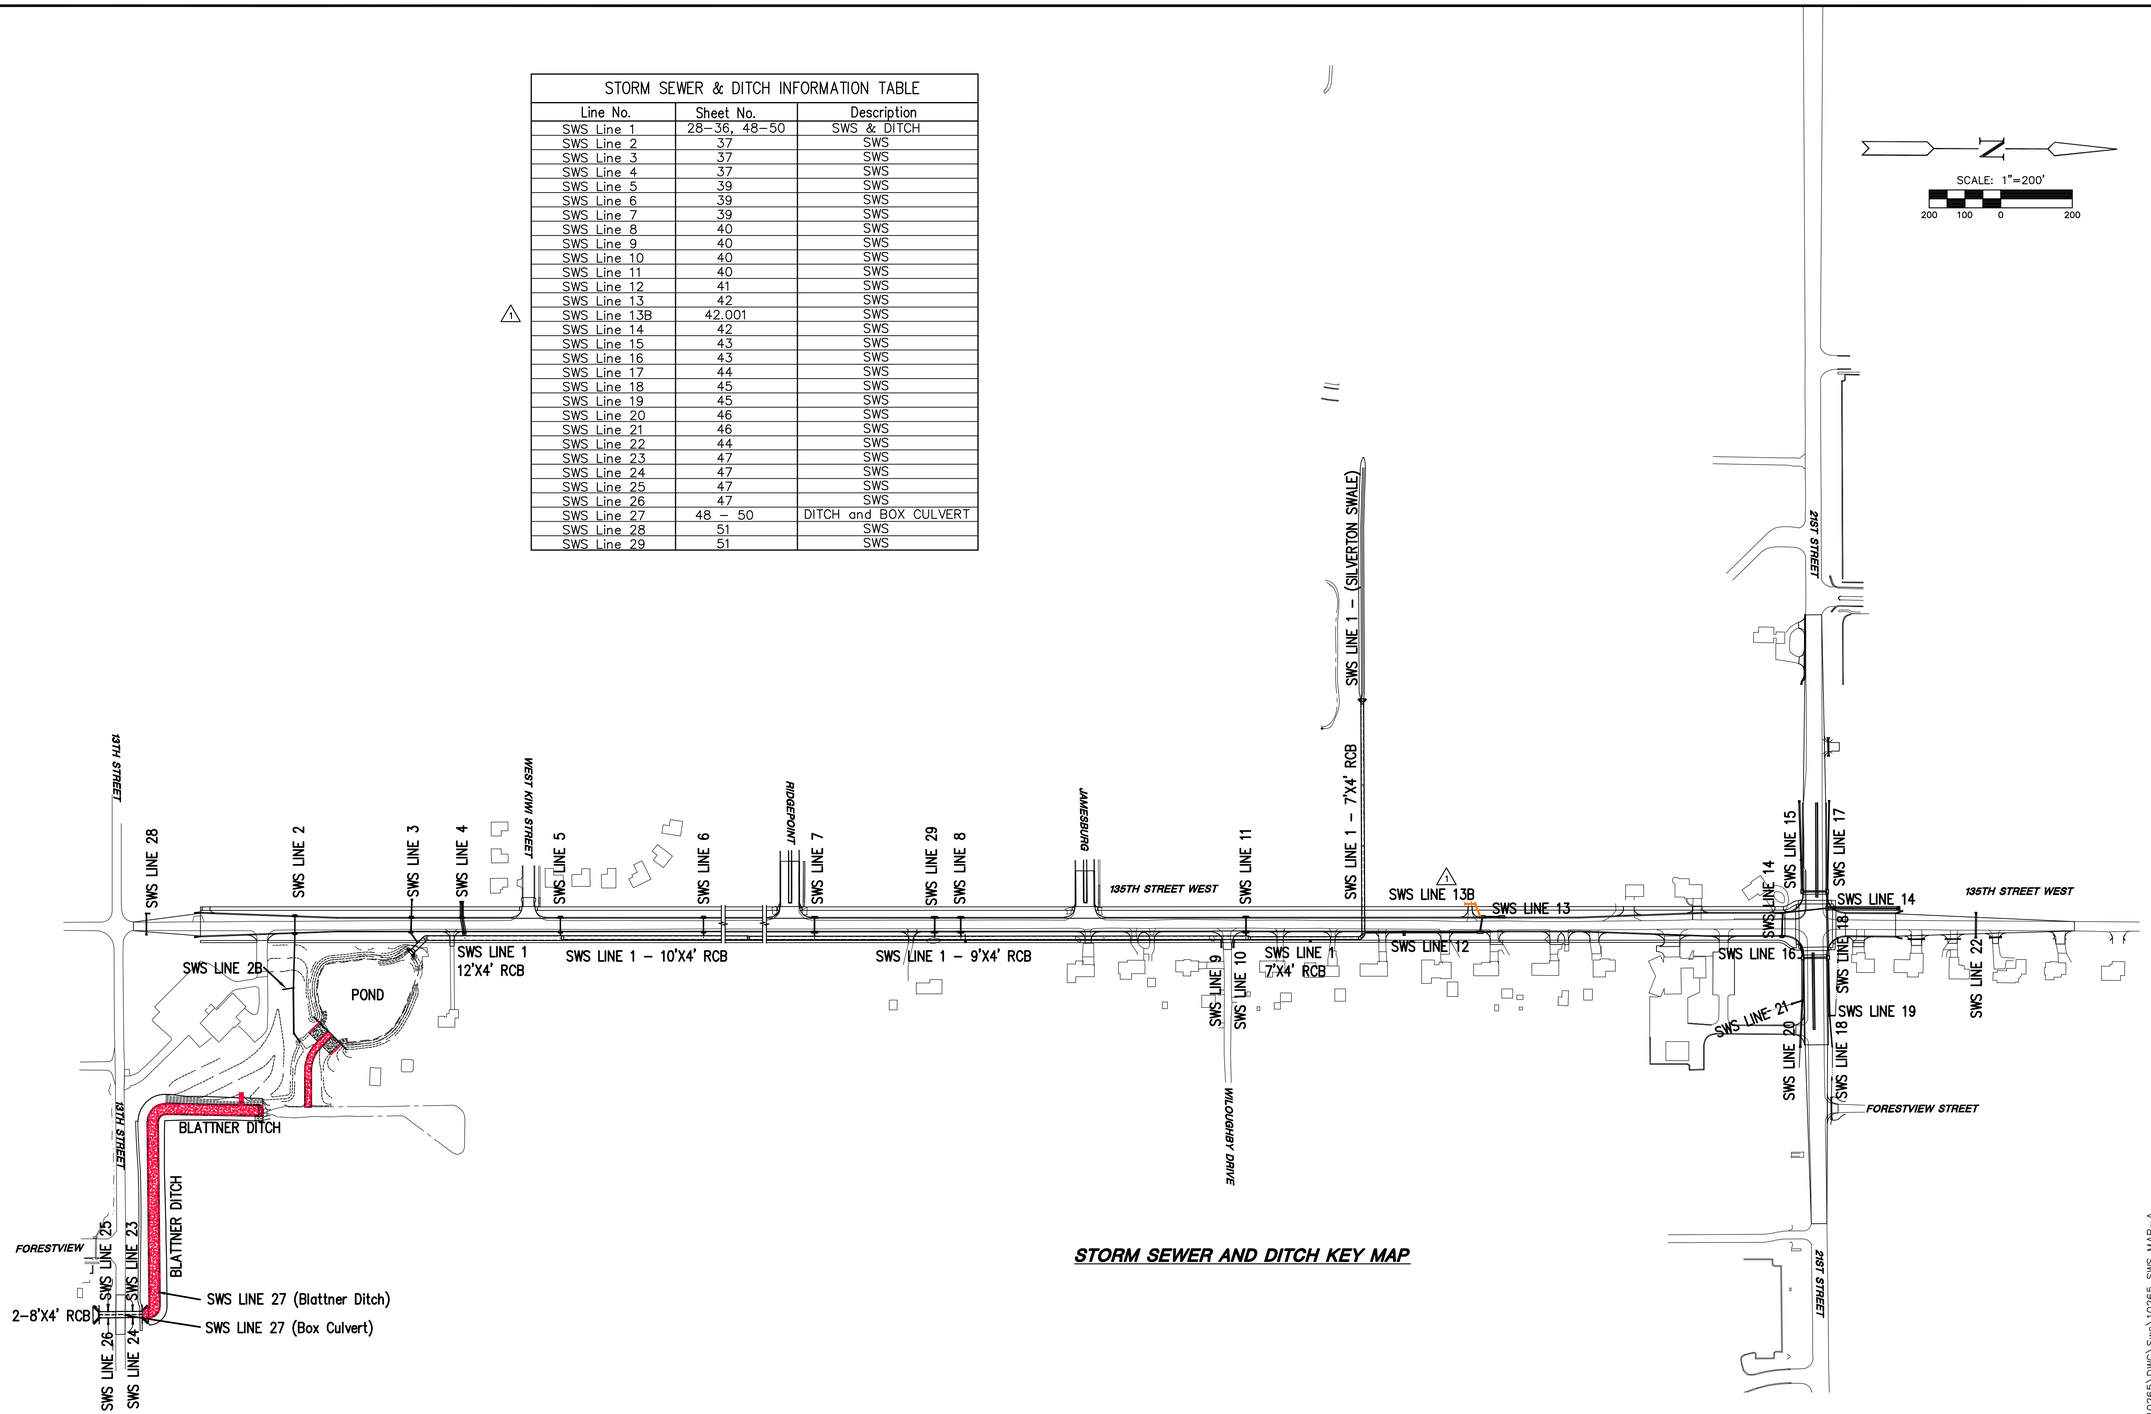

STORM SEWER AND DITCH KEY MAP

PLOTTED: Monday, March 12, 2012 @ 08:20AM

MKEC ENGINEERING CONSULTANTS, INC.
411 N. WEBB ROAD
WICHITA, KS. 67206
316 - 684 - 9600

JAY ANDLEY LICENSED KANSAS PROFESSIONAL ENGINEER

STREET IMPROVEMENTS FOR
135th Street West
from 13th Street to 21st Street North

STORM SEWER AND DITCH KEY MAP
SHEET TITLE

MKEC PROJ #10265
PROJECT NUMBER

JRA
DESIGN BY

WNJ
DRAWN BY

JRA
CHECKED BY

ISSUED
February 2012

REVISED
1 Added SWS Line 13B to Table

SHEET NO.
27R of 231

J:\Civil\10265\DWG\Sws\10265 SWS MAP-A