




STREET IMPROVEMENTS FOR
135th Street West
from 13th Street to 21st Street North

STORM SEWER
LINE 13B
SHEET TITLE
MKEC PROJ #10265
PROJECT NUMBER


DESIGN BY: JRA
DRAWN BY: WNU
CHECKED BY: JRA

ISSUED: February 2012
REVISED: Added SWS Line 13B

SHEET NO.
42.001 of 231

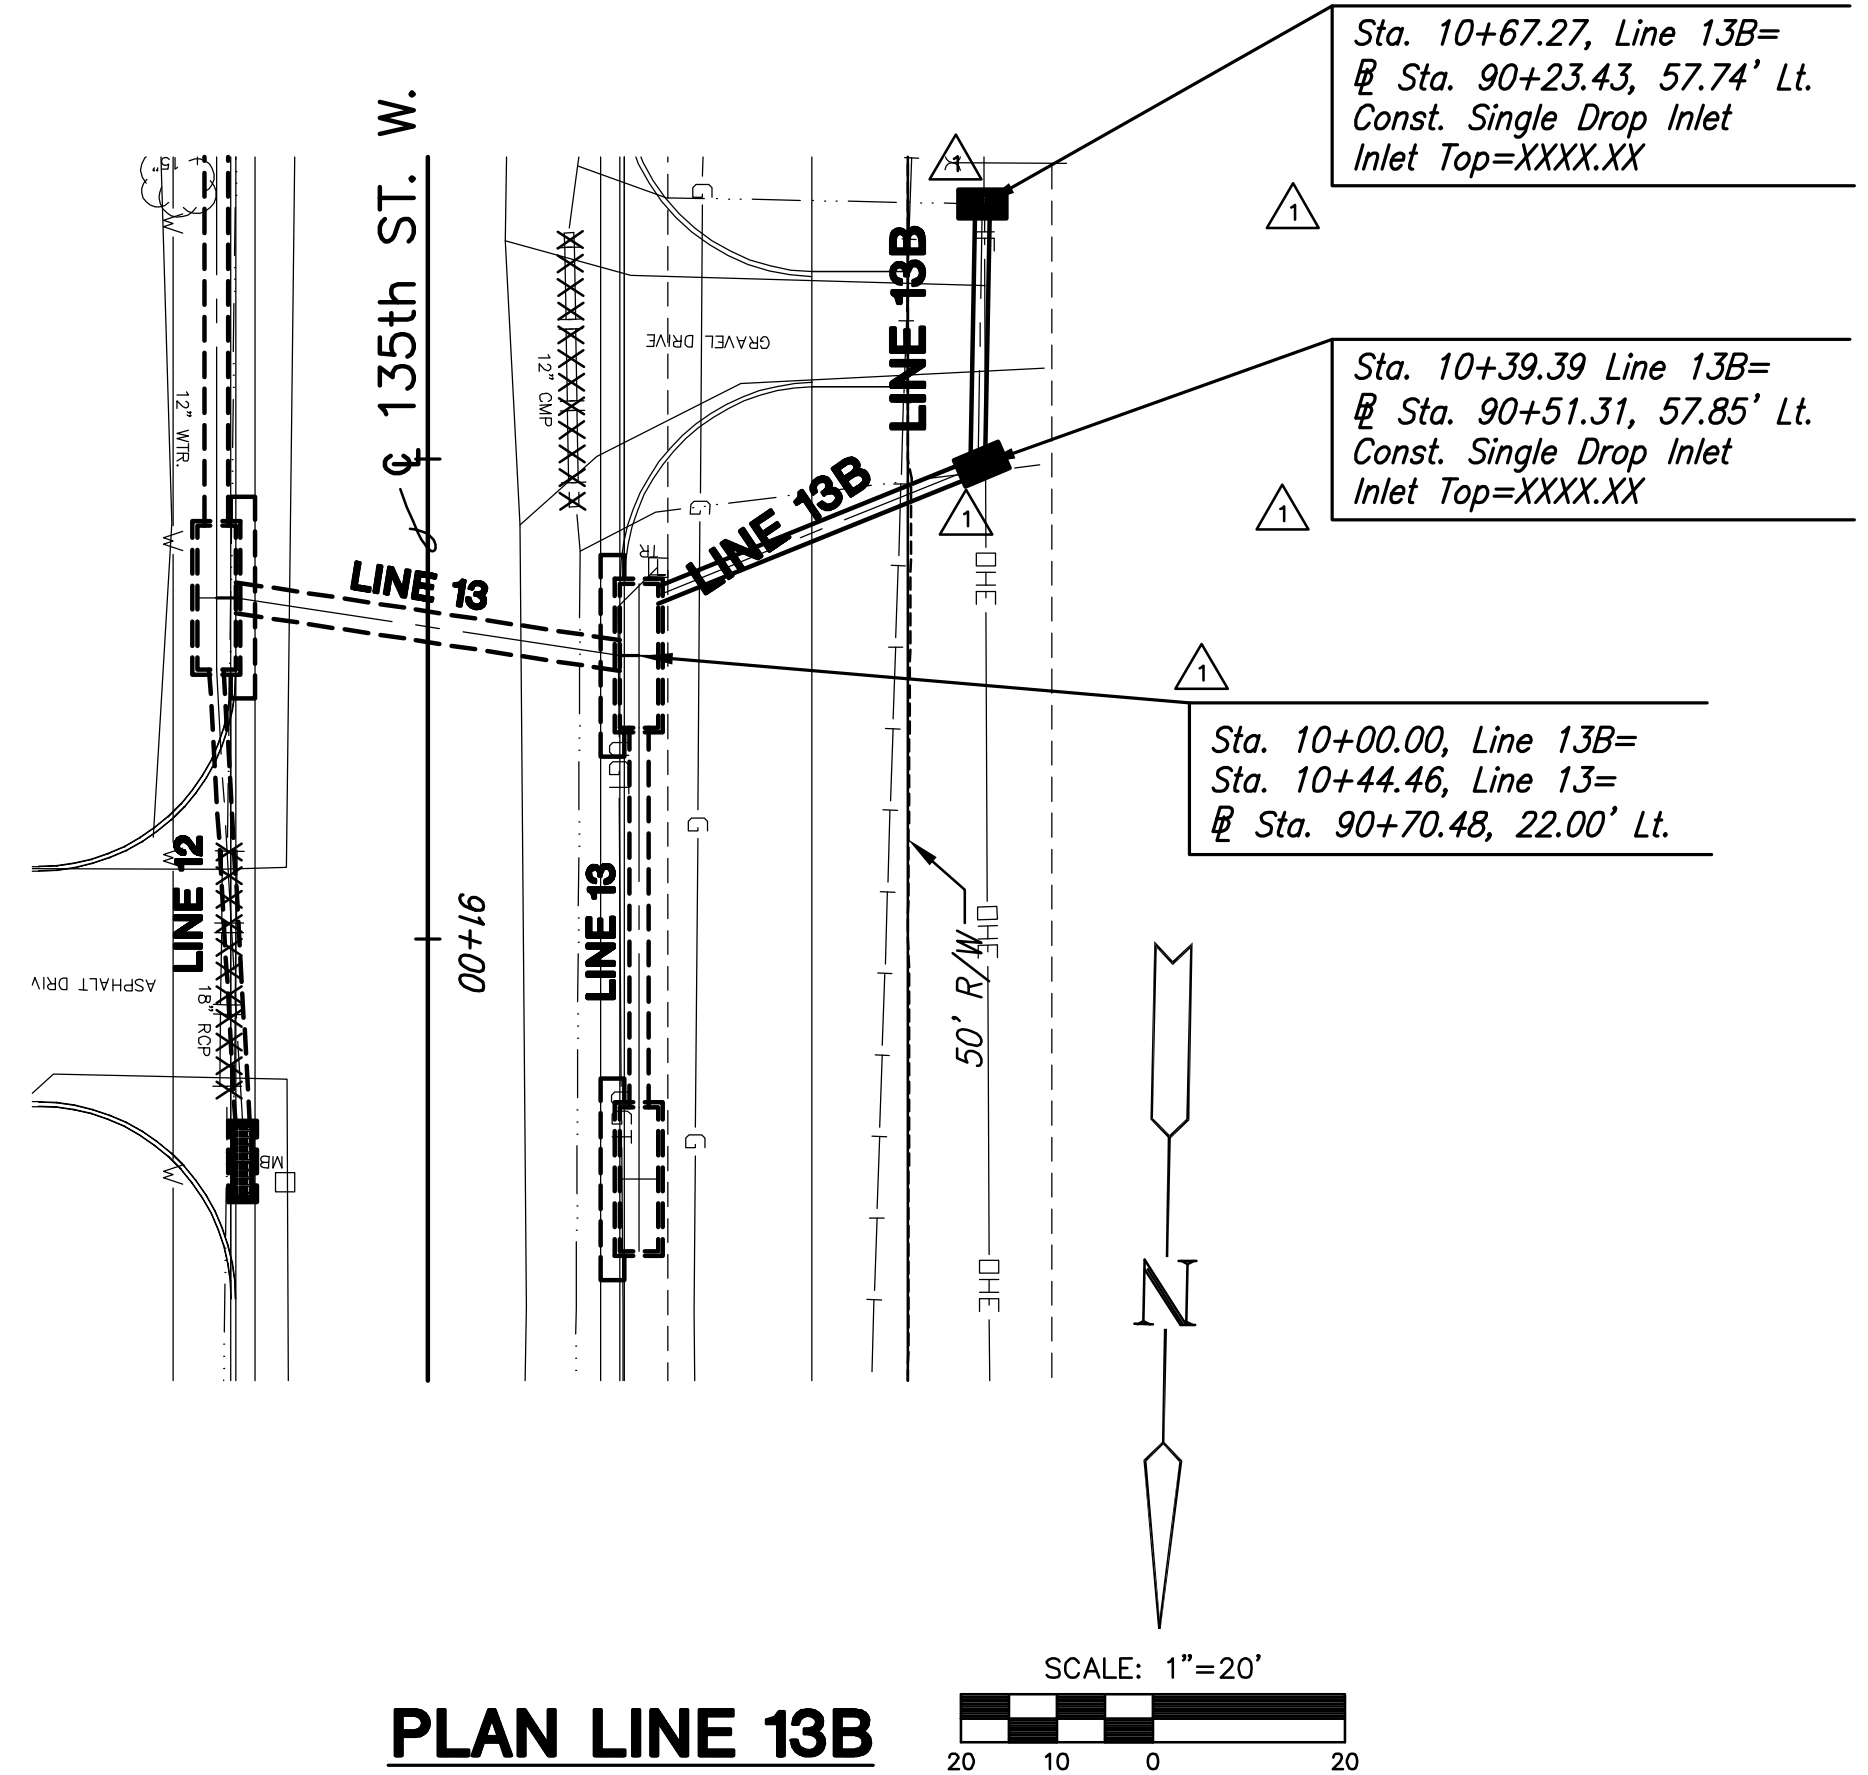

PROFILE LINE 13B

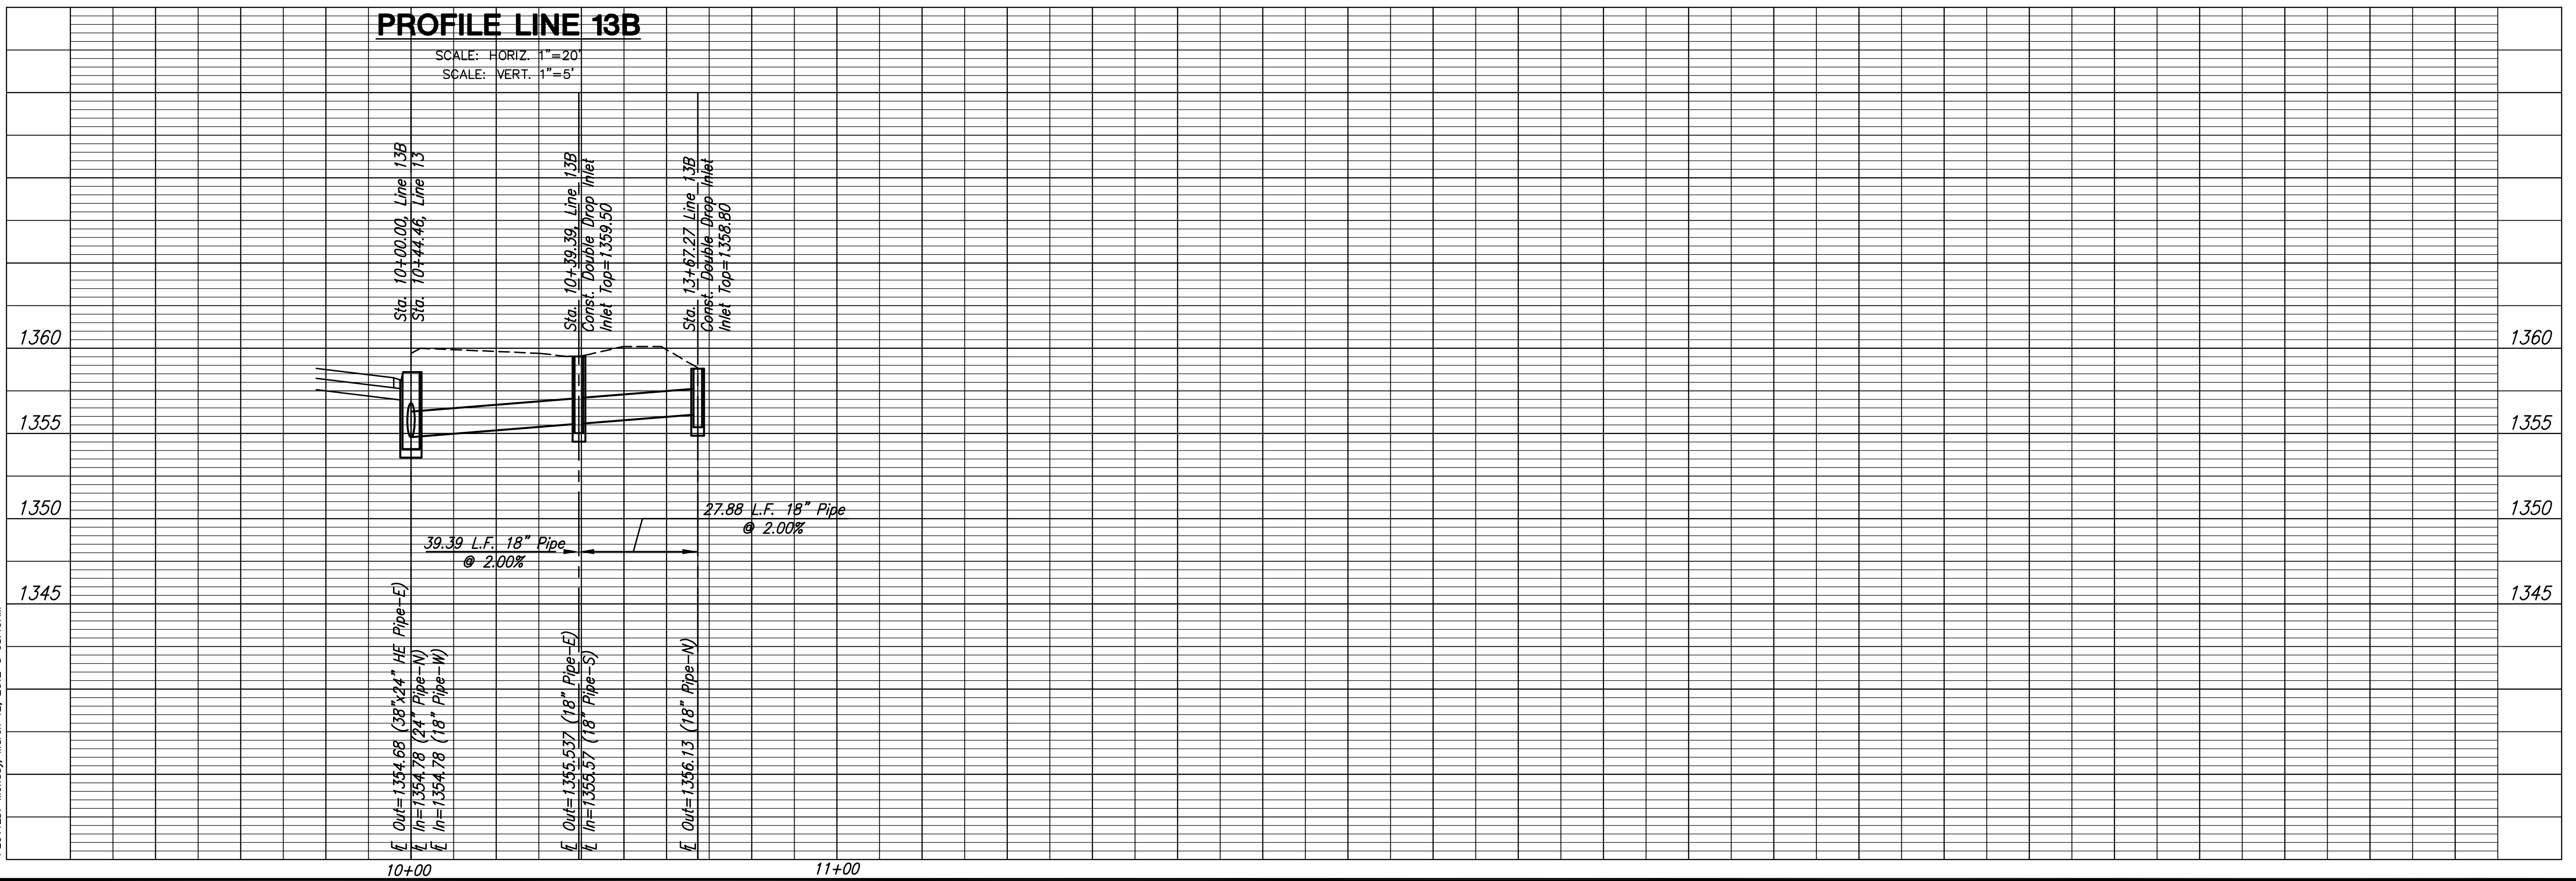

PLOTTED: Monday, March 12, 2012 @ 08:19AM

J:\Civil\10265\DWG\Sws\10265-D17a