
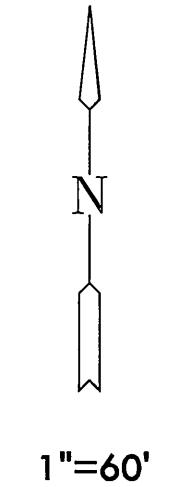


**WATER DISTRIBUTION SYSTEM  
KRUG SOUTH ADDITION  
PHASE 2**

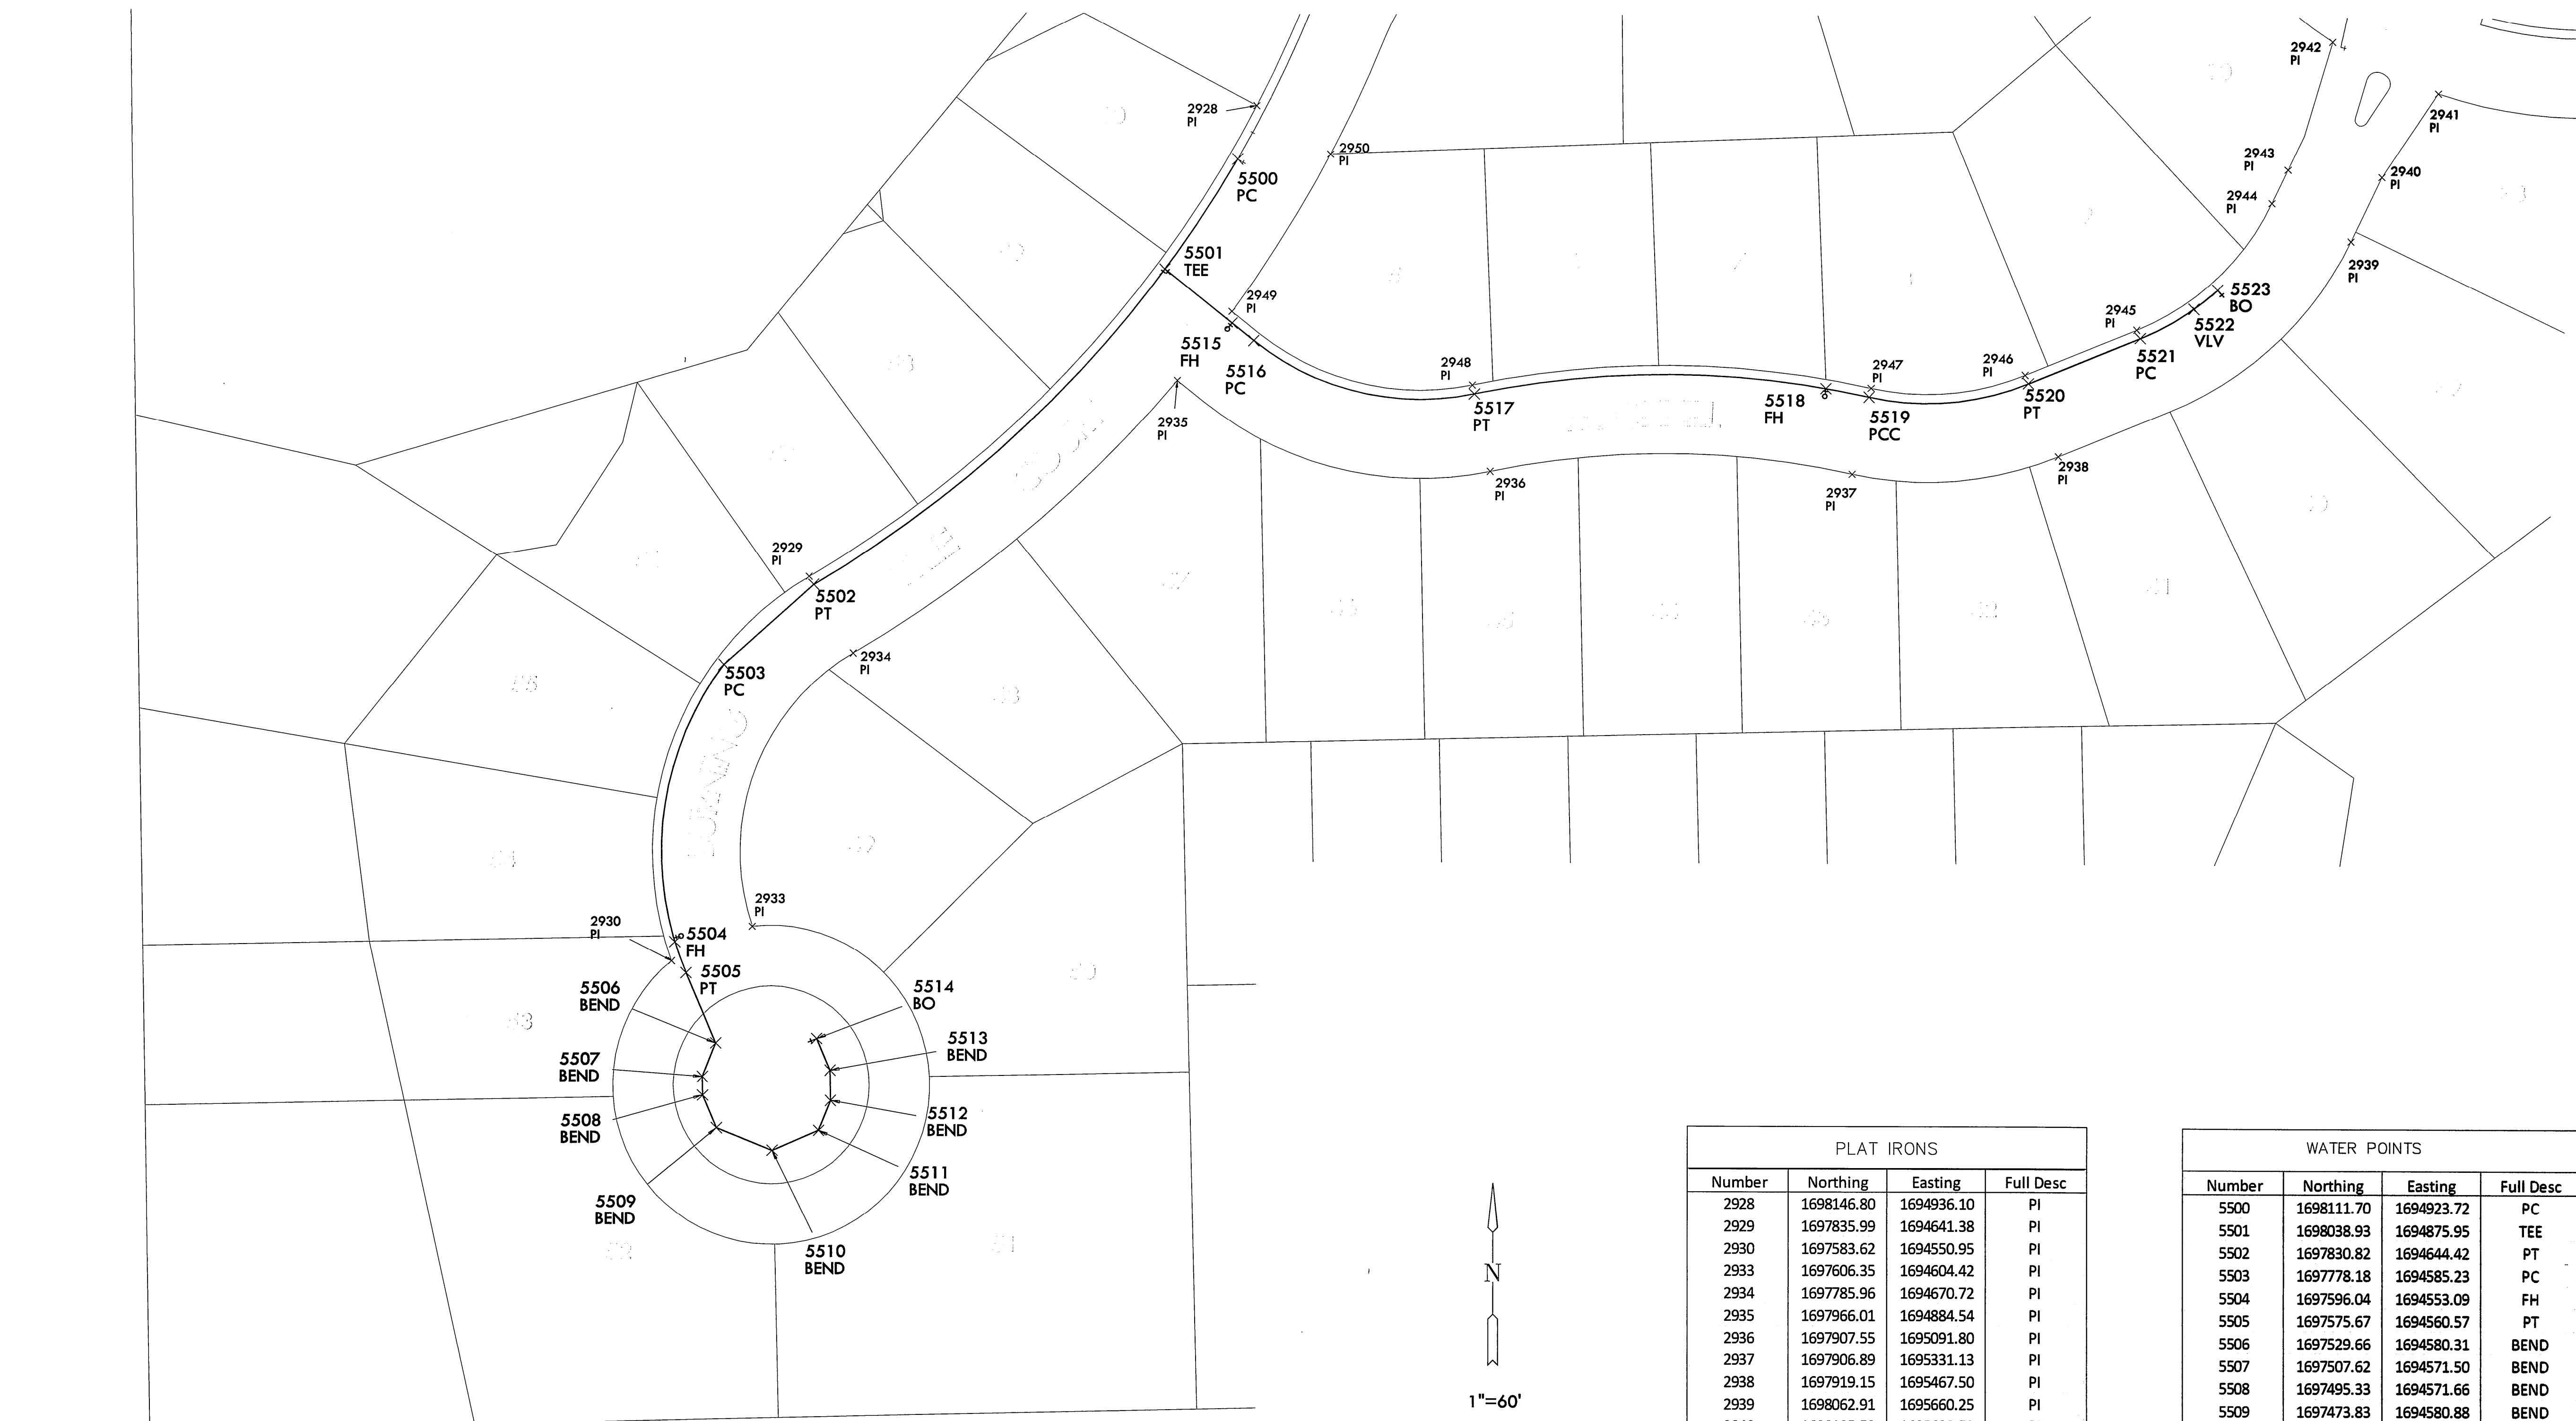

PLAT IRONS			
Number	Northing	Easting	Full Desc
2928	1698146.80	1694936.10	PI
2929	1697835.99	1694641.38	PI
2930	1697583.62	1694550.95	PI
2933	1697606.35	1694604.42	PI
2934	1697785.96	1694670.72	PI
2935	1697966.01	1694884.54	PI
2936	1697907.55	1695091.80	PI
2937	1697906.89	1695331.13	PI
2938	1697919.15	1695467.50	PI
2939	1698062.91	1695660.25	PI
2940	1698105.53	1695680.52	PI
2941	1698161.00	1695717.52	PI
2942	1698194.44	1695647.36	PI
2943	1698110.03	1695618.44	PI
2944	1698087.82	1695607.87	PI
2945	1698003.30	1695518.97	PI
2946	1697972.72	1695445.27	PI
2947	1697963.57	1695343.44	PI
2948	1697964.30	1695079.80	PI
2949	1698011.60	1694920.40	PI
2950	1698115.43	1694985.16	PI

WATER POINTS			
Number	Northing	Easting	Full Desc
5500	1698111.70	1694923.72	PC
5501	1698038.93	1694875.95	TEE
5502	1697830.82	1694644.42	PT
5503	1697778.18	1694585.23	PC
5504	1697596.04	1694553.09	FH
5505	1697575.67	1694560.57	PT
5506	1697529.66	1694580.31	BEND
5507	1697507.62	1694571.50	BEND
5508	1697495.33	1694571.66	BEND
5509	1697473.83	1694580.88	BEND
5510	1697459.12	1694617.70	BEND
5511	1697472.36	1694648.55	BEND
5512	1697492.00	1694656.39	BEND
5513	1697512.01	1694656.14	BEND
5514	1697532.91	1694647.17	BO
5515	1698003.91	1694920.47	FH
5516	1697992.48	1694935.00	PC
5517	1697958.43	1695081.04	PT
5518	1697963.23	1695313.51	FH
5519	1697957.70	1695342.17	PCC
5520	1697967.18	1695447.57	PT
5521	1697997.75	1695521.27	PC
5522	1698017.54	1695556.78	VLV
5523	1698030.12	1695572.33	BO

PLOTED: Tuesday, April 03, 2012 @ 12:05PM

J:\CIVIL\05291\DWG\WTR\PH\_2\BUBBLE.DWG

**BUBBLE MAP**  
SHEET TITLE  
448-90278  
PROJECT NUMBER

DFL, KKL, GJA  
DESIGNED DRAWN CHECKED

ISSUED  
April 2012

REVISED

SHEET NO.  
5 of 13