


NOTE:  
 \* THESE ITEMS TO FURNISHED AND INSTALLED BY THE DEPT. OF WATER AND SEWER. THE CONTRACTOR SHALL REIMBURSE THE DEPT. FOR ALL COSTS OF THE TAP.

NOTE:  
 FIELD ADJUST WATERLINE A MINIMUM OF 2' CLEAR FROM RELOCATED GAS LINE.


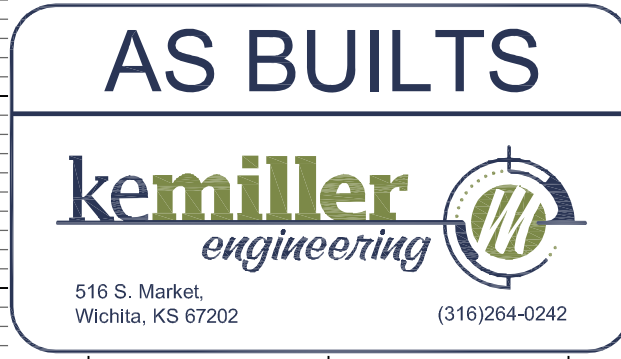

Ruggles & Bolm, P.A.  
 Engineering, Surveying, Land Planning  
 516 S. Market, Wichita, Kansas 67202  
 (316) 264-0242  
 www.rugglesbolm.com

REVISIONS  
 DATE REVIEW  
 Mar. 30, 2011  
 PROJECT NUMBER: 1616 PPW  
 DRAWING FILE: ENG BASE (PPW P&P)  
 DESIGN: BT  
 UTILITY  
 LAWRENCE ELEMENTARY SCHOOL  
 WATERLINE PLAN - PROFILE  
 WICHITA, KANSAS  
 RB JOB: 3763E  
 SHEET: C1.12  
 OF: X