


Apartment

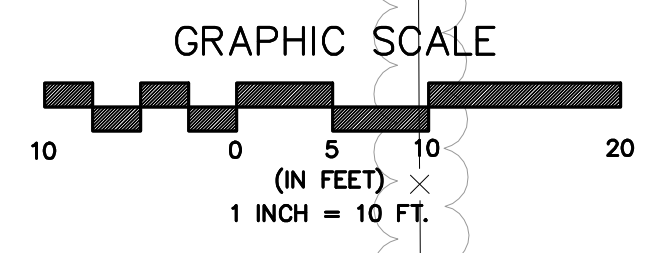

Construct 5' Concrete Transition as Necessary See Sht. No. 3

Construct Sidewalk Ramps (4 Loc.) See Sht. No. 90,145

Sta. 1+37.75 BEGIN CONSTRUCTION

Construct 6" Reinforced Concrete See Sht. No. 3

Construct 5' Asphalt Transition as Necessary See Sht. No. 3


Construct 6" Bituminous See Sht. No. 3

13TH STREET

VOLUTSIA AVE

13th STREET NORTH FROM HYDRAULIC TO OLIVER STREET & DRAINAGE IMPROVEMENTS
Volutsia Avenue
CITY OF WICHITA, KANSAS
JAMES L. ARMOUR, P.E. - CITY ENGINEER

POE & ASSOCIATES, INC.
CONSULTING ENGINEERS
5940 E. Central, Suite 200 • Wichita, KS 67208-4242
Phone 316/685-4111 • FAX 316/685-4444

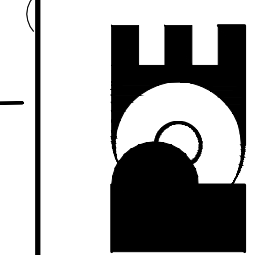

FINAL
Designed By: PAF / JUU
Drawn By: JUU
Poe Job No.: 1871A
Date: July 2008

