FOR CONSTRUCTION

AS BUILTS
kemiller engineering
516 S. Market,
Wichita, KS 67202
(316)264-0242

MKEC ENGINEERING CONSULTANTS, INC.
411 N. WEBB ROAD
WICHITA, KS. 67206
316 - 684 - 9600

COLEMAN JOSEPH KOCH LICENSED 20816 KANSAS PROFESSIONAL ENGINEER 6-26-12

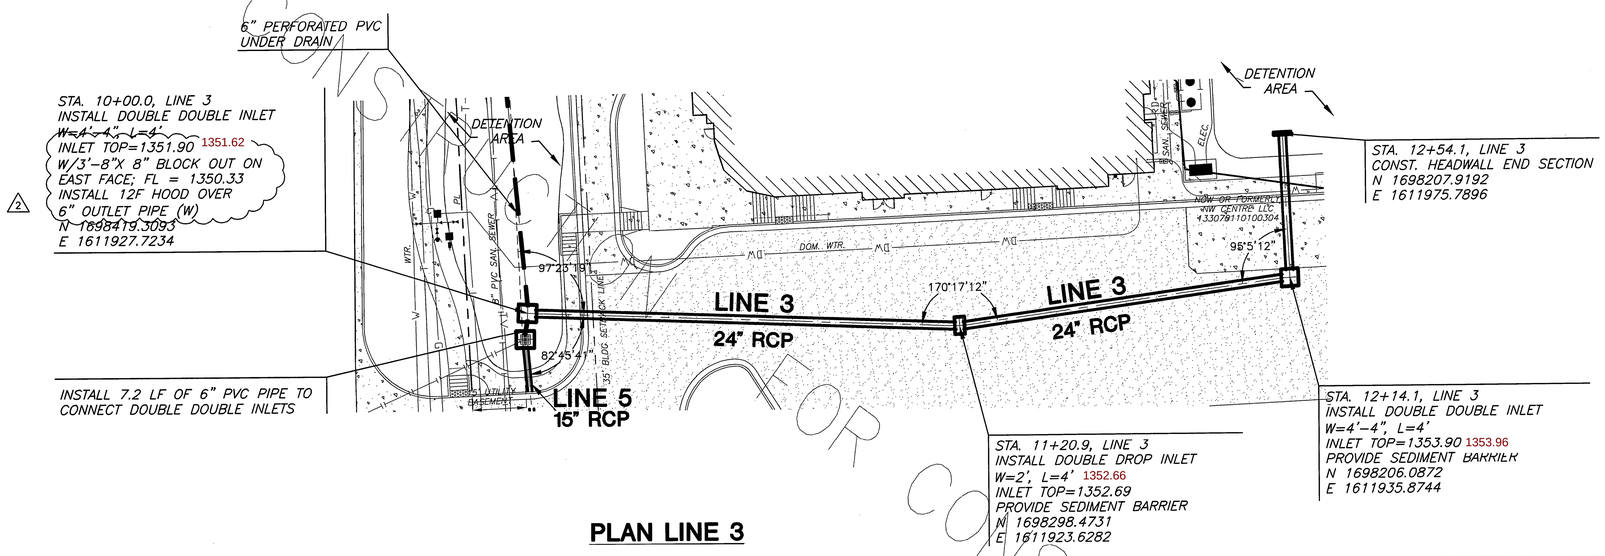

PLAN LINE 3

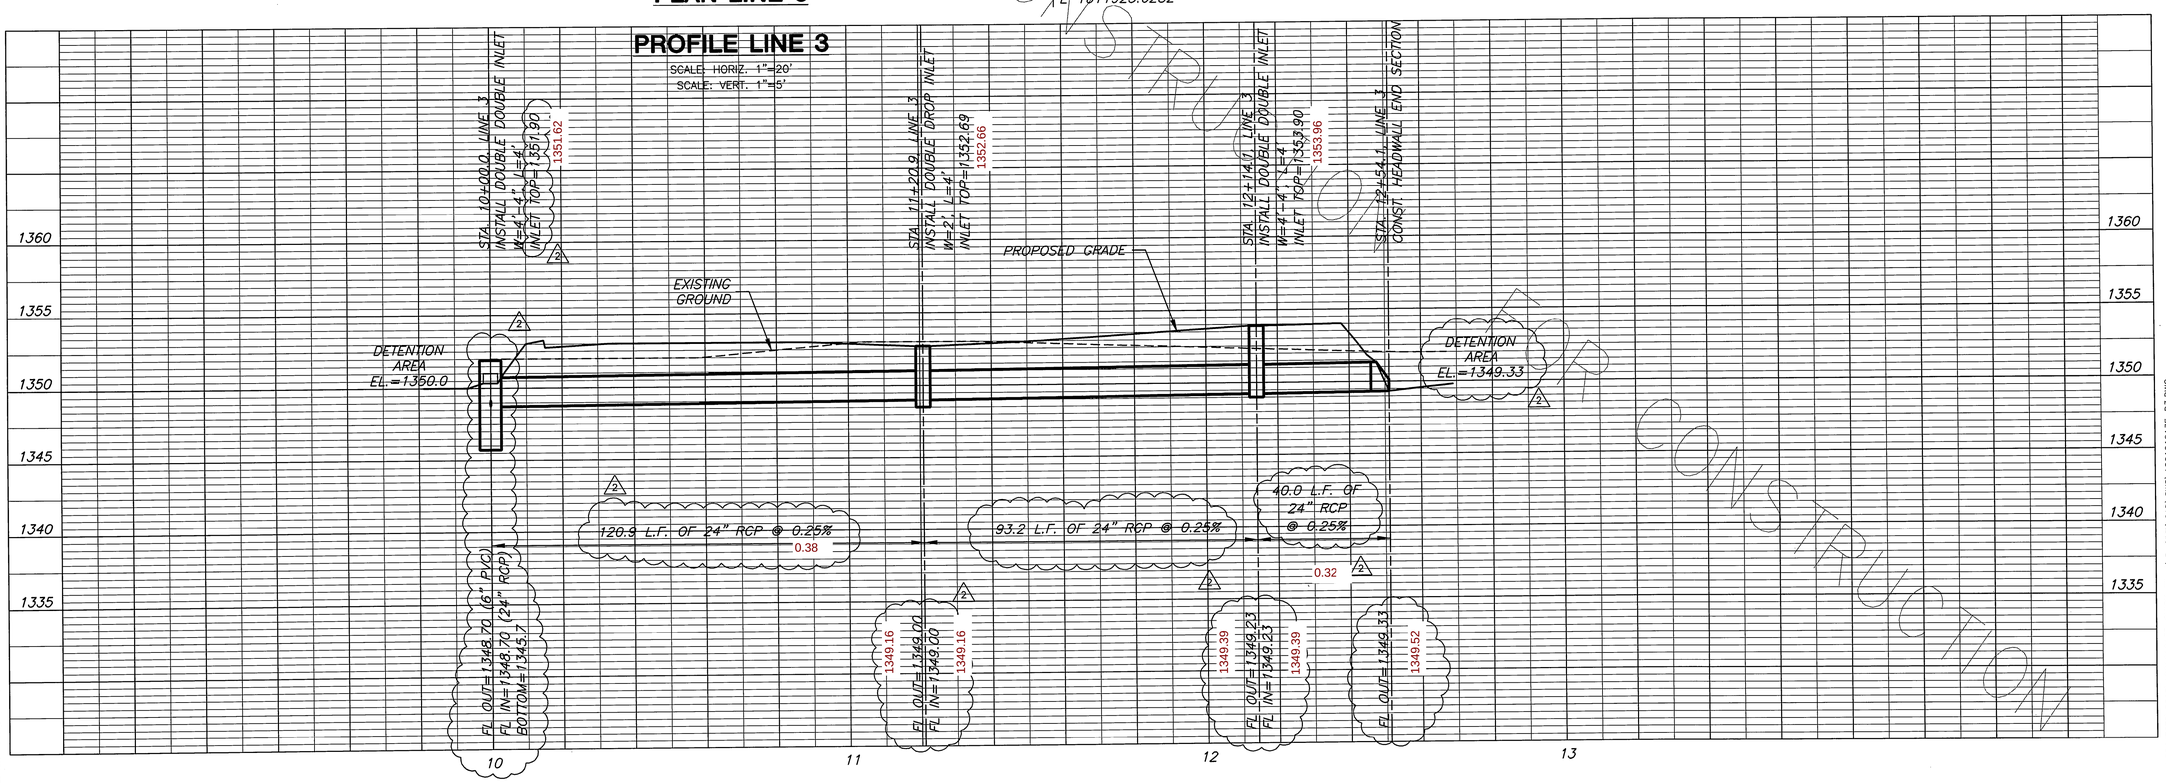

FOR CONSTRUCTION

STORM WATER SEWER PLANS FOR
CHICK-FIL-A
WICHITA, KANSAS

LINE 3
SHEET TITLE
1201010135
PROJECT NUMBER

AJK / DM / GJA
DESIGNED DRAWN CHECKED

ISSUED
March 2012
REVISED
1 4-17-2012
2 4-26-2012

SHEET NO.
8 of 14

J:\PROJECTS\2012\1201010135_CHICK_FIL_A\5-CIVIL\CAD\SWS\1201010135_D3.DWG

PLOTTED: Thursday, April 26, 2012 @ 03:49PM