




SEWER SERVICE TABLE

NUMBER	TYPE	LOCATION				FOR INFORMATION ONLY	
		LOT NO.	BLOCK NO.	LINE NO.	STATION \ DIRECTION	APPROXIMATE LENGTH 4" PIPE VERTICAL	HORIZONTAL
1	8" X 4" Tee Saddle	10	3	1	0+70/Rt.	10.0'	7.0'
2	8" X 4" Tee Saddle	9	3	1	1+74/Rt.	10.0'	7.0'
3	8" X 4" Tee Saddle	8	3	1	2+95/Rt.	10.0'	7.0'
4	8" X 4" Tee Saddle	7	3	1	3+75/Rt.	10.0'	7.0'
5	8" X 4" Tee Saddle	6	3	1	4+50/Rt.	10.0'	7.0'
6	8" X 4" Tee Saddle	23	3	1	7+05/Lt.	10.0'	7.0'
7	8" X 4" Tee Saddle	24	3	1	8+05/Lt.	10.0'	7.0'

NOTE: Vertical Riser Pipe shall be extended to 2' minimum above ground water elevation and 4' maximum below proposed ground elevation.

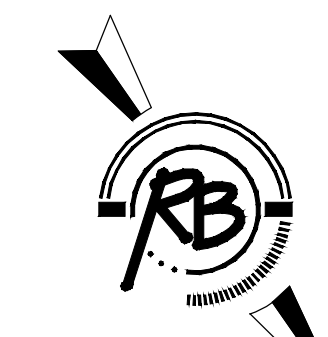

Unplatted

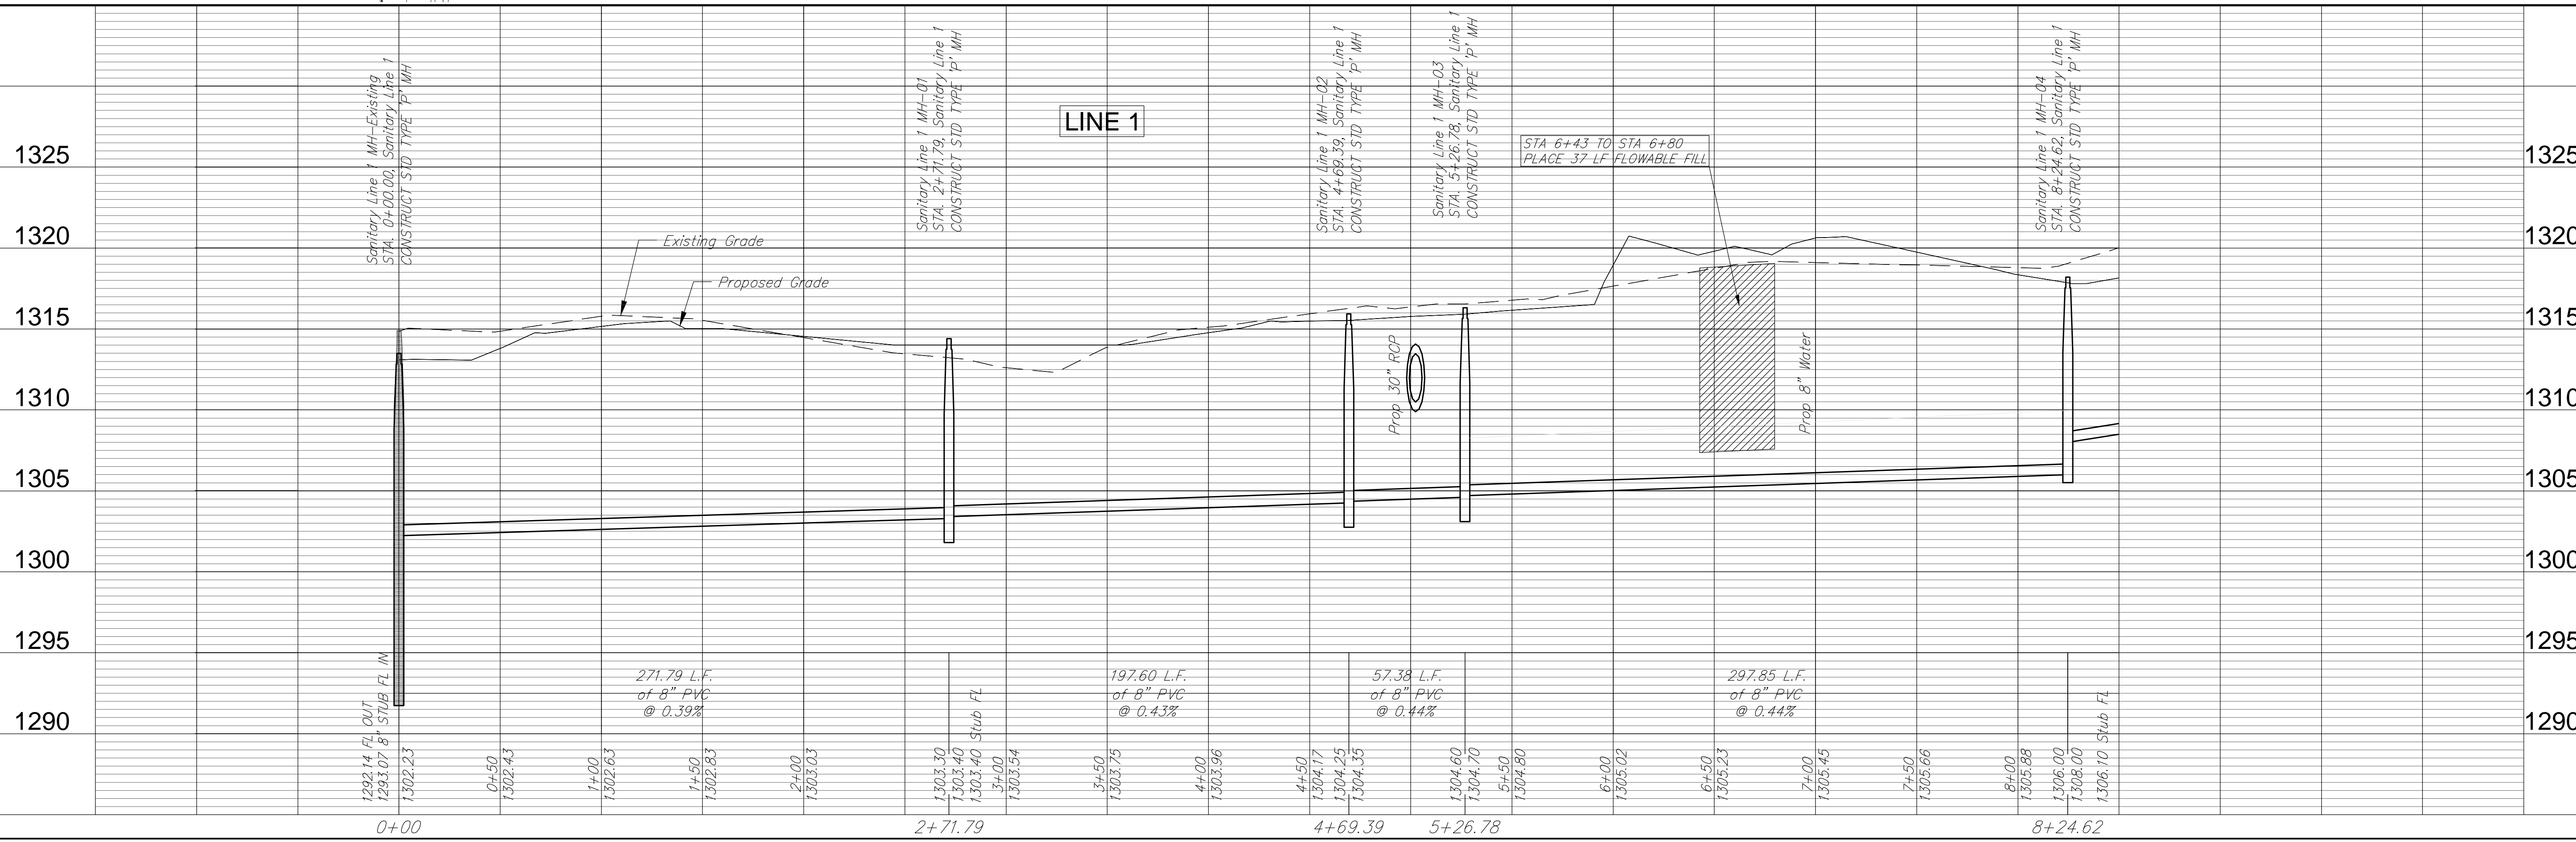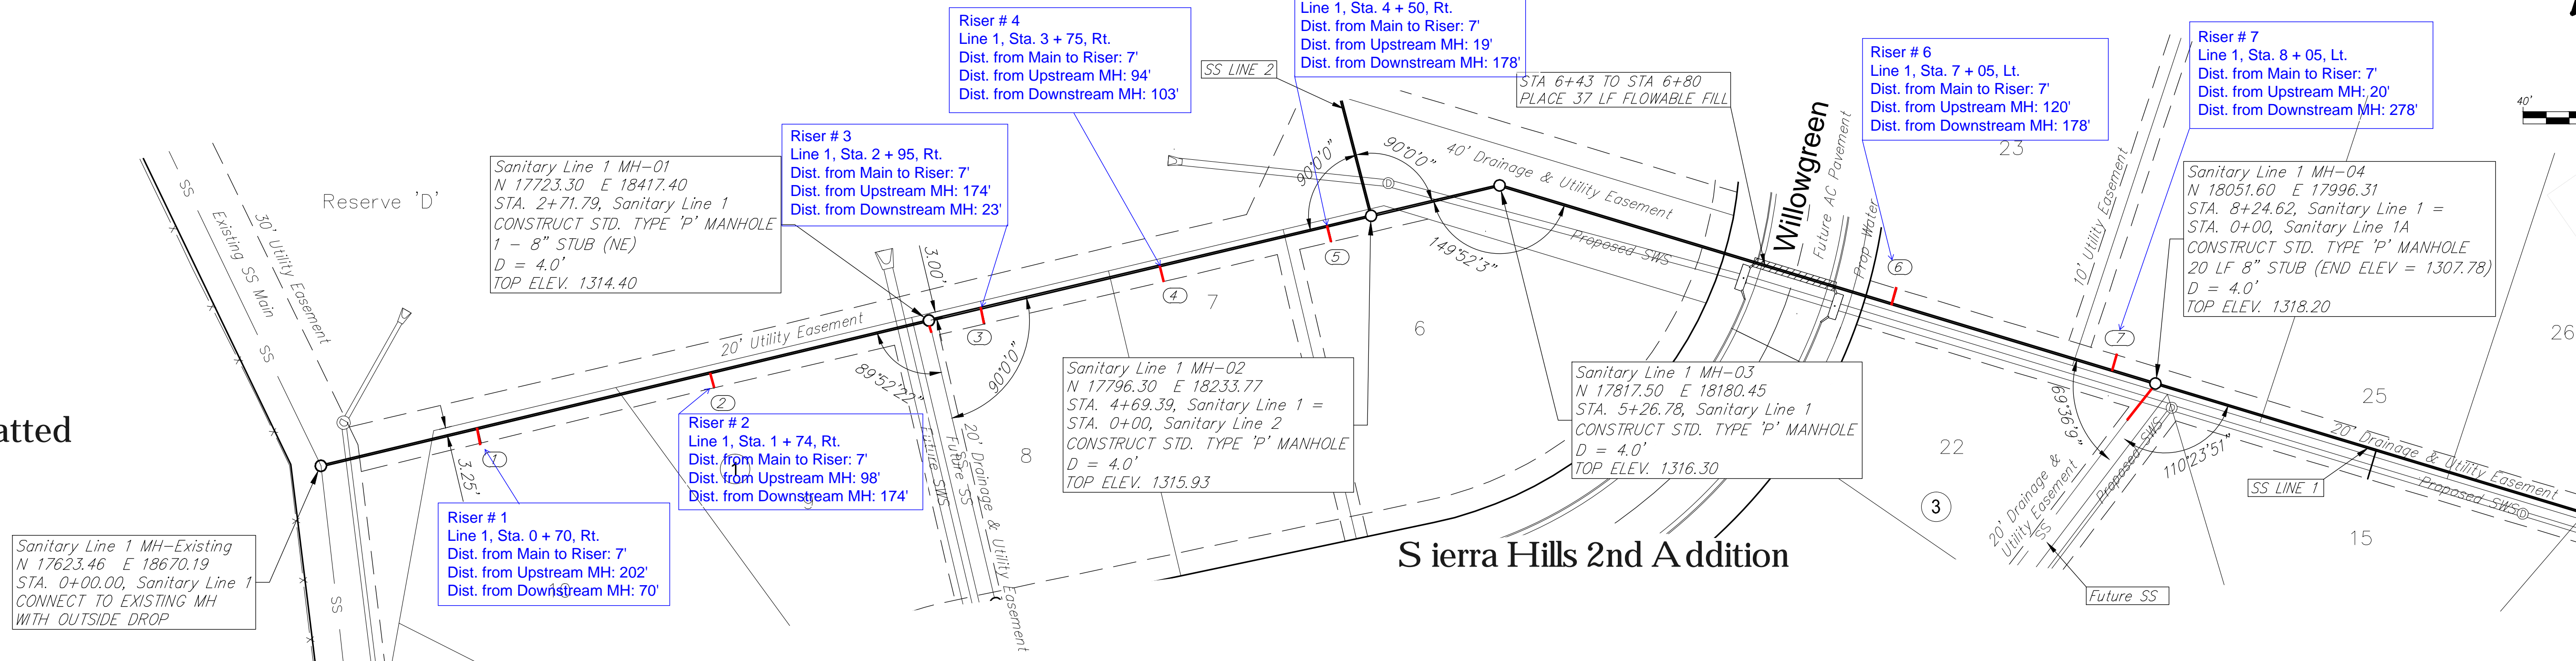

Ruggles & Bohm, P.A.
Engineering & Surveying, Land Planning
100 North Main Street, Suite 200
Wichita, Kansas 67202
www.rugglesandbohm.com
Email: info@rugglesandbohm.com

PROJECT NUMBER: 468-6684
DRAWING FILE: SS [SS Line 1]
DESIGN: EUG
DRAWN: EUG
REVISION: REVIEW
DATE: April 24, 2012
REVIEW: Feb 21, 2012
RIB JOB: 3929E
SHEET: 2 of 13
Sanitary Sewer Line 1
WICHITA, KANSAS