


**NOTE:**  
CONTRACTOR TO VERIFY THE  
DEPTH AND LOCATION OF EXISTING  
UTILITIES PRIOR TO CONSTRUCTION.

**PLAN LINE 1  
PROFILE LINE 1**

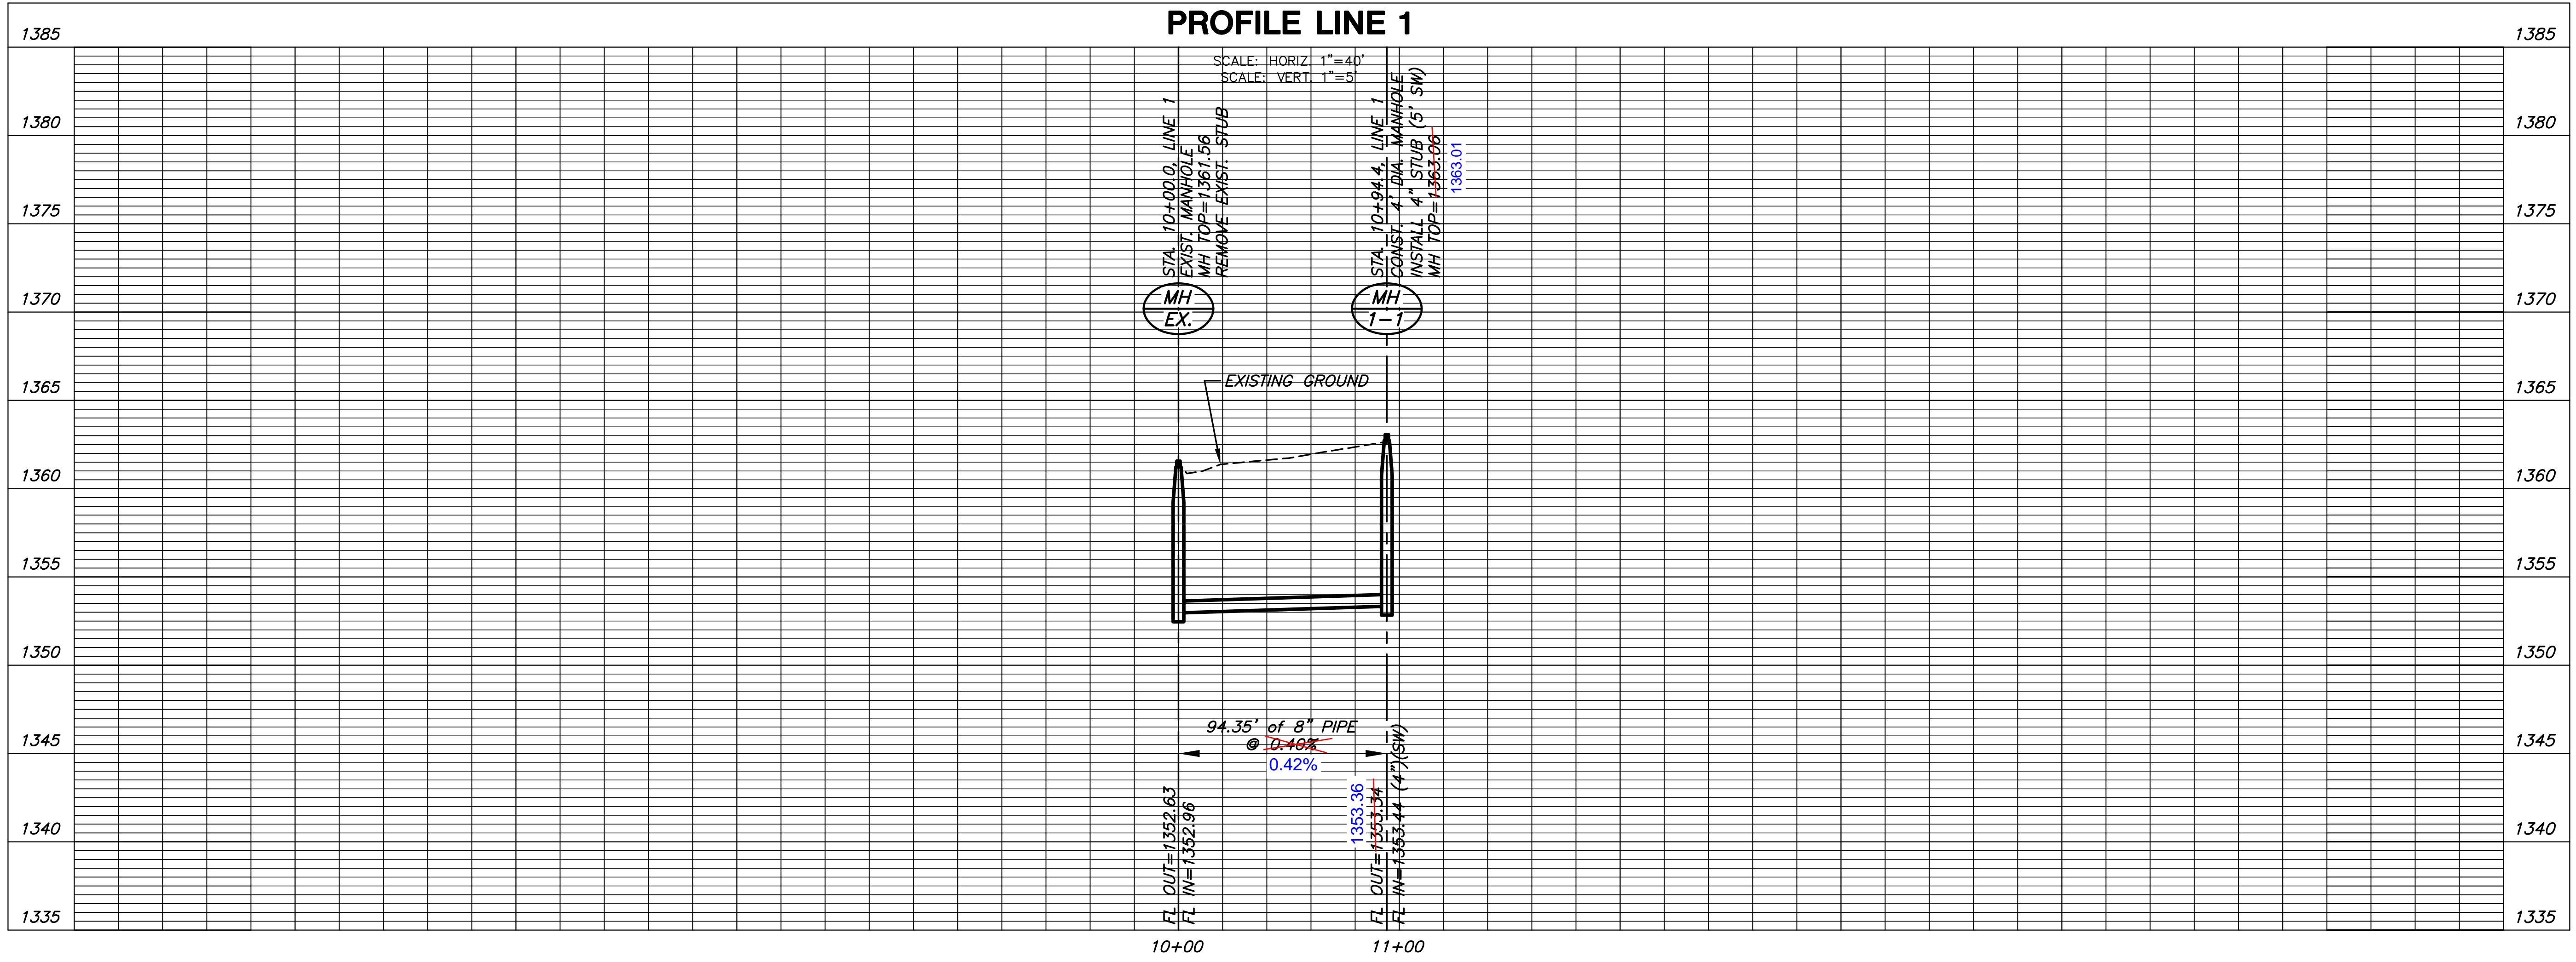

**SANITARY SEWER PLANS FOR  
KRUG SOUTH 2ND ADDITION  
PROJ NO. 468-84847**

**SAN. SEWER  
LINE 1**  
SHEET TITLE  
**468-84847**  
PROJECT NUMBER

**SPE / BKS / GJA**  
DESIGNED DRAWN CHECKED

ISSUED  
**November 2012**

REVISED

SHEET NO.  
**3 of 9**