

FHWA REGION NO.	STATE	PROJECT NO.	YEAR	SHEET NO.	TOTAL SHEETS
7	KANSAS	54-87 K-4445-01	1996	5	73

(mark one) ☐ Government Corner ☐ Traverse Point ☒ Baseline Point ☐ Other Control Pt. #1


City WICHITA County SEDGWICK State KANSAS
Section 23 Township 27S Range 1E 6th P.M.
Monument Title SG 163 KDOT designation _____
Project KELLOGG/OLIVER INTERCHANGE Date 2/4/92
Party Chief SLW

Record monument description: NONE

Monument Description: ☐ Found ☒ Set (describe method if set)
24" LONG #4 REBAR WITH 2" ALUM. DISC STAMPED "SG163"

Reference Ties: RANDOM LOCATION SELECTION (INTERVARIABLE WITH CONTROL PTS. #2 (SG164) & #3 (SG165))

- | Description | (Dist.) | (Chk'd) | Distance | Bearing |
|--|---------|---------|----------|---------|
| 1. 59'± N. TO CHIS. "4" ON T.O.C. ON N. SIDE KELLOGG | | | | |
| 2. 71'± S. TO CHIS. "4" ON T.O.C. ON S. SIDE KELLOGG @ APPROX. P.C. OF HILLSIDE EXIT RAMP | | | | |
| 3. 135'± E. TO CHIS. "4" ON STR. TOP N. WALL OF 2 ND STORM DRAIN AREA WEST E. OF HILLSIDE BR. | | | | |
| 4. 43'± W. TO CHIS. "4" ON STR. TOP N. WALL OF 1 ST STORM DRAIN AREA WEST E. OF HILLSIDE BR. | | | | |

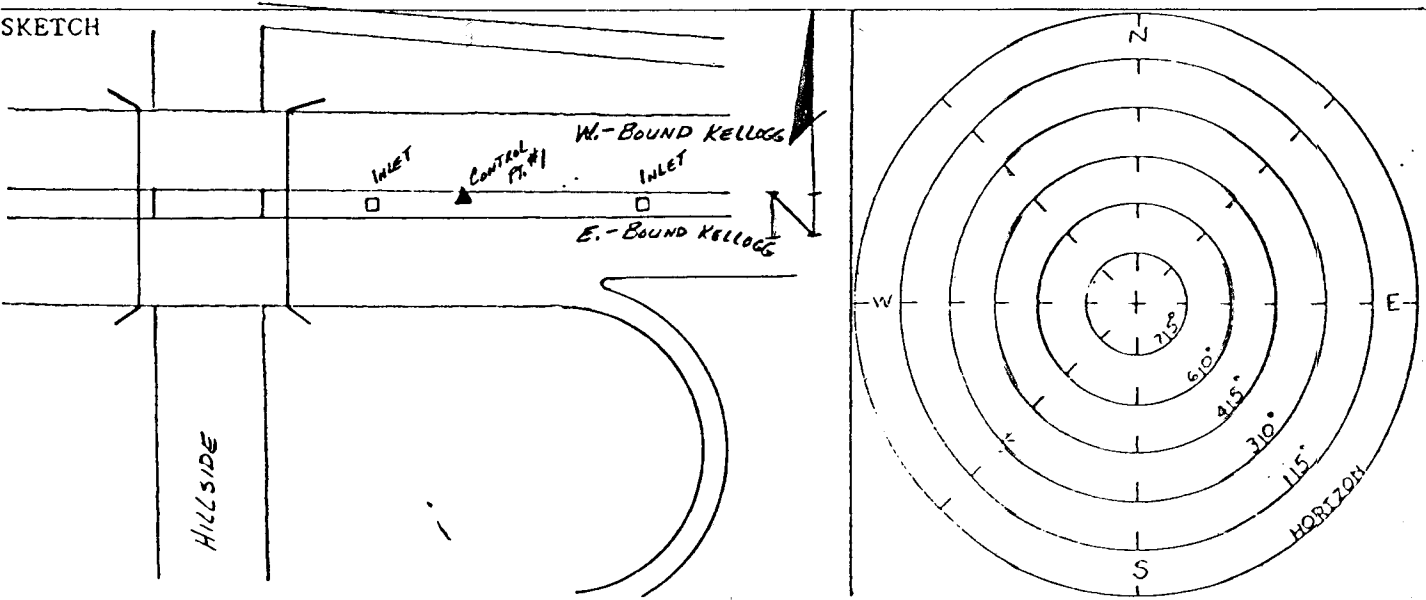

(mark one) ☐ Government Corner ☐ Traverse Point ☒ Baseline Point ☐ Other Control Pt. #4


City WICHITA County SEDGWICK State KANSAS
Section 25 Township 27S Range 1E 6th P.M.
Monument Title SG 166 KDOT designation _____
Project KELLOGG/OLIVER INTERCHANGE Date 2/4/92
Party Chief SLW

Record monument description: NONE

Monument Description: ☐ Found ☒ Set (describe method if set)
24" LONG #4 REBAR WITH 2" ALUM. DISC STAMPED "SG166"

Reference Ties: RANDOM LOCATION SELECTION (INTERVARIABLE WITH CONTROL PTS. #3 (SG165) & #5 (SG167))

- | Description | (Dist.) | (Chk'd) | Distance | Bearing |
|--|---------|---------|----------|---------|
| 1. 72'± N. TO CHIS. "4" ON T.O.C. ON S. SIDE E-BOUND KELLOGG | | | | |
| 2. 13'± SW. TO CHIS. "4" ON TOP W. EDGE CONC. C.P. BASE 2 ND TALL | | | | |
| 3. 44'± WNW. TO PK. N. 43° (NAG.) IN N. FACE R.P. | | | | |
| 4. 92'± ESE. TO FOUND CHIS. "4" IN SDWK. @ SW. COR. RD. INTX. OF EDGEWATER & KELLOGG | | | | |
| 5. 1'± N. OF S. EDGE SDWK. @ S. RW KELLOGG @ 115'± E. W. OF E. EDGE DOOR | | | | |

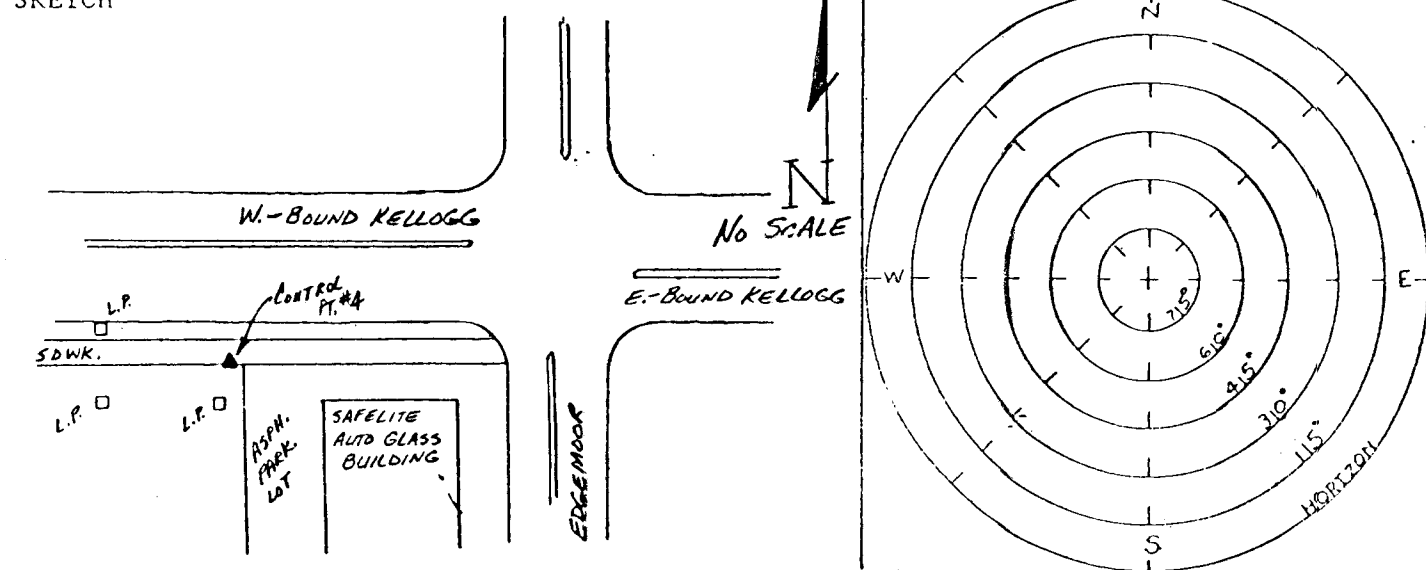

(mark one) ☐ Government Corner ☐ Traverse Point ☒ Baseline Point ☐ Other Control Pt. #2


City WICHITA County SEDGWICK State KANSAS
Section 26 Township 27S Range 1E 6th P.M.
Monument Title SG 164 KDOT designation _____
Project KELLOGG/OLIVER INTERCHANGE Date 2/4/92
Party Chief SLW

Record monument description: NONE

Monument Description: ☐ Found ☒ Set (describe method if set)
2" ALUM. DISC STAMPED "SG164"

Reference Ties: RANDOM LOCATION SELECTION (INTERVARIABLE WITH CONTROL PTS. #1 (SG163) & #3 (SG165))

- | Description | (Dist.) | (Chk'd) | Distance | Bearing |
|--|---------|---------|----------|---------|
| 1. 60'± S. TO CHIS. "4" ON N. NOSE MEDIAN TRAFFIC ISLAND IN ROOSEVELT ST. | | | | |
| 2. 24'± ESE. TO CHIS. "4" ON T.O.C. IN SE. COR. RD. INTX. OF ROOSEVELT & KELLOGG STREETS | | | | |
| 3. 28'± WSW. TO CHIS. "4" ON T.O.C. IN SW. COR. RD. INTX. OF ROOSEVELT & KELLOGG STREETS | | | | |
| 4. 21'± N. TO PK. N. 43° ON N. EDGE DRIVING SURFACE OF E-BOUND KELLOGG | | | | |

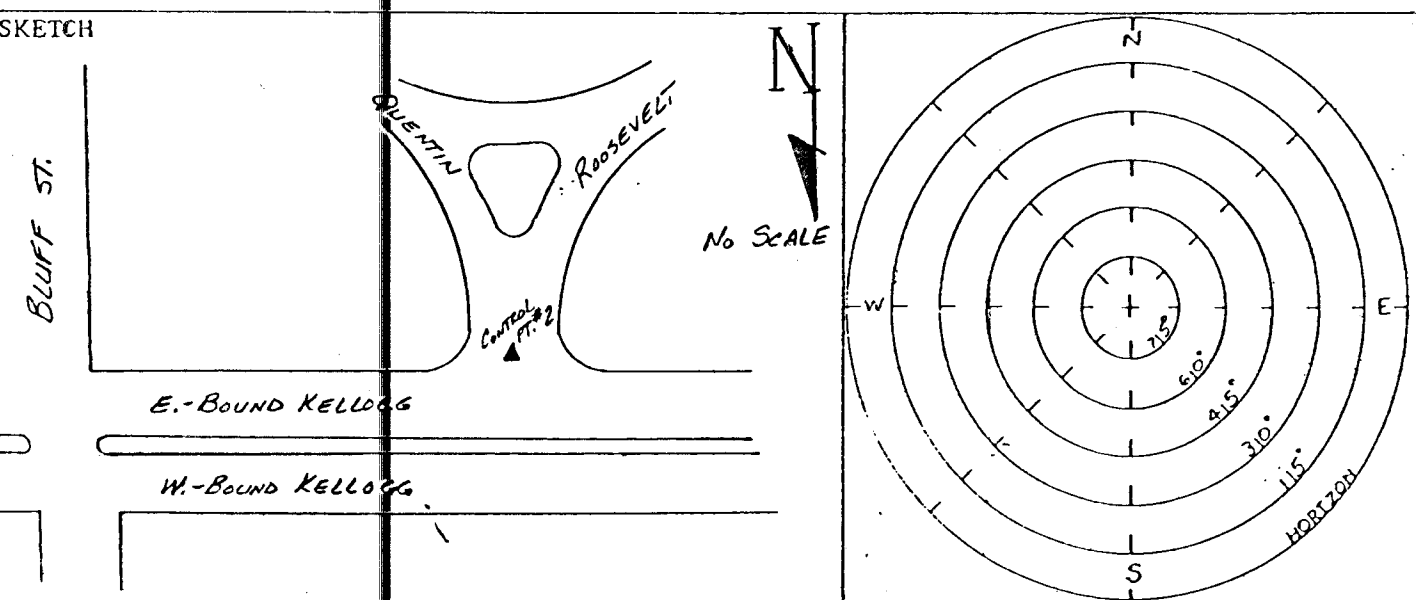

(mark one) ☐ Government Corner ☐ Traverse Point ☒ Baseline Point ☐ Other Control Pt. #5


City WICHITA County SEDGWICK State KANSAS
Section 24 Township 27S Range 1E 6th P.M.
Monument Title SG 167 KDOT designation _____
Project KELLOGG/OLIVER INTERCHANGE Date 2/4/92
Party Chief SLW

Record monument description: NONE

Monument Description: ☐ Found ☒ Set (describe method if set)
24" LONG #4 REBAR WITH ALUM. DISC STAMPED "SG167"

Reference Ties: RANDOM LOCATION SELECTION (INTERVARIABLE WITH CONTROL PTS. #4 (SG166) & #3 (SG165))

- | Description | (Dist.) | (Chk'd) | Distance | Bearing |
|---|---------|---------|----------|---------|
| 1. 28'± N. TO CHIS. "4" ON T.O.C. OF S. FRONTAGE RD. ON S. SIDE KELLOGG | | | | |
| 2. 53'± W. TO CHIS. "4" ON T.O.C. OF S. FRONTAGE RD. ON S. SIDE KELLOGG BETWEEN ENTRANCES TO RED CARPET CAR WASH | | | | |
| 3. 84'± E. TO CHIS. "4" ON S. T.O.C. OF S. FRONTAGE RD. ON S. SIDE KELLOGG BETWEEN ENTRANCES TO RED CARPET CAR WASH | | | | |
| 4. S. TO CHIS. "4" ON NW. COR. CONC. EXIT APRON FROM RED CARPET CAR WASH | | | | |

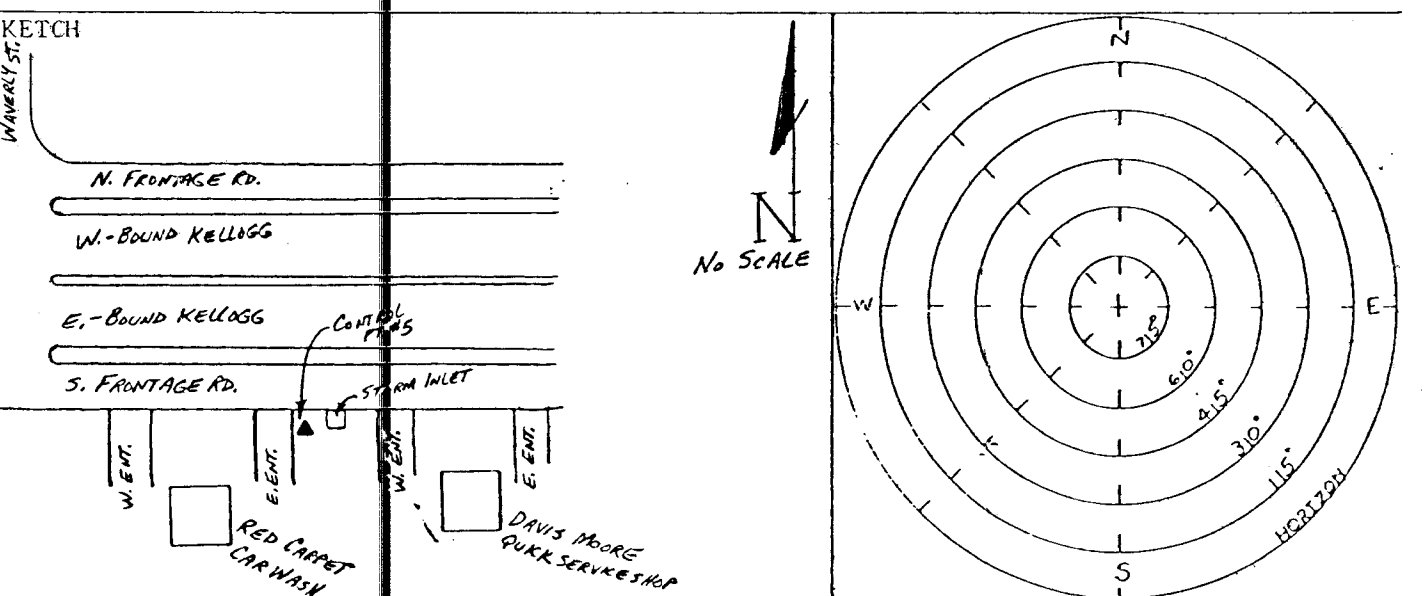

(mark one) ☐ Government Corner ☐ Traverse Point ☒ Baseline Point ☐ Other Control Pt. #3


City WICHITA County SEDGWICK State KANSAS
Section 26 Township 27S Range 1E 6th P.M.
Monument Title SG 165 KDOT designation _____
Project KELLOGG/OLIVER INTERCHANGE Date 2/4/92
Party Chief SLW

Record monument description: NONE

Monument Description: ☐ Found ☒ Set (describe method if set)
24" LONG #4 REBAR WITH 2" ALUM. DISC STAMPED "SG165"

Reference Ties: RANDOM LOCATION SELECTION (INTERVARIABLE WITH CONTROL PTS. #2 (SG164) & #4 (SG166))

- | Description | (Dist.) | (Chk'd) | Distance | Bearing |
|--|---------|---------|----------|---------|
| 1. 43'± W. TO CHIS. "4" ON T.O.C. @ SE. COR. RD. INTX. OF DELLORE & KELLOGG STREETS | | | | |
| 2. 6'± N. TO CHIS. "4" ON T.O.C. ON S. SIDE E-BOUND KELLOGG | | | | |
| 3. 56'± S. TO CHIS. "4" ON T.O.C. ON N. SIDE ASPH. PARK LOT | | | | |
| 4. 23'± ESE. TO CHIS. "4" ON TOP NW. COR. 2 ND CONC. L.P. BASE 2 ND TALL | | | | |
| 5. 1'± S. OF N. EDGE SDWK. @ S. RW KELLOGG @ 60'± E. OF E. DELLORE | | | | |

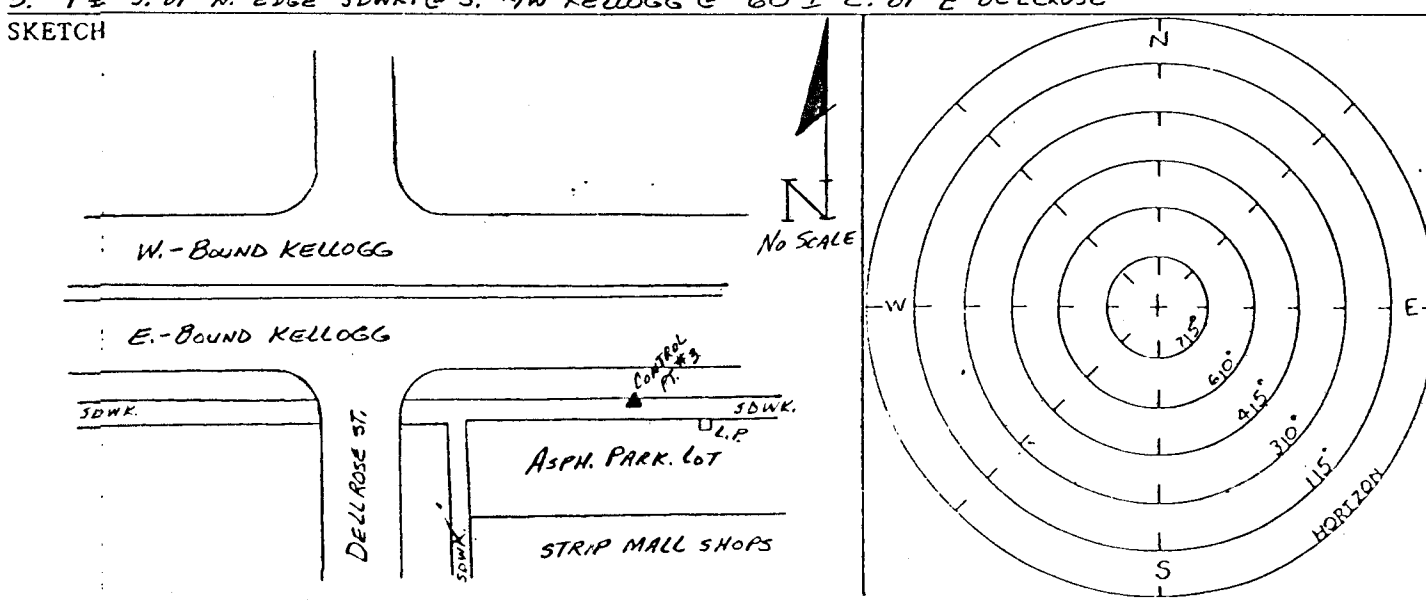

VERTICAL:

DATUM BENCHMARK: U.S.C. & G.S. BENCHMARK A-237 M.S.L. ELEVATION 1316.608

At Wichita, 10.4 feet South of the Northwest corner of the Union Station, 28 feet East of the East rail of the East track, 2.3 feet above the ground, 3 1/2 rails South of the centerline of the Douglas Avenue viaduct, set vertically in the West wall of the Railroad Station, in Section 21, Township 27 South, Range 1 East of the 6th P.M.

HORIZONTAL:

G.P.S. CONTROL POINTS: (ALONG KELLOGG MAIN LINE)

- | CONTROL POINT | DESCRIPTION | NORTHING | EASTING |
|------------------|---|-------------|-------------|
| CONTROL POINT #1 | 24 INCH LONG #4 REBAR WITH 2 INCH ALUMINUM DISC STAMPED "SG163" | 1683523.054 | 1660436.835 |
| CONTROL POINT #2 | 24 INCH LONG #4 REBAR WITH 2 INCH ALUMINUM DISC STAMPED "SG164" | 1683433.460 | 1662211.797 |
| CONTROL POINT #3 | 24 INCH LONG #4 REBAR WITH 2 INCH ALUMINUM DISC STAMPED "SG165" | 1683482.445 | 1665178.745 |
| CONTROL POINT #4 | 24 INCH LONG #4 REBAR WITH 2 INCH ALUMINUM DISC STAMPED "SG166" | 1683523.087 | 1667959.047 |
| CONTROL POINT #5 | 24 INCH LONG #4 REBAR WITH 2 INCH ALUMINUM DISC STAMPED "SG167" | 1683508.689 | 1669392.729 |