


	BY	DATE
REFERENCES NOTED		
REFERENCES CHECKED		

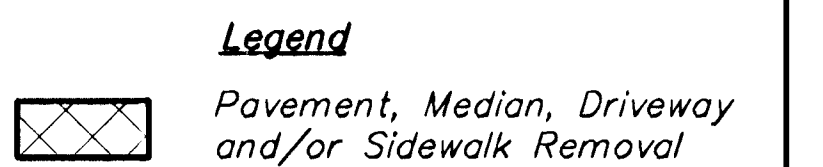

2			
1	7/99	PAVEMENT WIDENING	WNJ DCH
NO.	DATE	REVISIONS	BY APP'D
KANSAS DEPARTMENT OF TRANSPORTATION MERIDIAN AVE. STA. 1+810 TO STA.1+950 PROJ. NO. 87N-0116-01 SEDGWICK COUNTY MID-KANSAS ENGINEERING CONSULTANTS, INC. WICHITA, KANSAS			
DESIGNED BY: GJA		CHECKED BY: GJA	
DRAWN BY: WNJ		DATE: DEC. 1998 SHEET 11 OF 110	

K: \CIVIL\97043\REVISION\PAV\97043 E5.DWG Fri Aug 06 13:35:48 1999