


| FHWA<br>REG<br>NO. | STATE  | PROJECT NO. | YEAR | SHEET<br>NO. | TOTAL<br>SHEETS |
|--------------------|--------|-------------|------|--------------|-----------------|
| 7                  | KANSAS | 87N-0116-01 | 1999 | 28           | 110             |

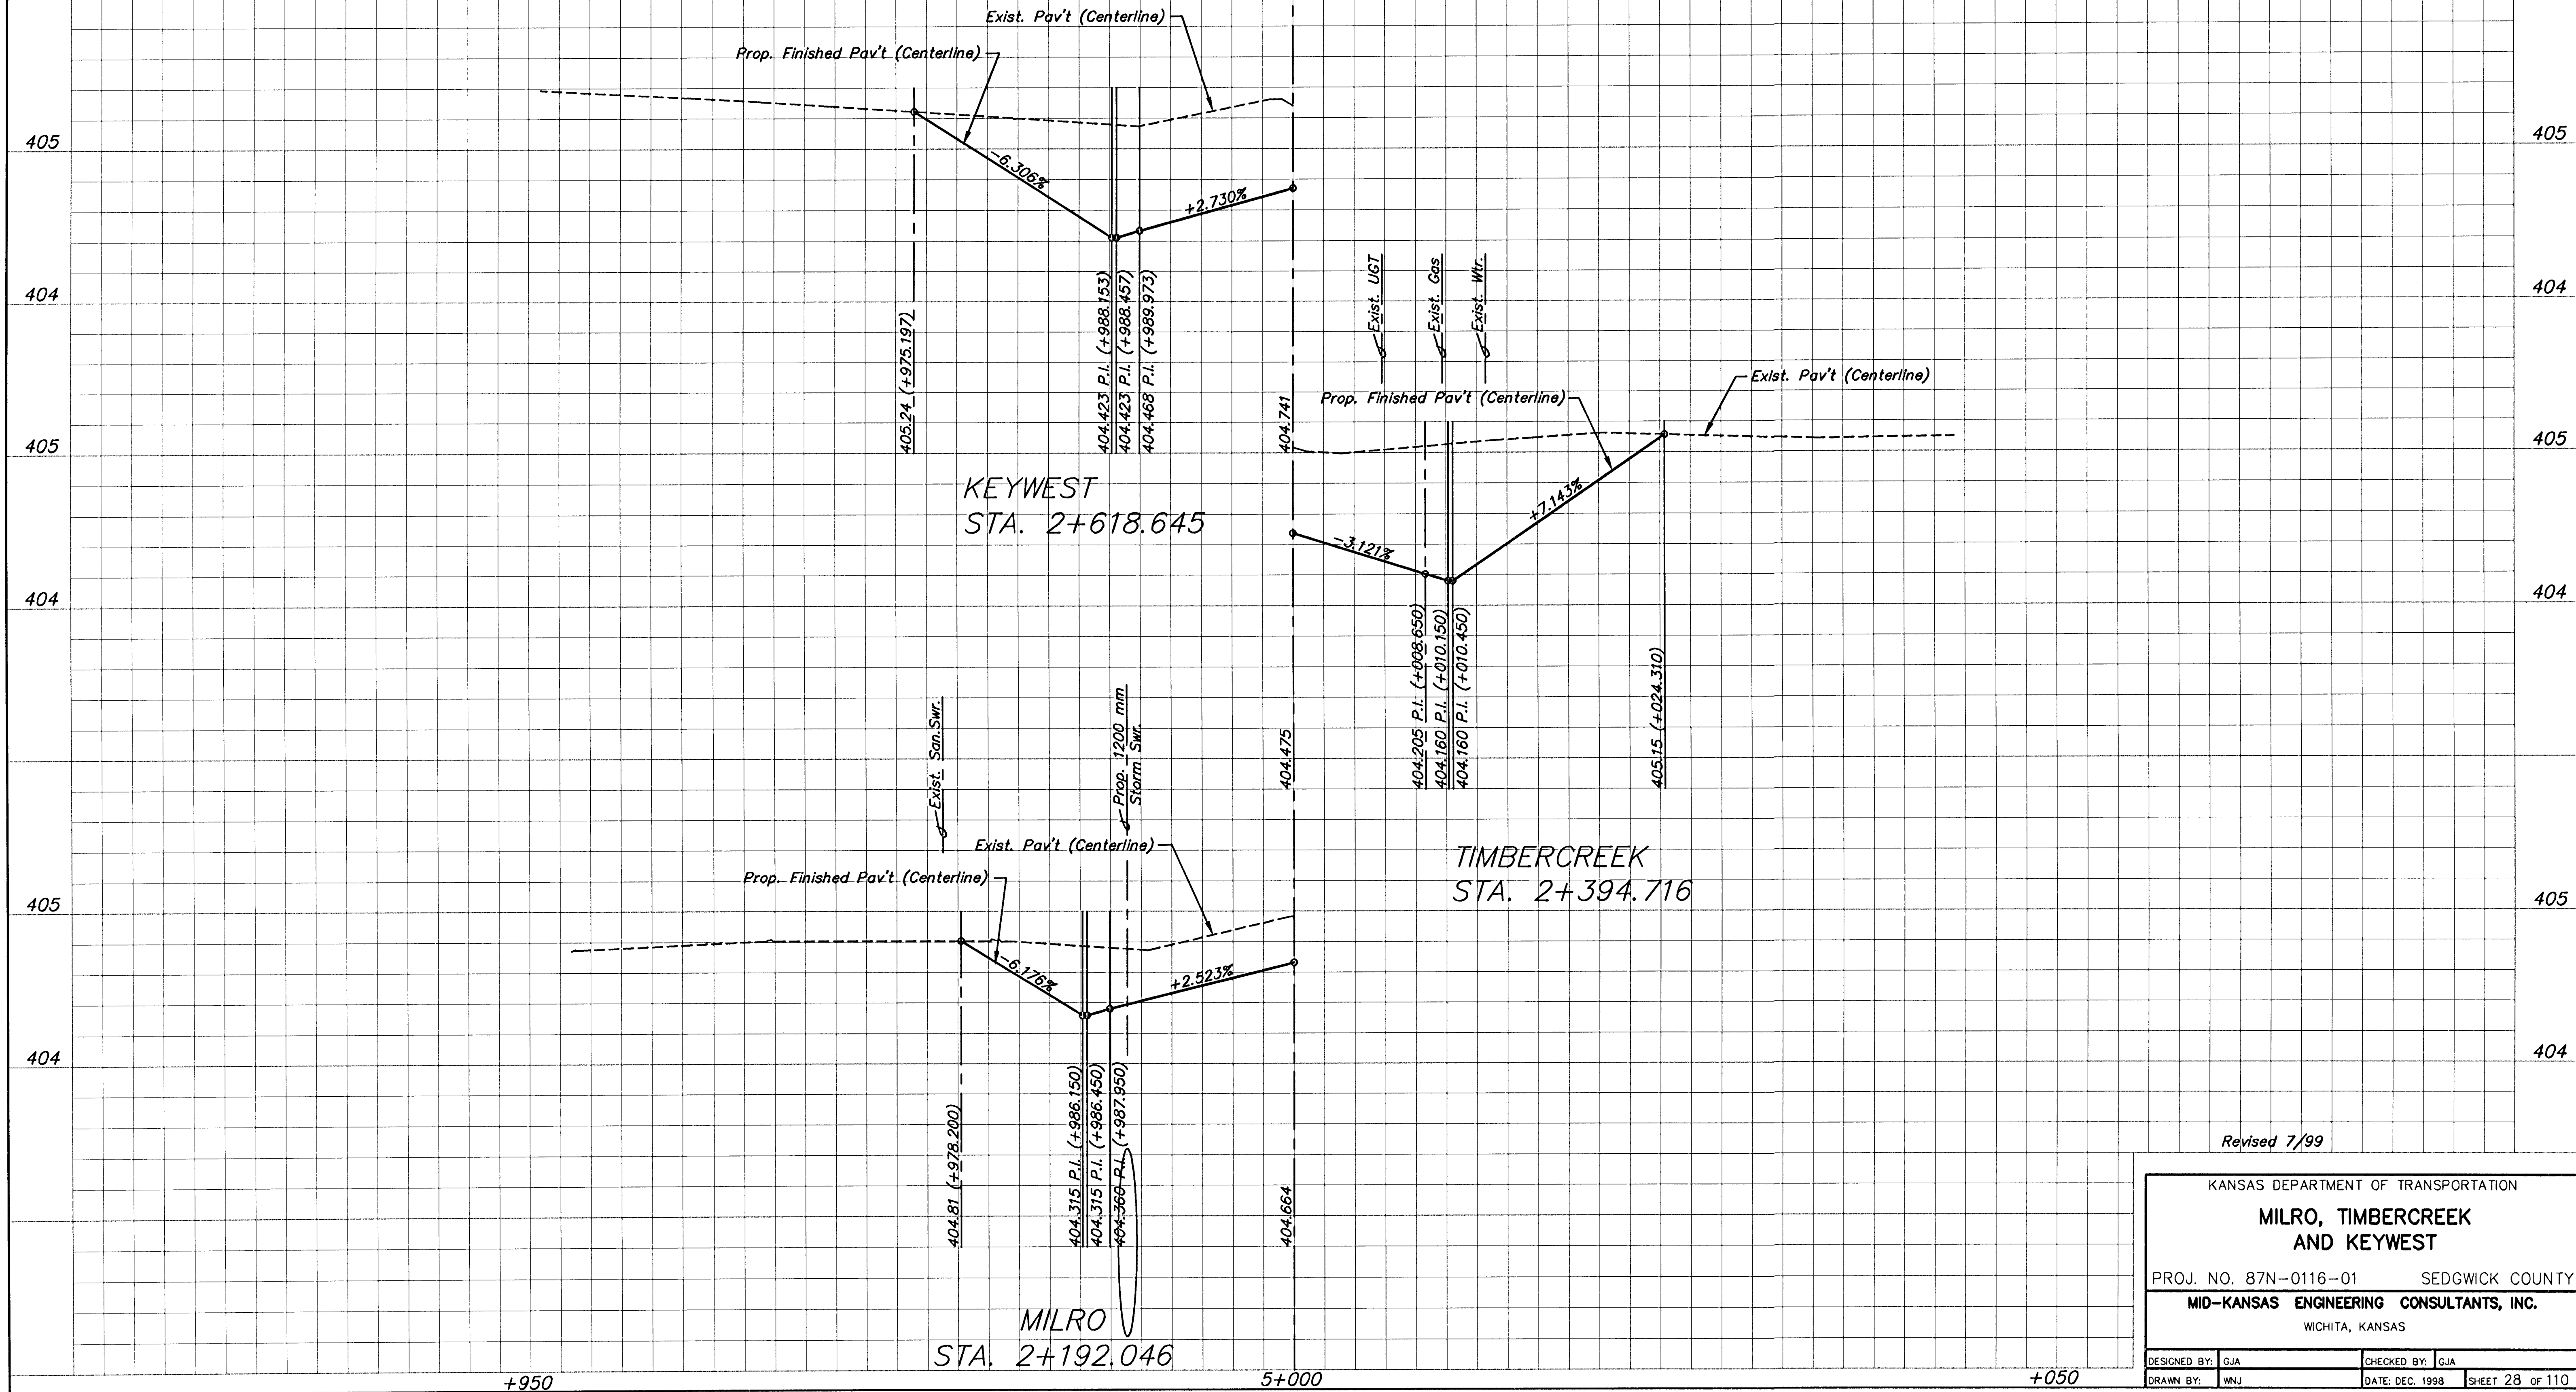

Revised 7/99

|                                          |     |                 |                 |
|------------------------------------------|-----|-----------------|-----------------|
| KANSAS DEPARTMENT OF TRANSPORTATION      |     |                 |                 |
| MILRO, TIMBERCREEK<br>AND KEYWEST        |     |                 |                 |
| PROJ. NO. 87N-0116-01                    |     | SEDGWICK COUNTY |                 |
| MID-KANSAS ENGINEERING CONSULTANTS, INC. |     |                 |                 |
| WICHITA, KANSAS                          |     |                 |                 |
| DESIGNED BY:                             | GJA | CHECKED BY:     | GJA             |
| DRAWN BY:                                | WNJ | DATE: DEC. 1998 | SHEET 28 OF 110 |