


FHWA REGION NO.	STATE	PROJECT NO.	FISCAL YEAR	SHEET NO.	TOTAL SHEETS
7	KANSAS	87-N-0225-01	2002	32	47

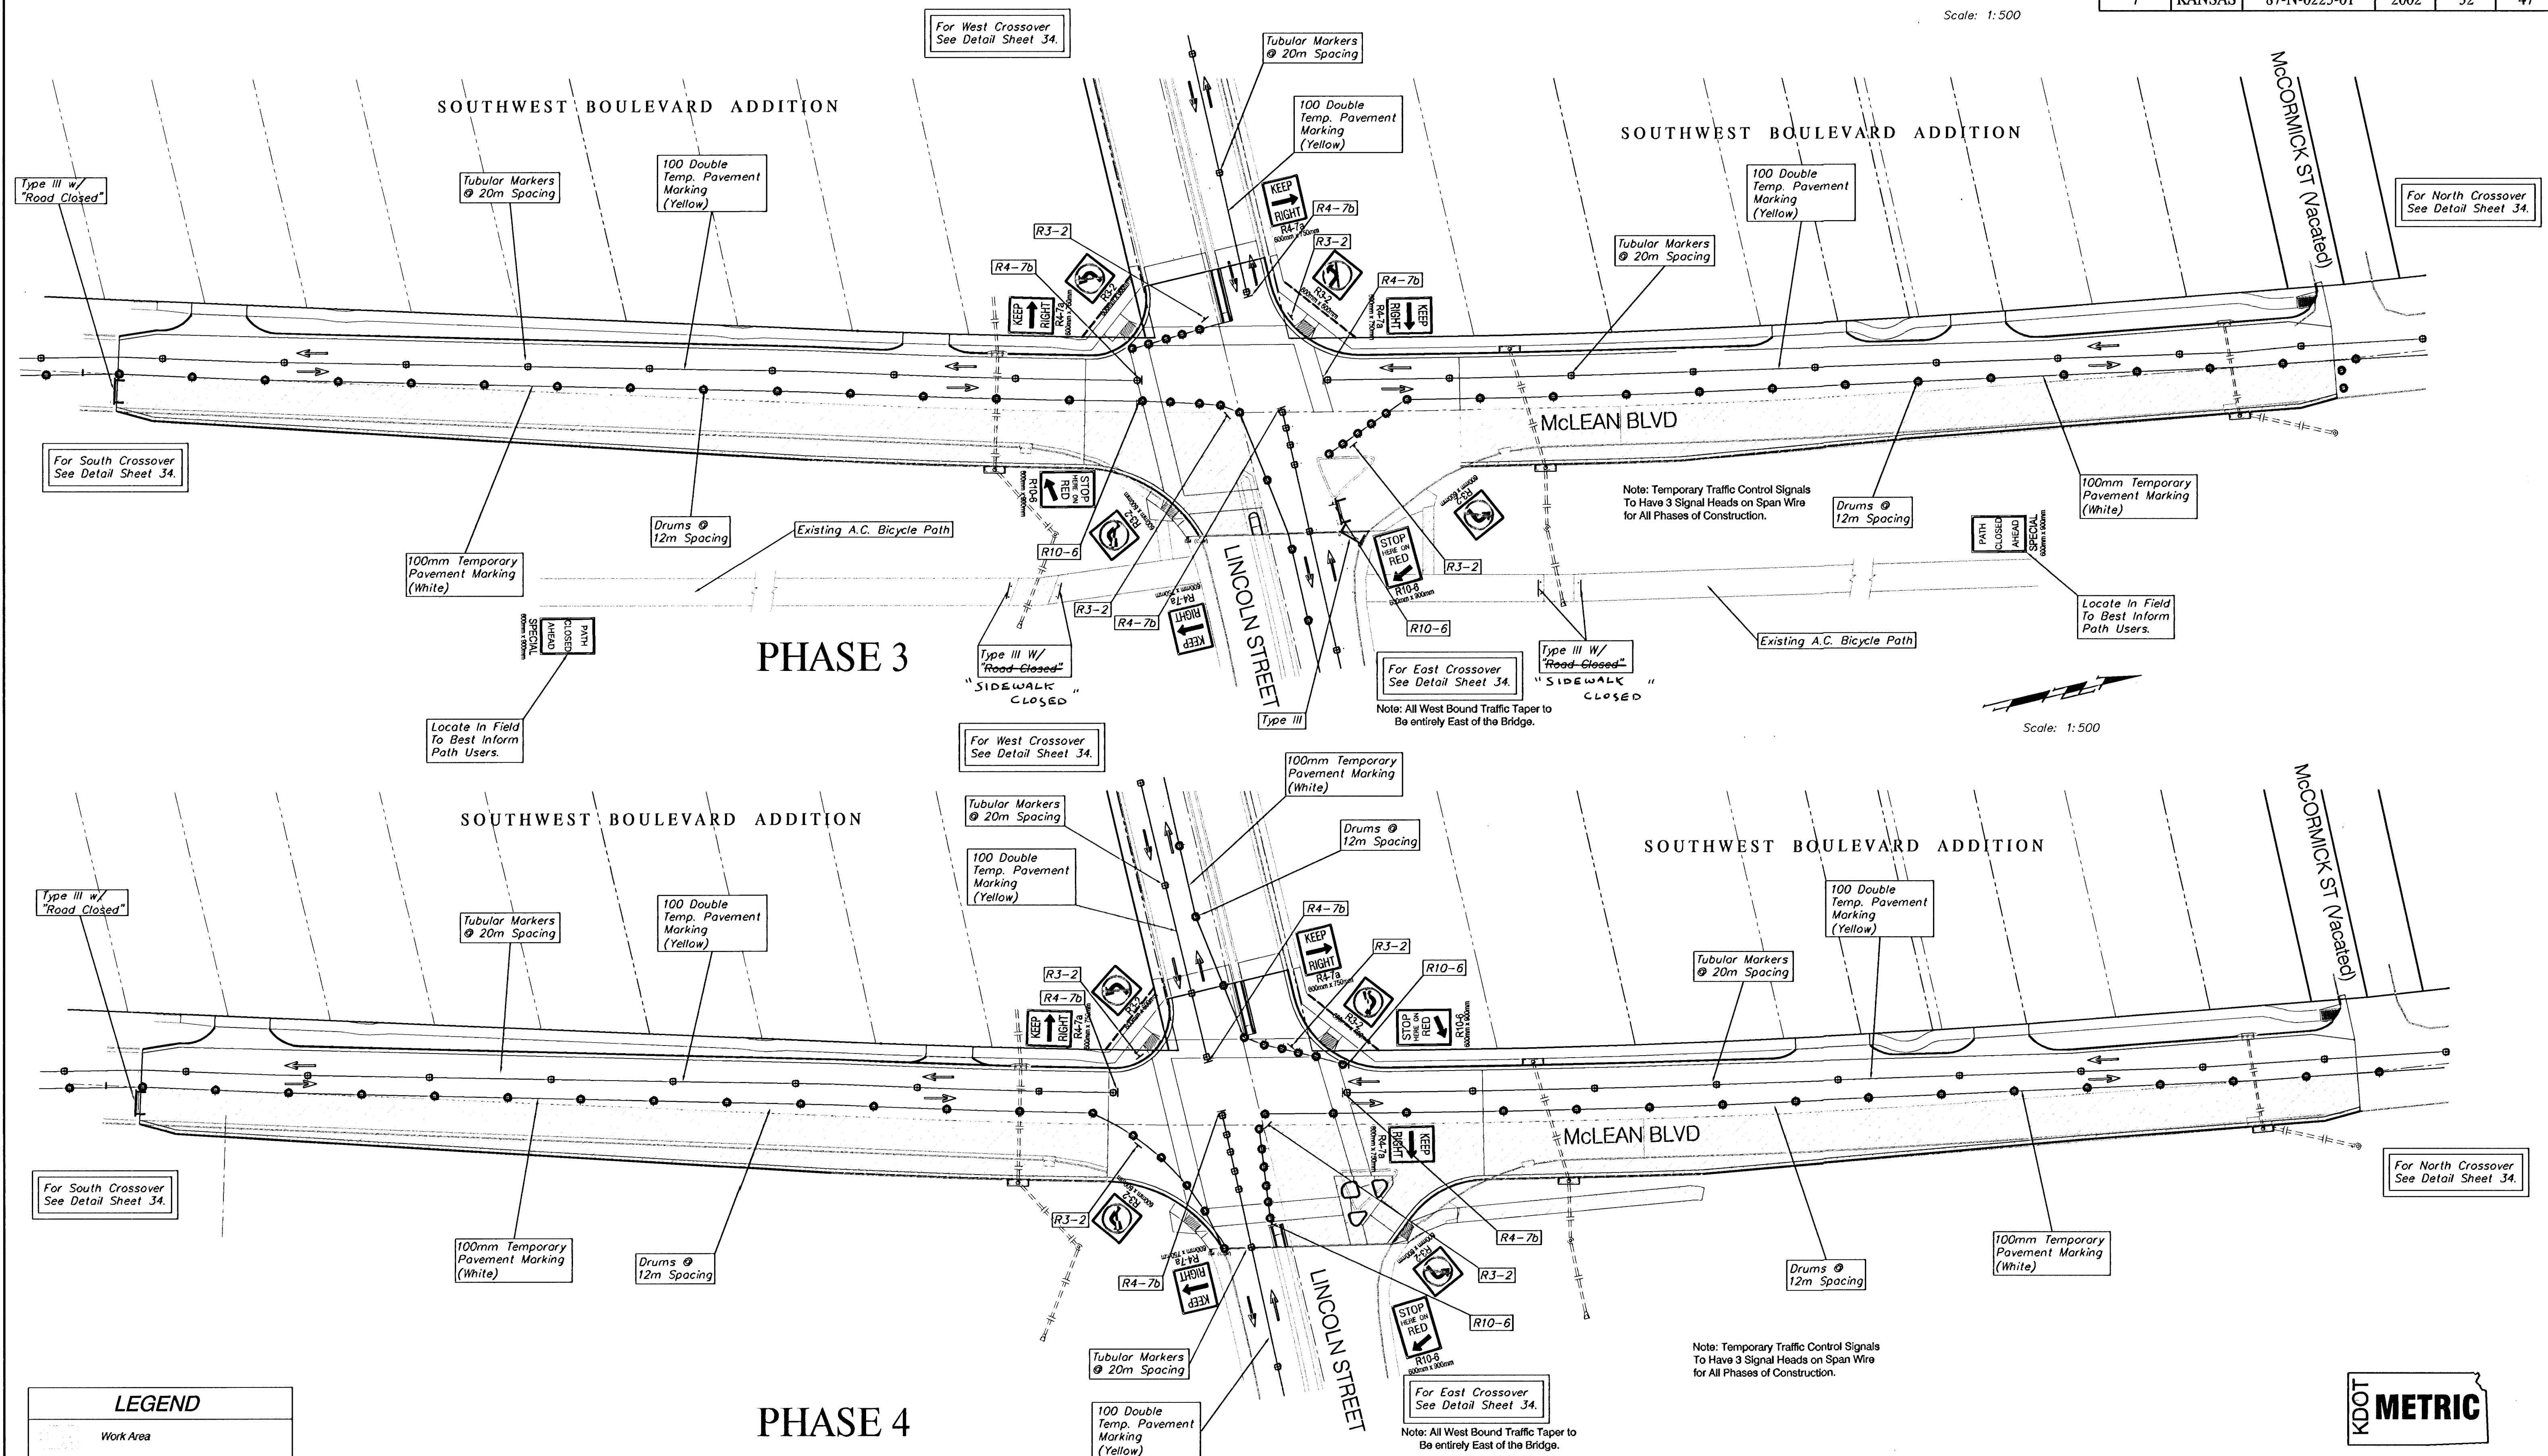

PROJECT NUMBER 472-83799			SHEET NAME Conseq02		ENGINEERING DIRECTORY F:\LinMcln\Conseq
DESIGN JFB	DRAWN KWR	APPROVED JFB	DATE July 2003	SCALE 1:500 SI	BAUGHMAN NO 01-03-E944

CAPITAL IMPROVEMENT PROJECT
CONSTRUCTION SEQUENCING
LINCOLN AND MCLEAN INTERSECTION IMPROVEMENTS

BAUGHMAN COMPANY, P.A.
ENGINEERING, SURVEYING, & PLANNING
316-262-7271 * 315 ELLIS * WICHITA, KANSAS 67211

SHEET
32
—OF
47