



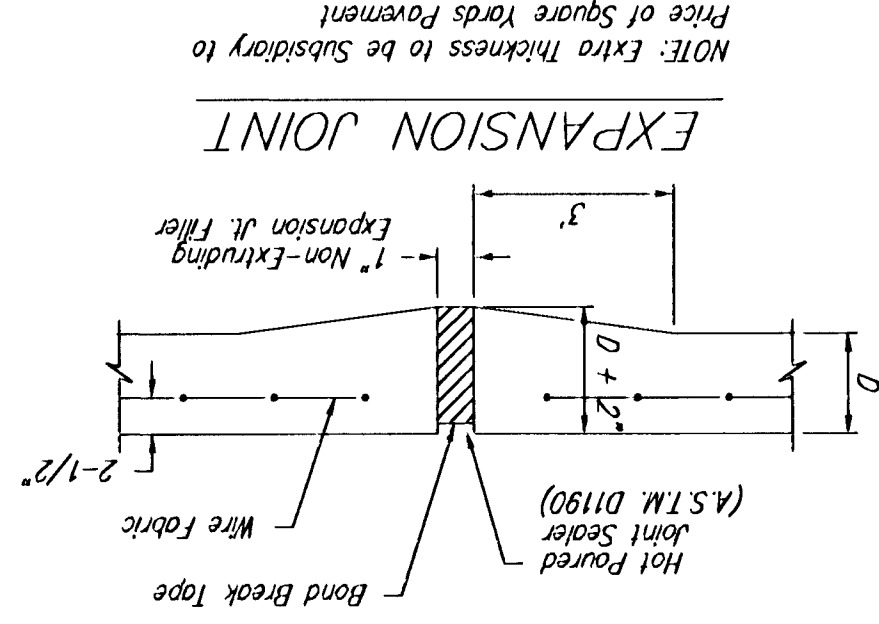


NOTE: Extra Thickness to be Subsidiary to Price of Square Yards Pavement


EXPANSION JOINT

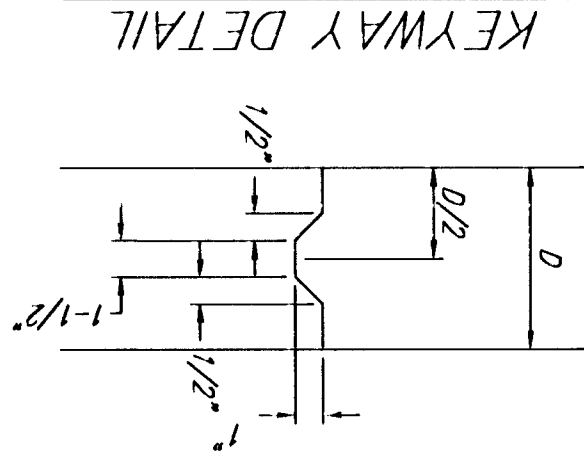


KEYWAY DETAIL

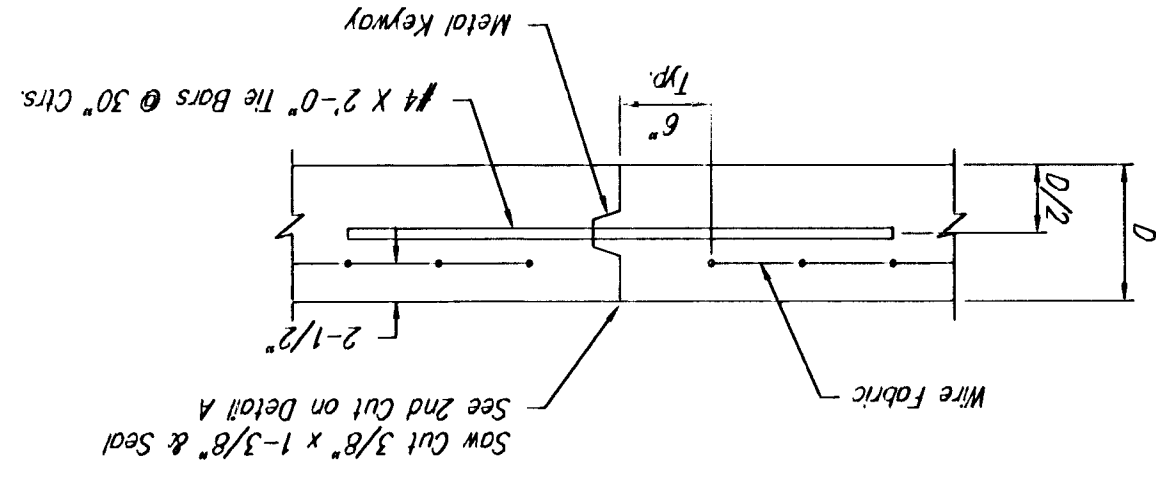


OPTIONAL LONGITUDINAL JOINT DETAIL (L.J.)

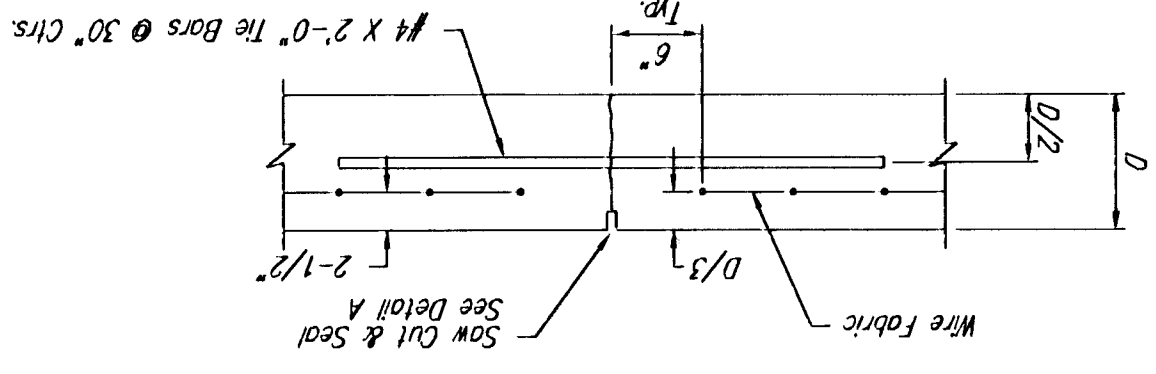


LONGITUDINAL JOINT DETAIL (L.J.)

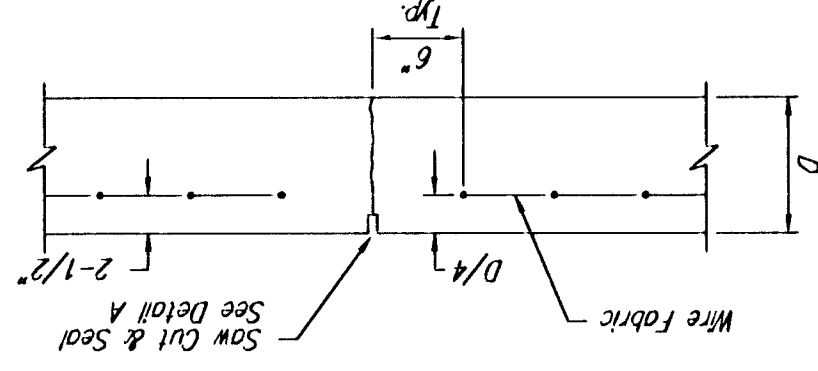


CONTRACTION JOINT DETAIL (C.J.)

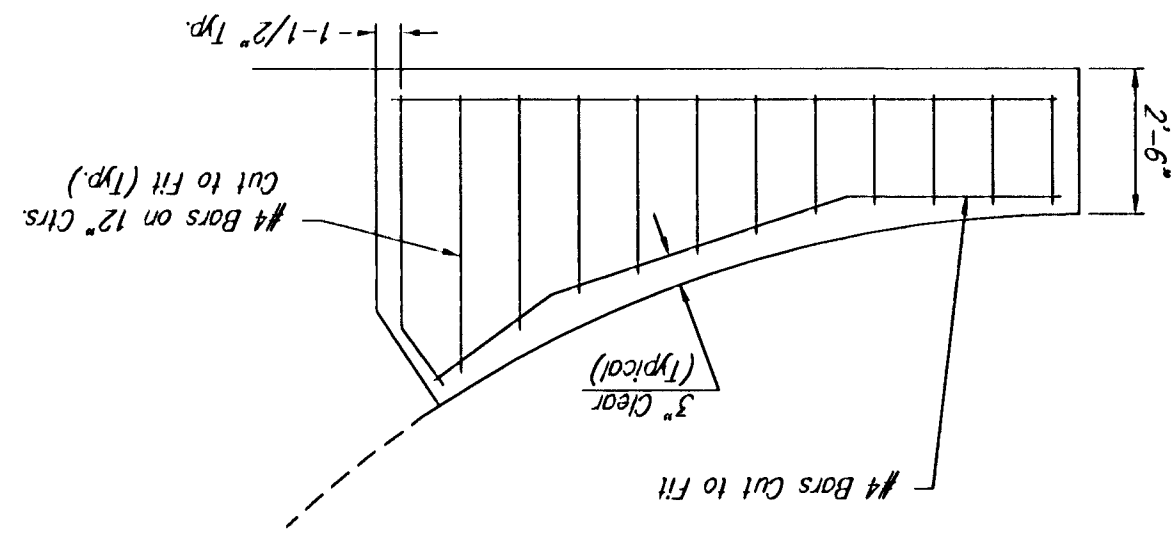


WING REINFORCING DETAIL

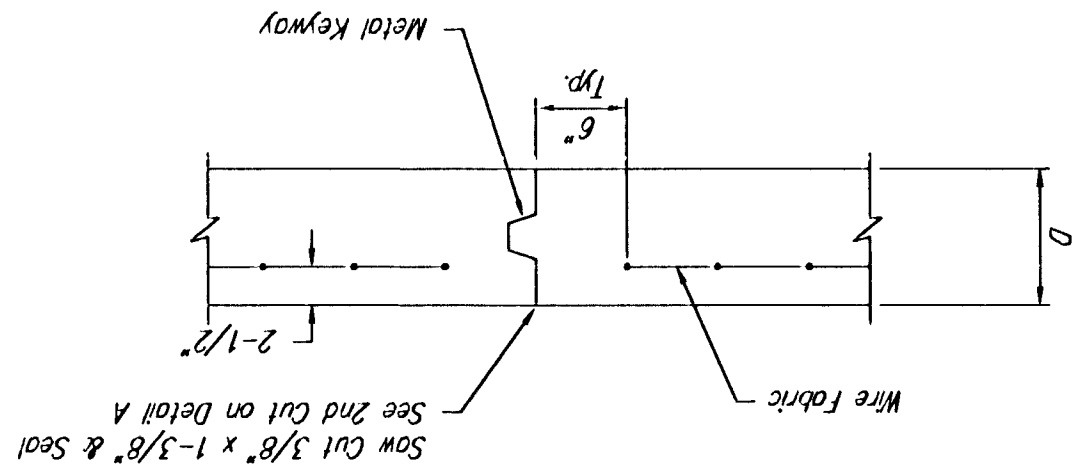


OPTIONAL CONTRACTION JOINT

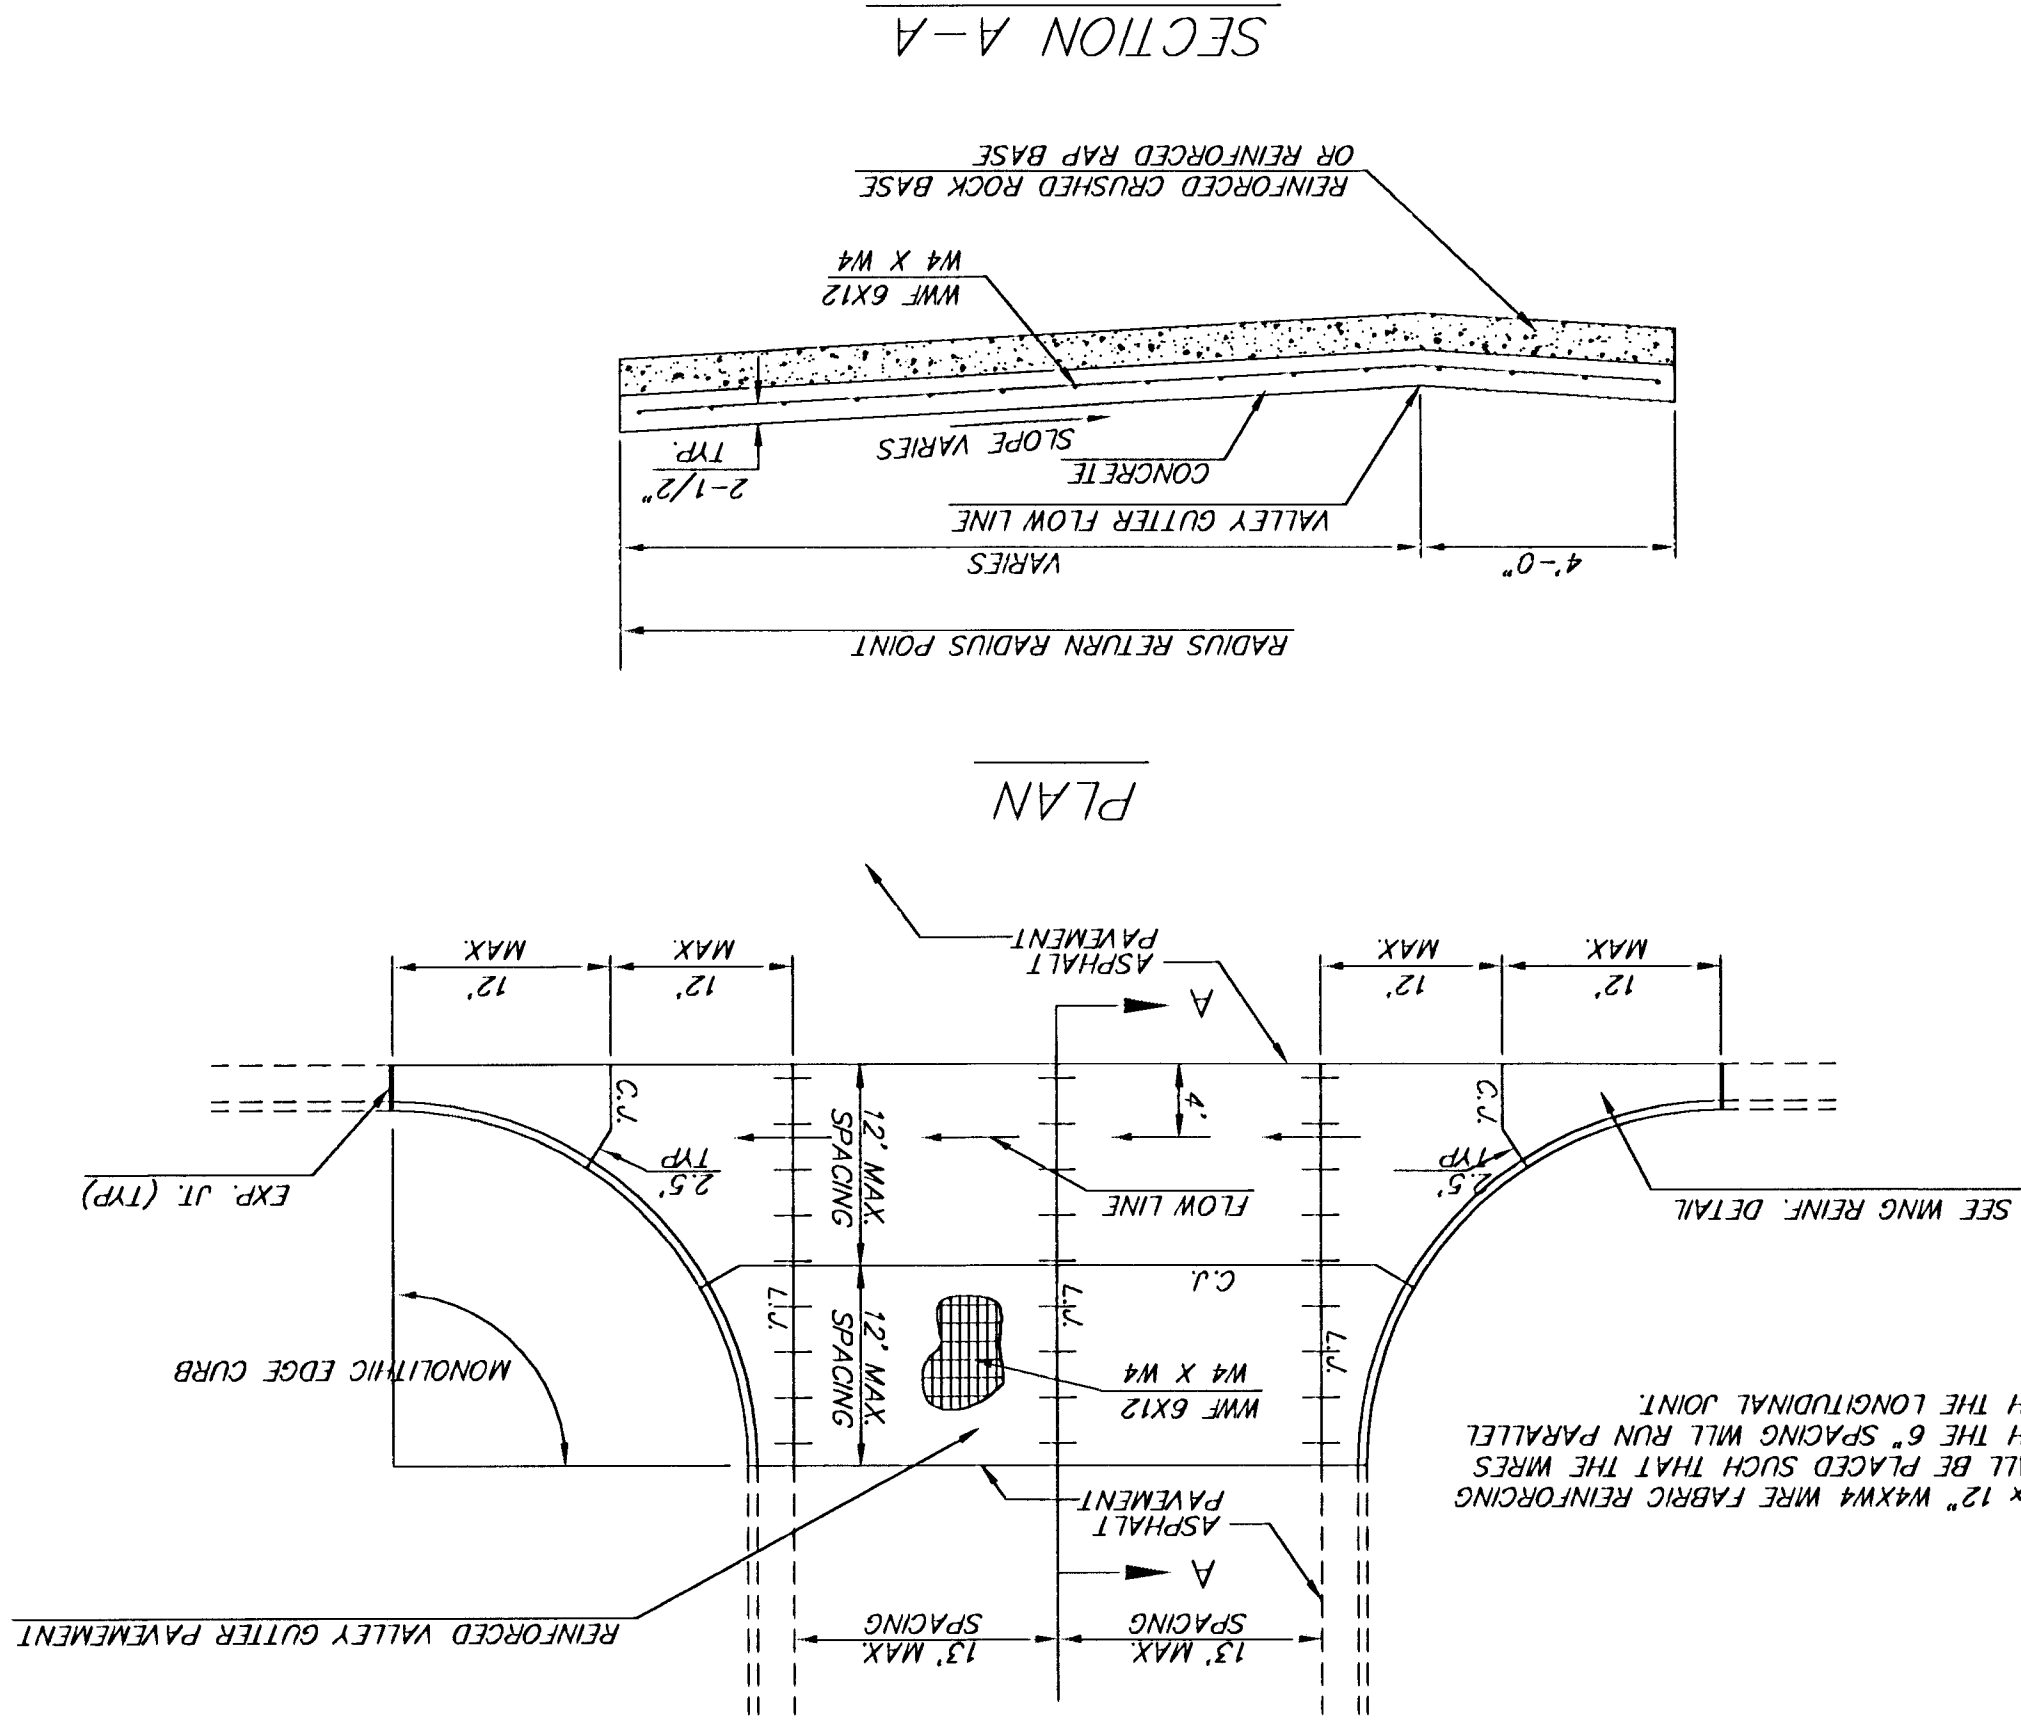


REINFORCED VALLEY GUTTER DETAIL

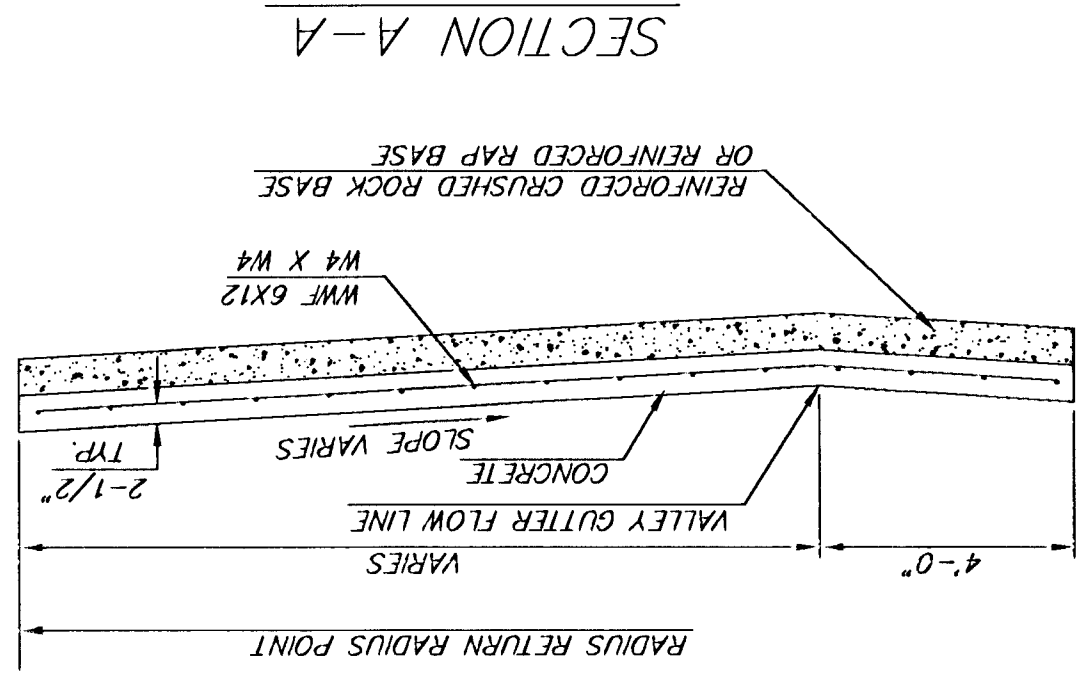


SECTION A-A

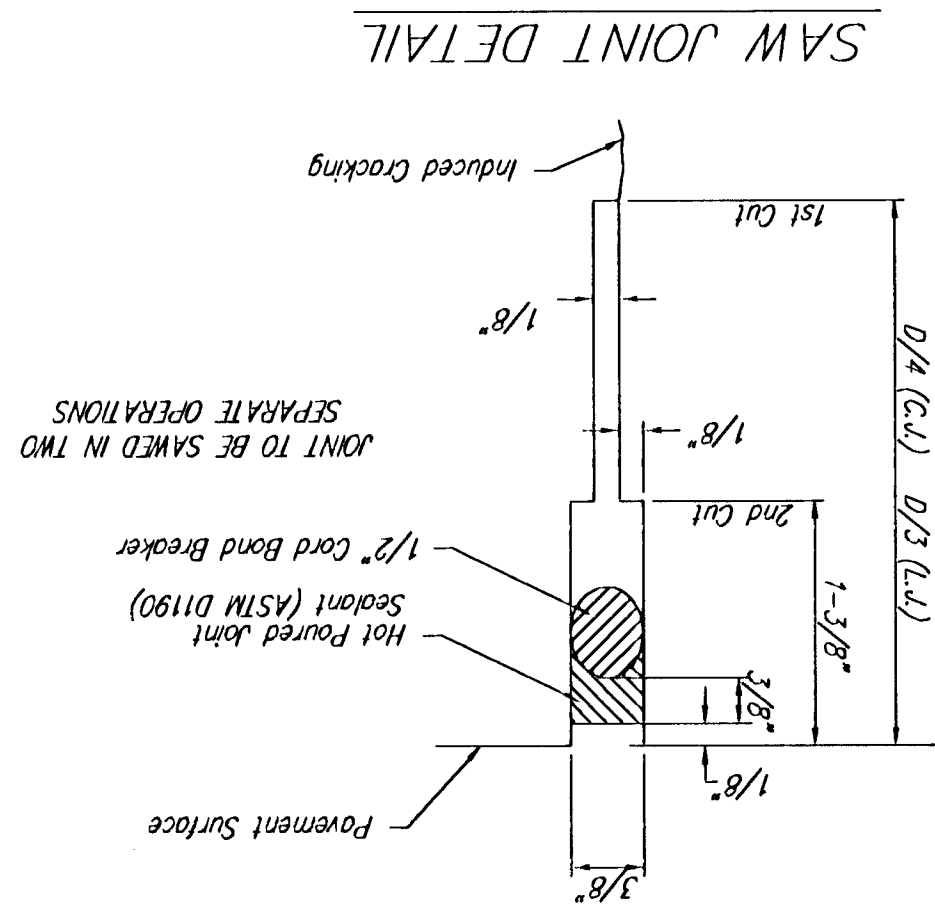


SAW JOINT DETAIL

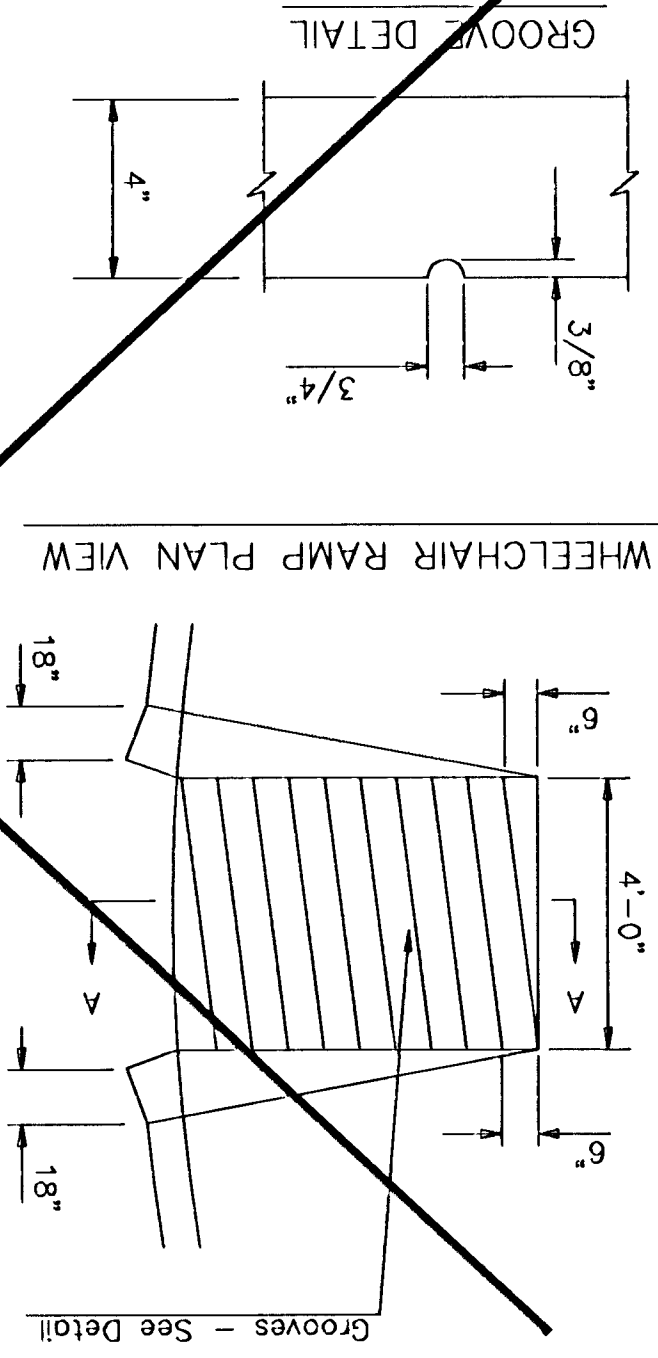


WHEELCHAIR RAMP PLAN VIEW

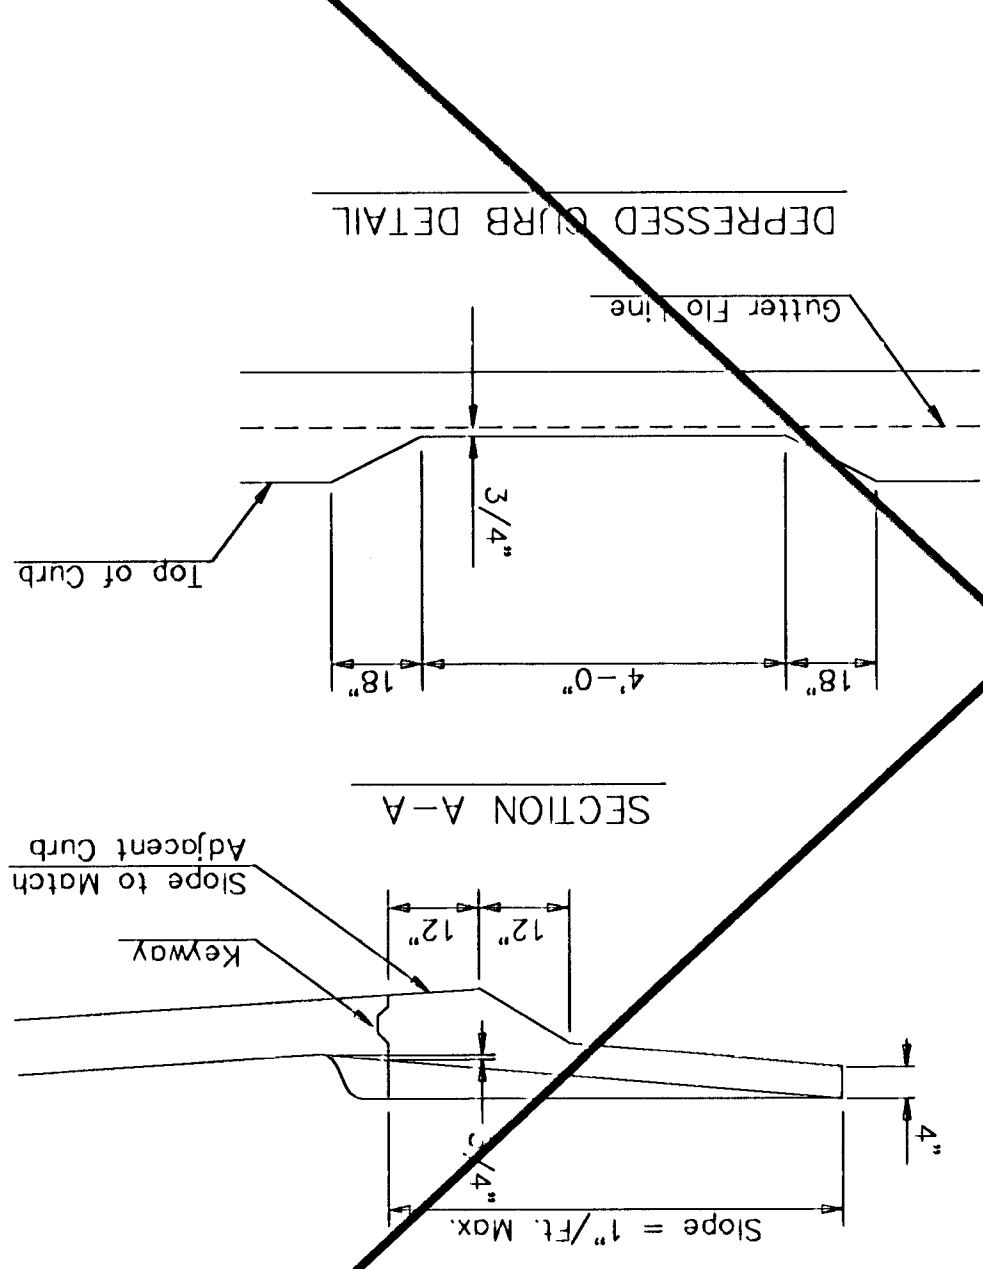

SECTION A-A

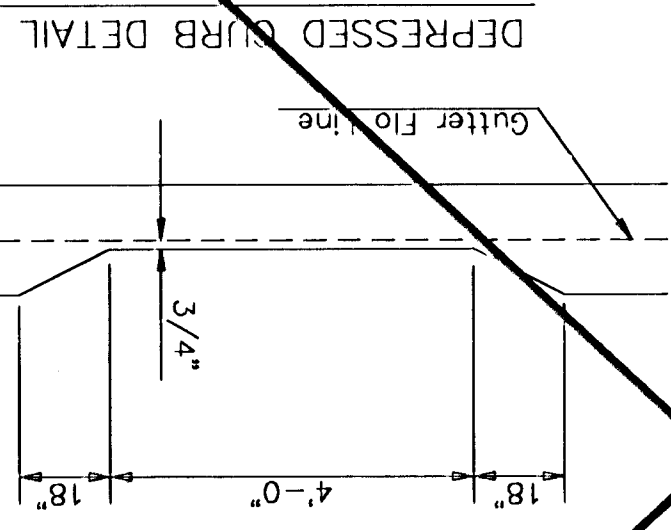

~~ED CURB DETAIL~~

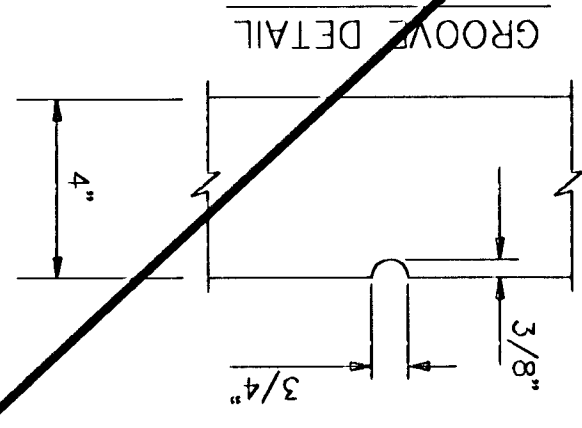

DETAIL

WHEELCHAIR RAMP DETAIL



CITY ENGINEER'S OFFICE
CITY HALL - SEVENTH FLOOR
455 NORTH MAIN STREET
WICHITA, KANSAS 67202
(316) 268-4501
(316) 268-4114 FAX

DATE MAR 96 SHEET 12 OF 82

SHEET 12 OF 82

PROJECT NUMBER	INDEX CODE
----------------	------------

M. E. LINDEBAK P.E. - CITY ENGINEER

VALLEY GUTTER DETAILS
WHEELCHAIR RAMP
DETAILS