



| FHWA<br>REG<br>NO. | STATE  | PROJECT NO.  | YEAR | SHEET<br>NO. | TOTAL<br>SHEETS |
|--------------------|--------|--------------|------|--------------|-----------------|
| 7                  | KANSAS | 87 N-0198-01 | 2001 | 45           | 82              |

FED. AID NO. - CMQ-N019(801)

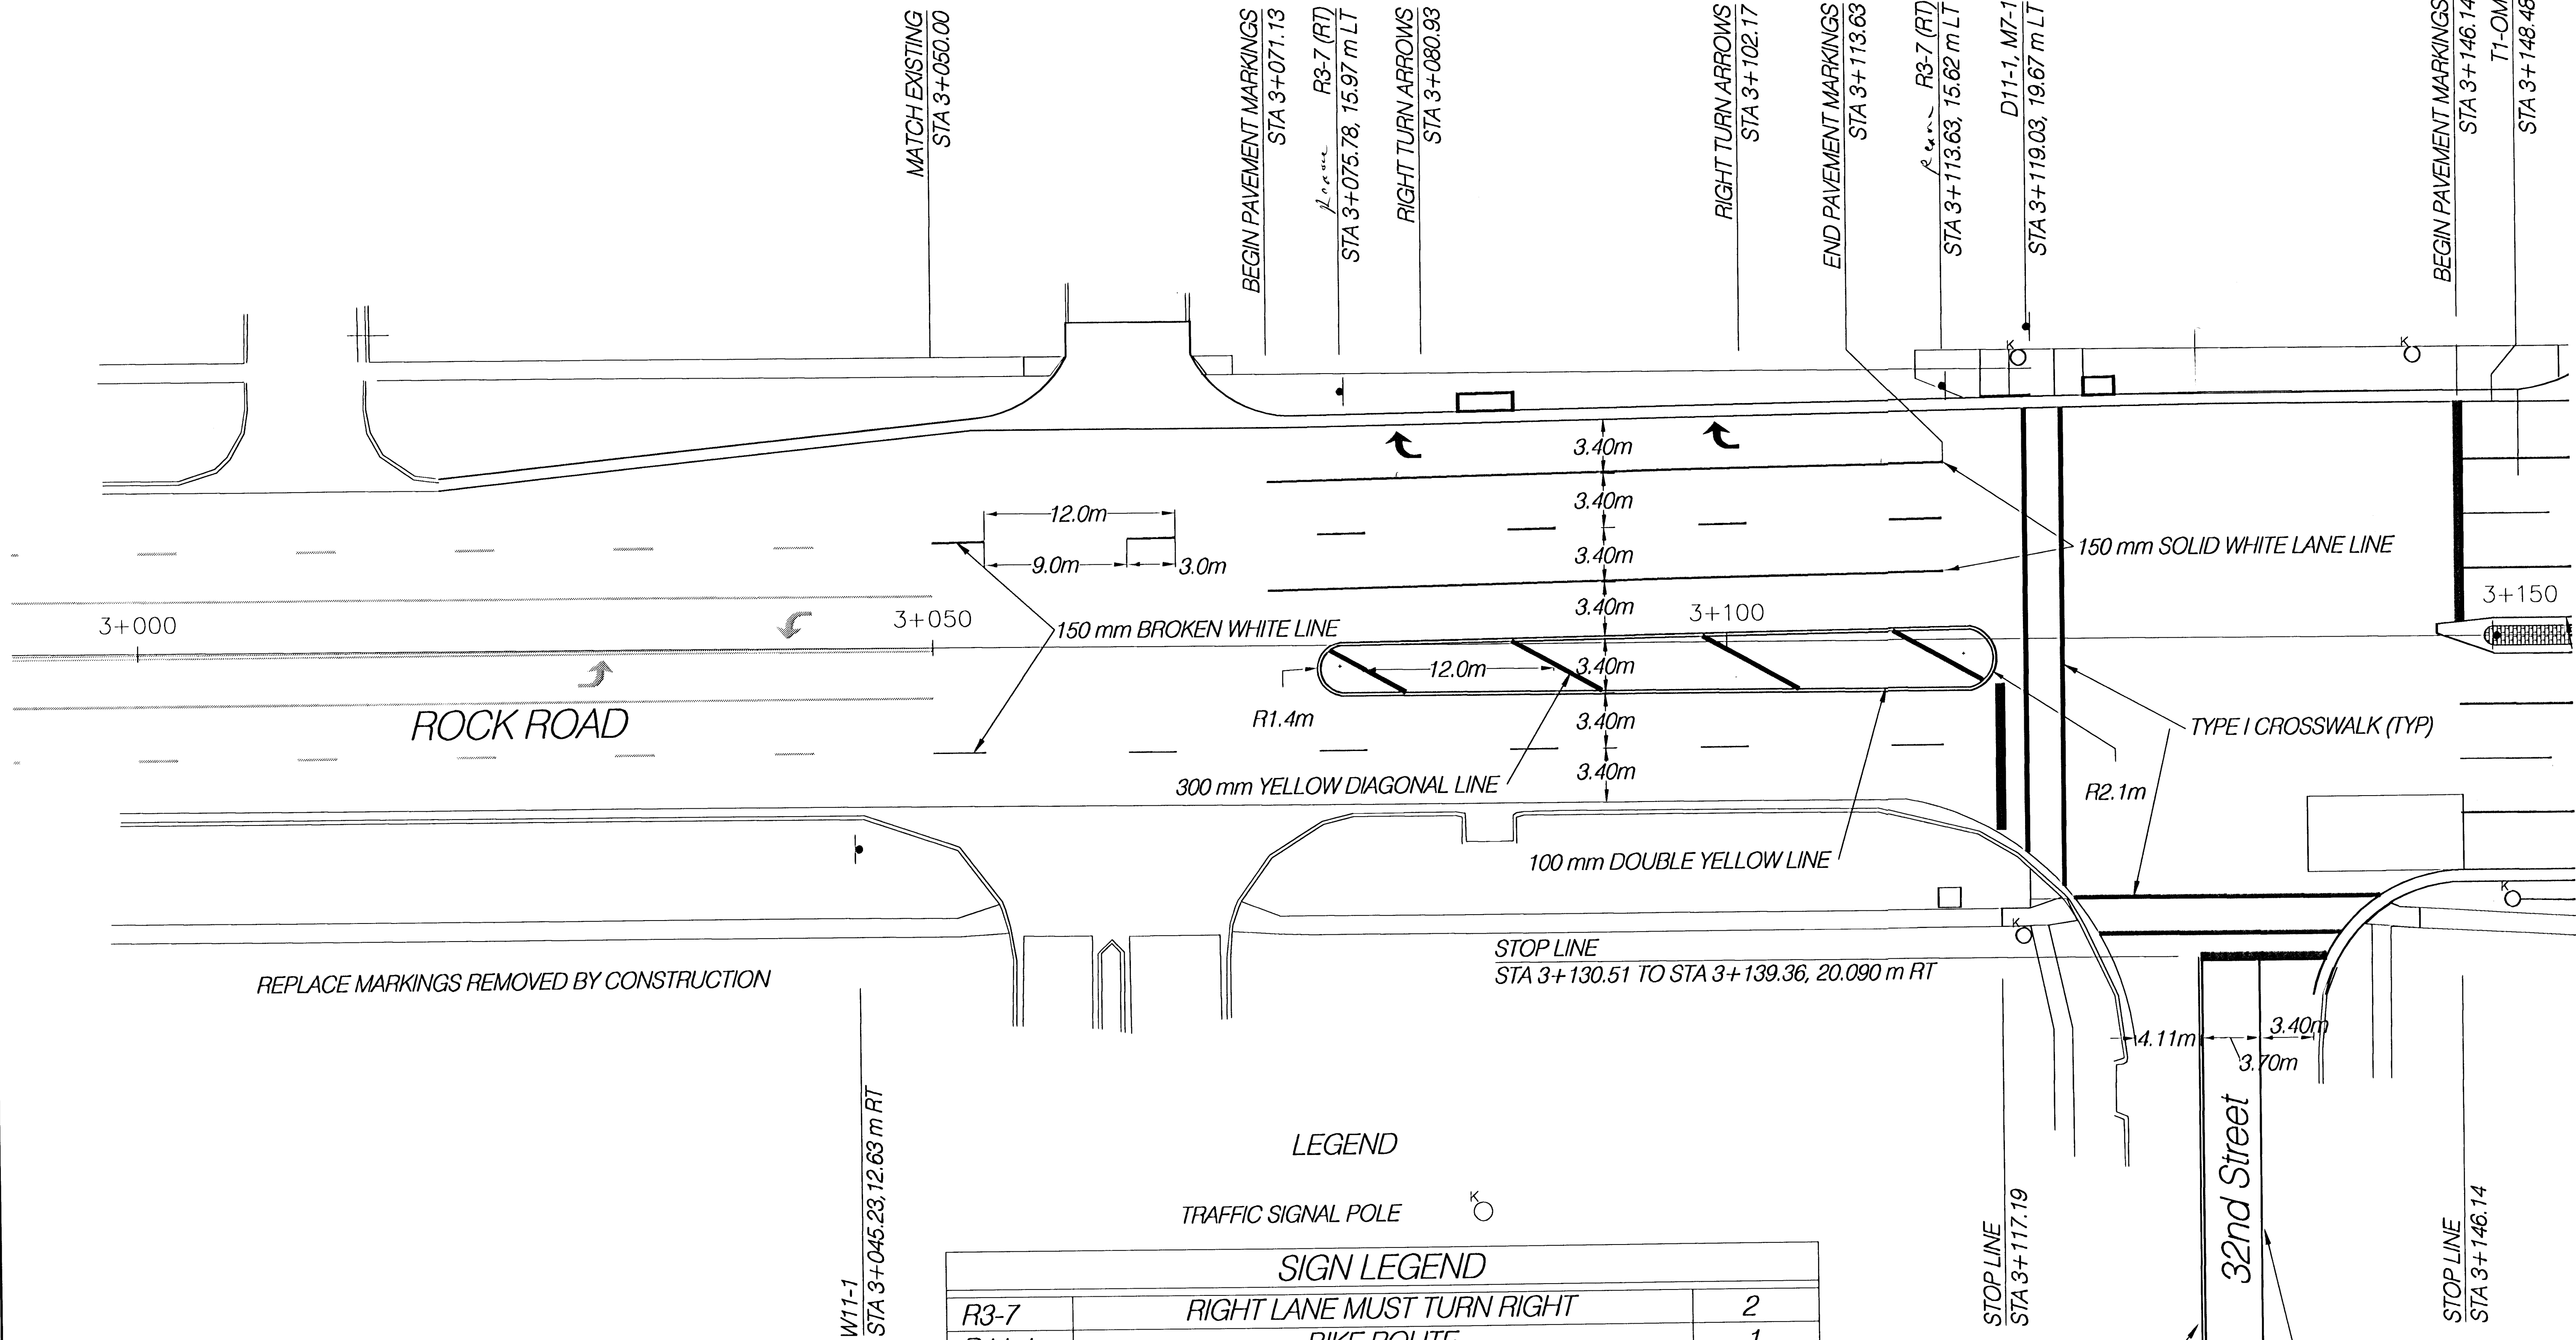

| SIGN LEGEND |                            |   |
|-------------|----------------------------|---|
| R3-7        | RIGHT LANE MUST TURN RIGHT | 2 |
| D11-1       | BIKE ROUTE                 | 1 |
| M7-1        | DIRECTIONAL ARROW          | 1 |
| W11-1       | BICYCLE CROSSING           | 1 |
| T1-OM       | TYPE I OBJECT MARKER       | 1 |
|             |                            |   |
|             |                            |   |
|             |                            |   |

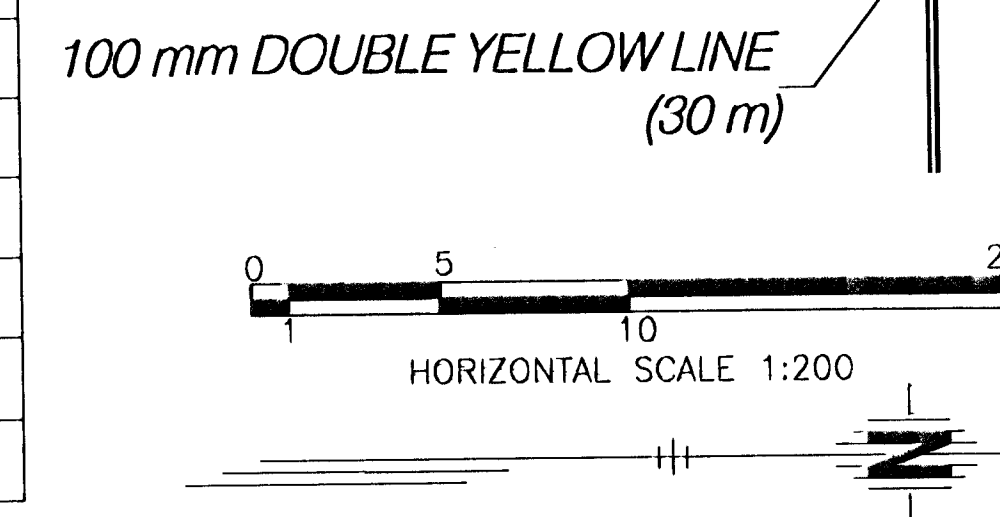

# ROCK ROAD PAVEMENT MARKINGS & SIGNING STA. 3+000 - 3+150



**HWS**  
Consulting Group Inc

Manhattan Office  
3206 Kimbail Avenue  
Manhattan, KS 66503  
Phone: (785) 539-2202  
Fax: (785) 539-2393

|              |     |                |                    |
|--------------|-----|----------------|--------------------|
| Designed By: | JJH | Checked By:    | JDM                |
| Drawn By:    | BJD | Date: 11/14/01 | Job No. 55-70-2003 |