ELECTRICAL SITE PLAN NOTES:

1. UNLESS OTHERWISE NOTED, ALL CONDUIT ROUTED ON SITE SHALL BE 1" MINIMUM.
2. ALL RISERS SHALL BE PVC COATED RIGID GALVANIZED STEEL (RGS) ALL ELLS BELOW GRADE SHALL BE PVC COATED RIGID GALVANIZED STEEL (RGS). PROVIDE WITH PVC TO STEEL ADAPTER(S) AS NECESSARY. (THIS REQUIREMENT SHALL NOT APPLY TO FIXTURE POLE BASES)
3. ALL ELECTRICAL WORK AND FEES ASSOCIATED WITH UTILITIES SHALL BE VERIFIED AND COORDINATED WITH LOCAL SERVICE PROVIDER PRIOR TO BID.
4. CONTRACTOR SHALL REFERENCE ALL RELATED CONTRACT DOCUMENTS, SITE SURVEY, AND OTHER RESOURCES FOR POSSIBLE CONFLICTS WITH OTHER UNDERGROUND UTILITIES. AT UTILITY CROSSINGS, CONTRACTOR SHALL VERIFY UTILITY DEPTHS AND COORDINATE CONDUIT ROUTING AS NECESSARY.
5. CONTRACTOR SHALL VERIFY AND COORDINATE EXISTING CONDITIONS OF PROJECT SITE PRIOR TO BID.

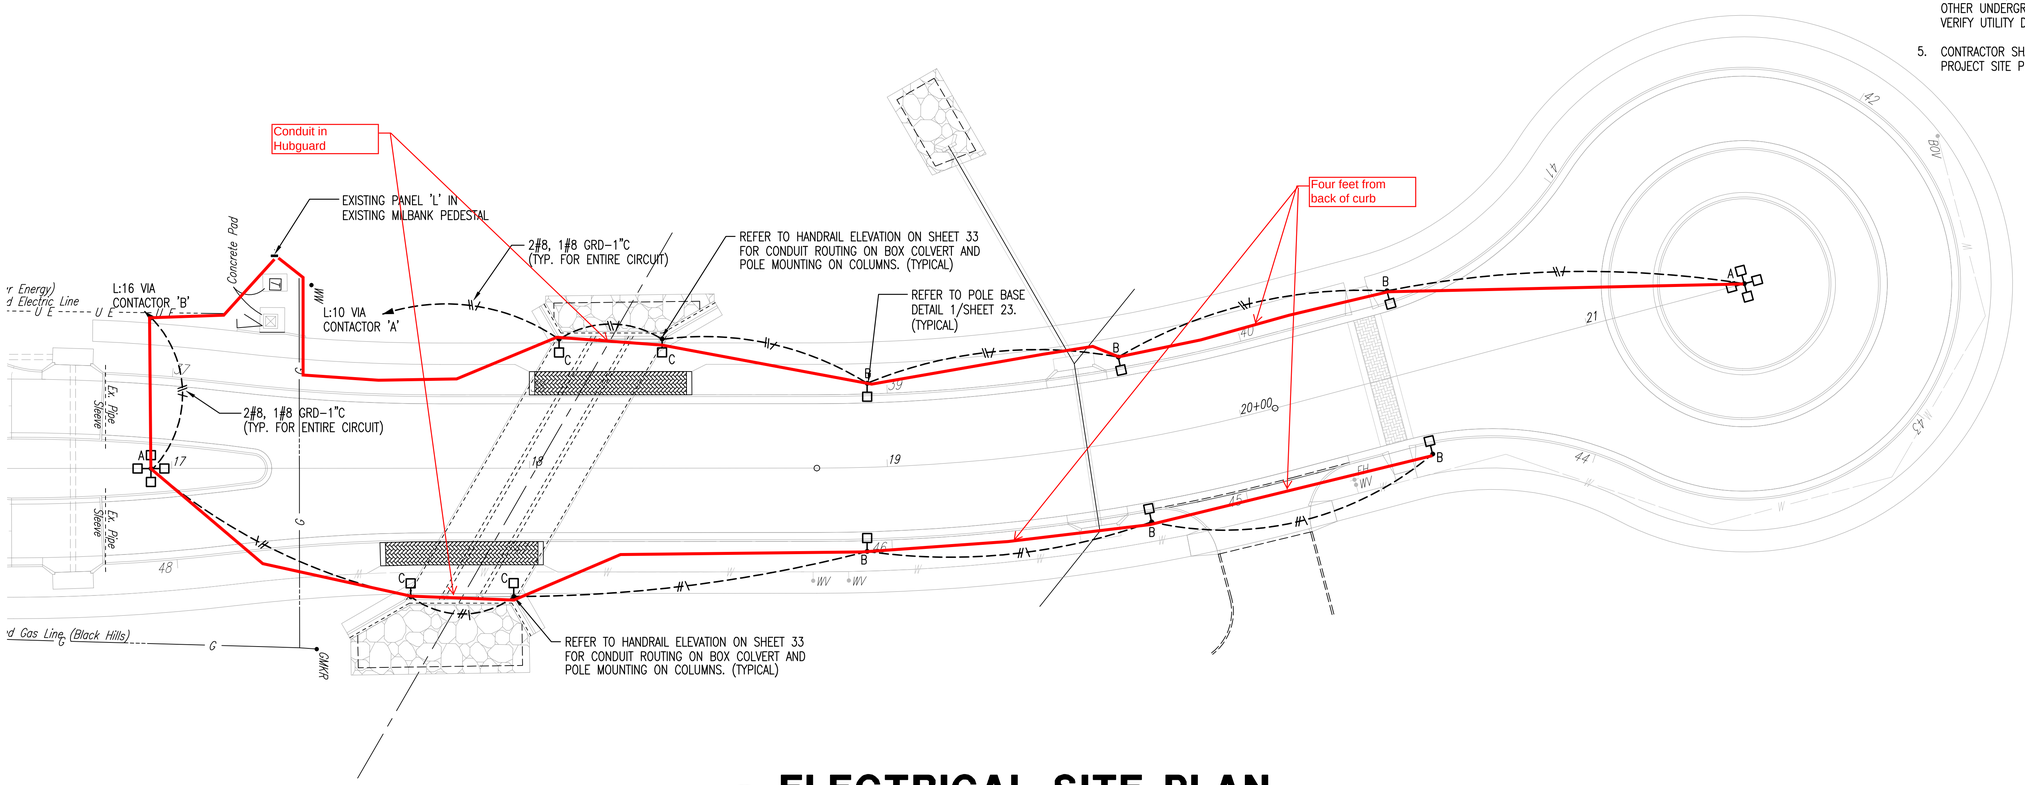

A ELECTRICAL SITE PLAN

0' 20' 40' 60'

1" = 20'-0"

W S N E

Saved 11-02-2015 3:12:03 PM by CAMERON.SLOAN
Plot Scale 1:1 11-02-2015 3:52:29 PM by CAMERON.SLOAN
U:\wichita-civil\2015\15120\001\Dwg\[15120-001-E3 ELECTRICAL PLAN

No.	Revision	By	Date

NEWMARKET OFFICE 2ND-PHASE 2
PAVING AND INCIDENTAL DRAINAGE IMPROVEMENTS

ELECTRICAL PLAN

GARY JANZEN, P.E.- CITY ENGINEER
CITY OF WICHITA PROJECT NO. 472-84991

HOANG V. VO LICENSED 23143 11/02/2015 KANSAS PROFESSIONAL ENGINEER

PEC
PROFESSIONAL ENGINEERING CONSULTANTS, P.A.
303 SOUTH TOPEKA WICHITA, KS 67202
316-262-2691 www.pec1.com

Designed by DCG	Job No. 35-15120-001	Sht. 24 of 36
Drawn by KAB	Date October 2015	