BENCHMARK:
BM #8 – Chiseled "□" on West Curb Return on the Southwest Corner of Meridian and McCormick Elev. = 1297.18 (NAVD 88)

REGION NO.	STATE	PROJECT NO.	FISCAL YEAR	SHEET NO.	TOTAL SHEETS
7	KANSAS	087 N-0593-01	2015	49	153

SCALE:
HORIZONTAL: 1" = 20'
VERTICAL: 1" = 5'

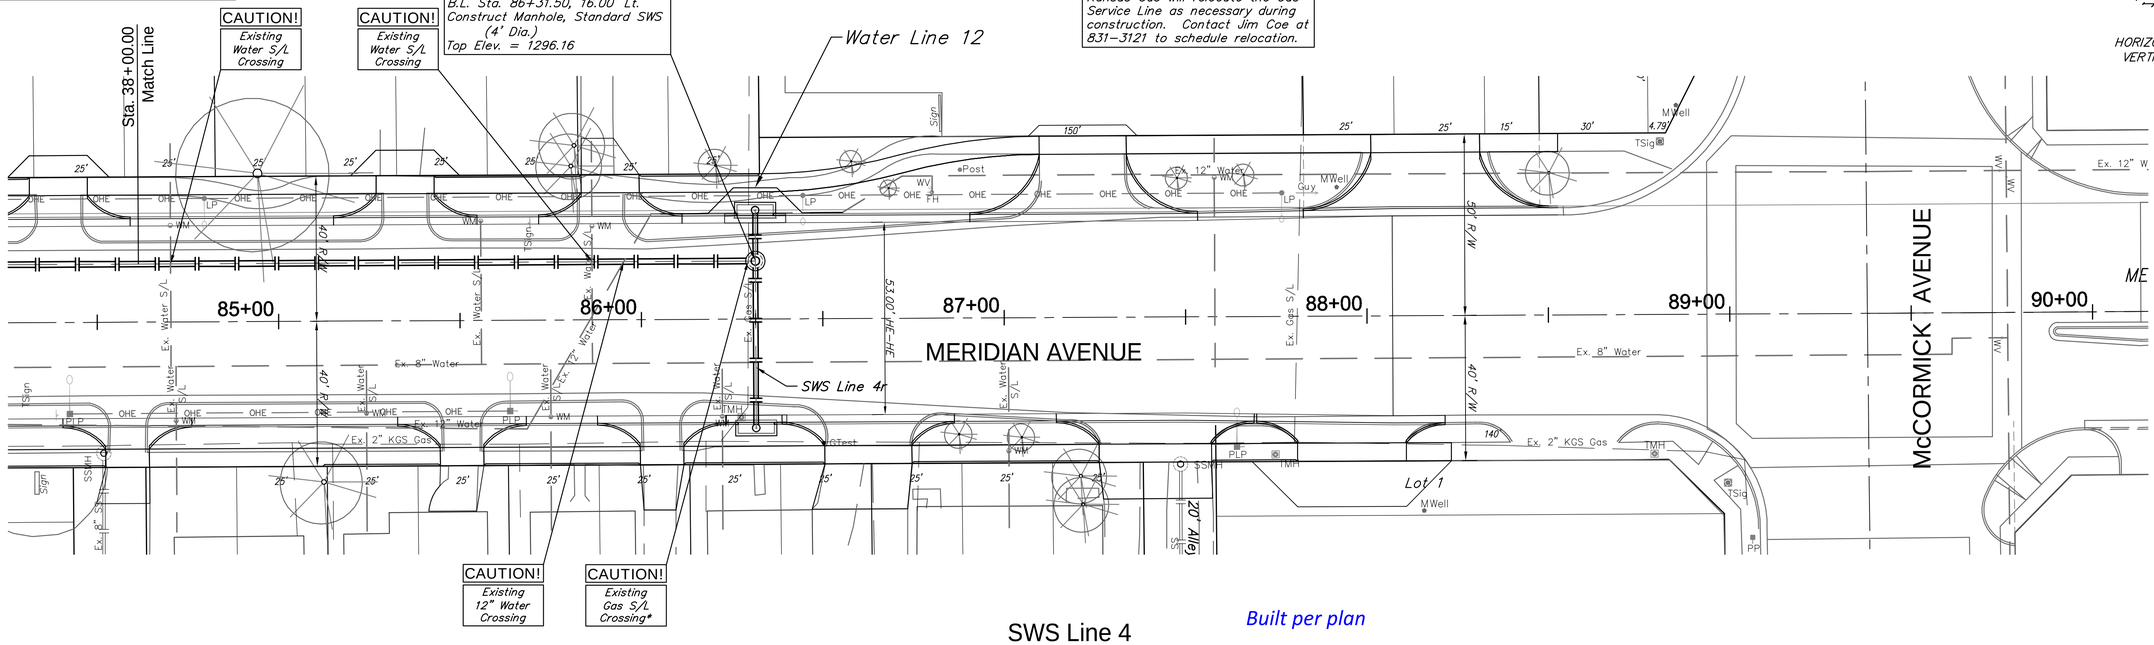

SWS Line 4

Built per plan

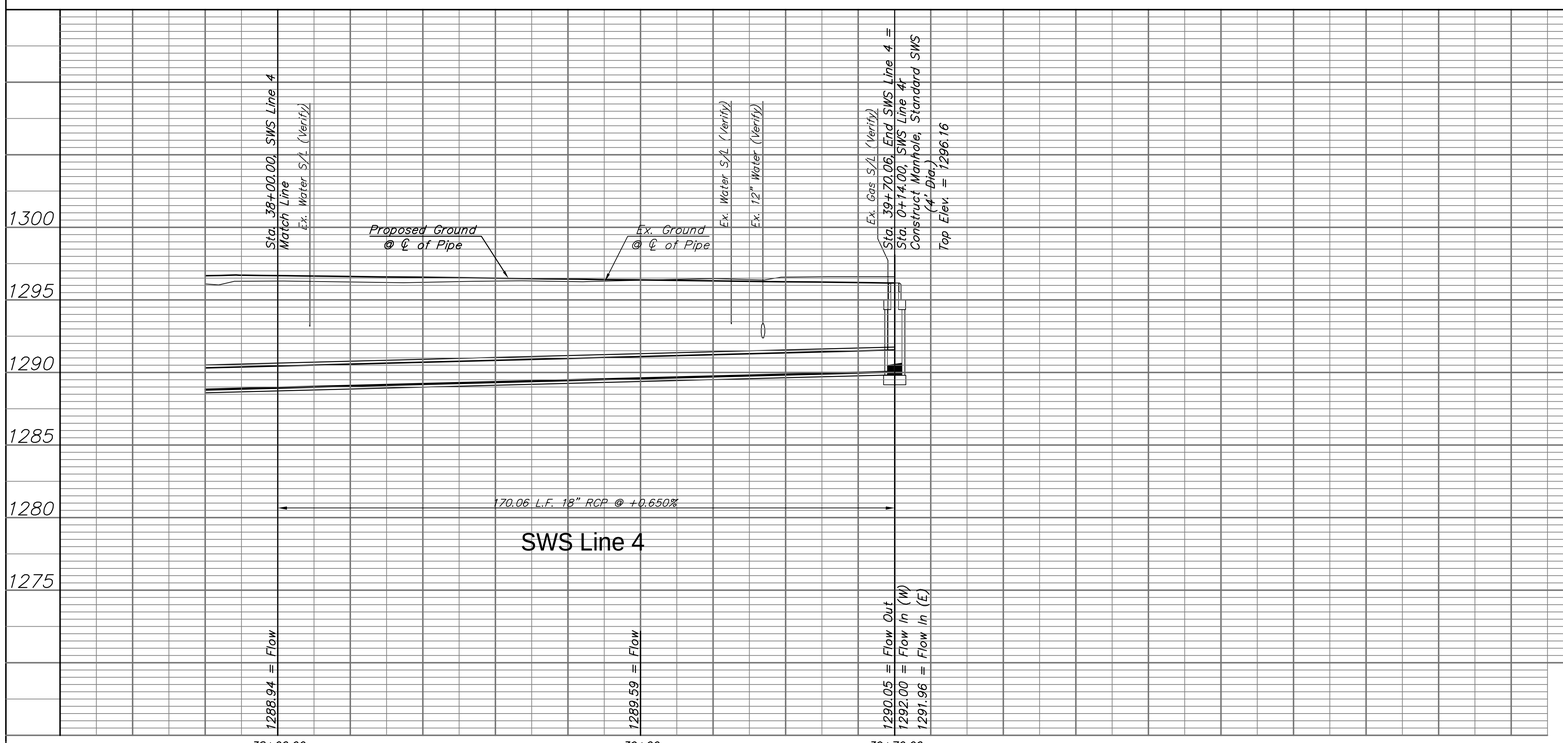

SWS Line 4

Drawing File: E:\Projects\Meridian-Orient to McCormick\Civil 3d\Meridian Base.dwg [SWS 13]

Design: TPV
Drawn: STAFF
Approved: TPV
Scale: NOTED

Project No. 1004-E493 CAPITAL IMPROVEMENT PROJECT

MERIDIAN AVENUE SWS PLAN & PROFILE
SWS Line 4 - Sta. 38+00.00 to Sta. 39+70.06
MERIDIAN AVENUE - PAWNEE AVENUE to McCORMICK AVENUE

Baughman Company , P.A.
315 Ellis St. Wichita, KS 67211 P 316-262-7271 F 316-262-0149
ENGINEERING | SURVEYING | PLANNING | LANDSCAPE ARCHITECTURE

May 2015

SHEET 49 OF 153