


BUILT PER PLAN

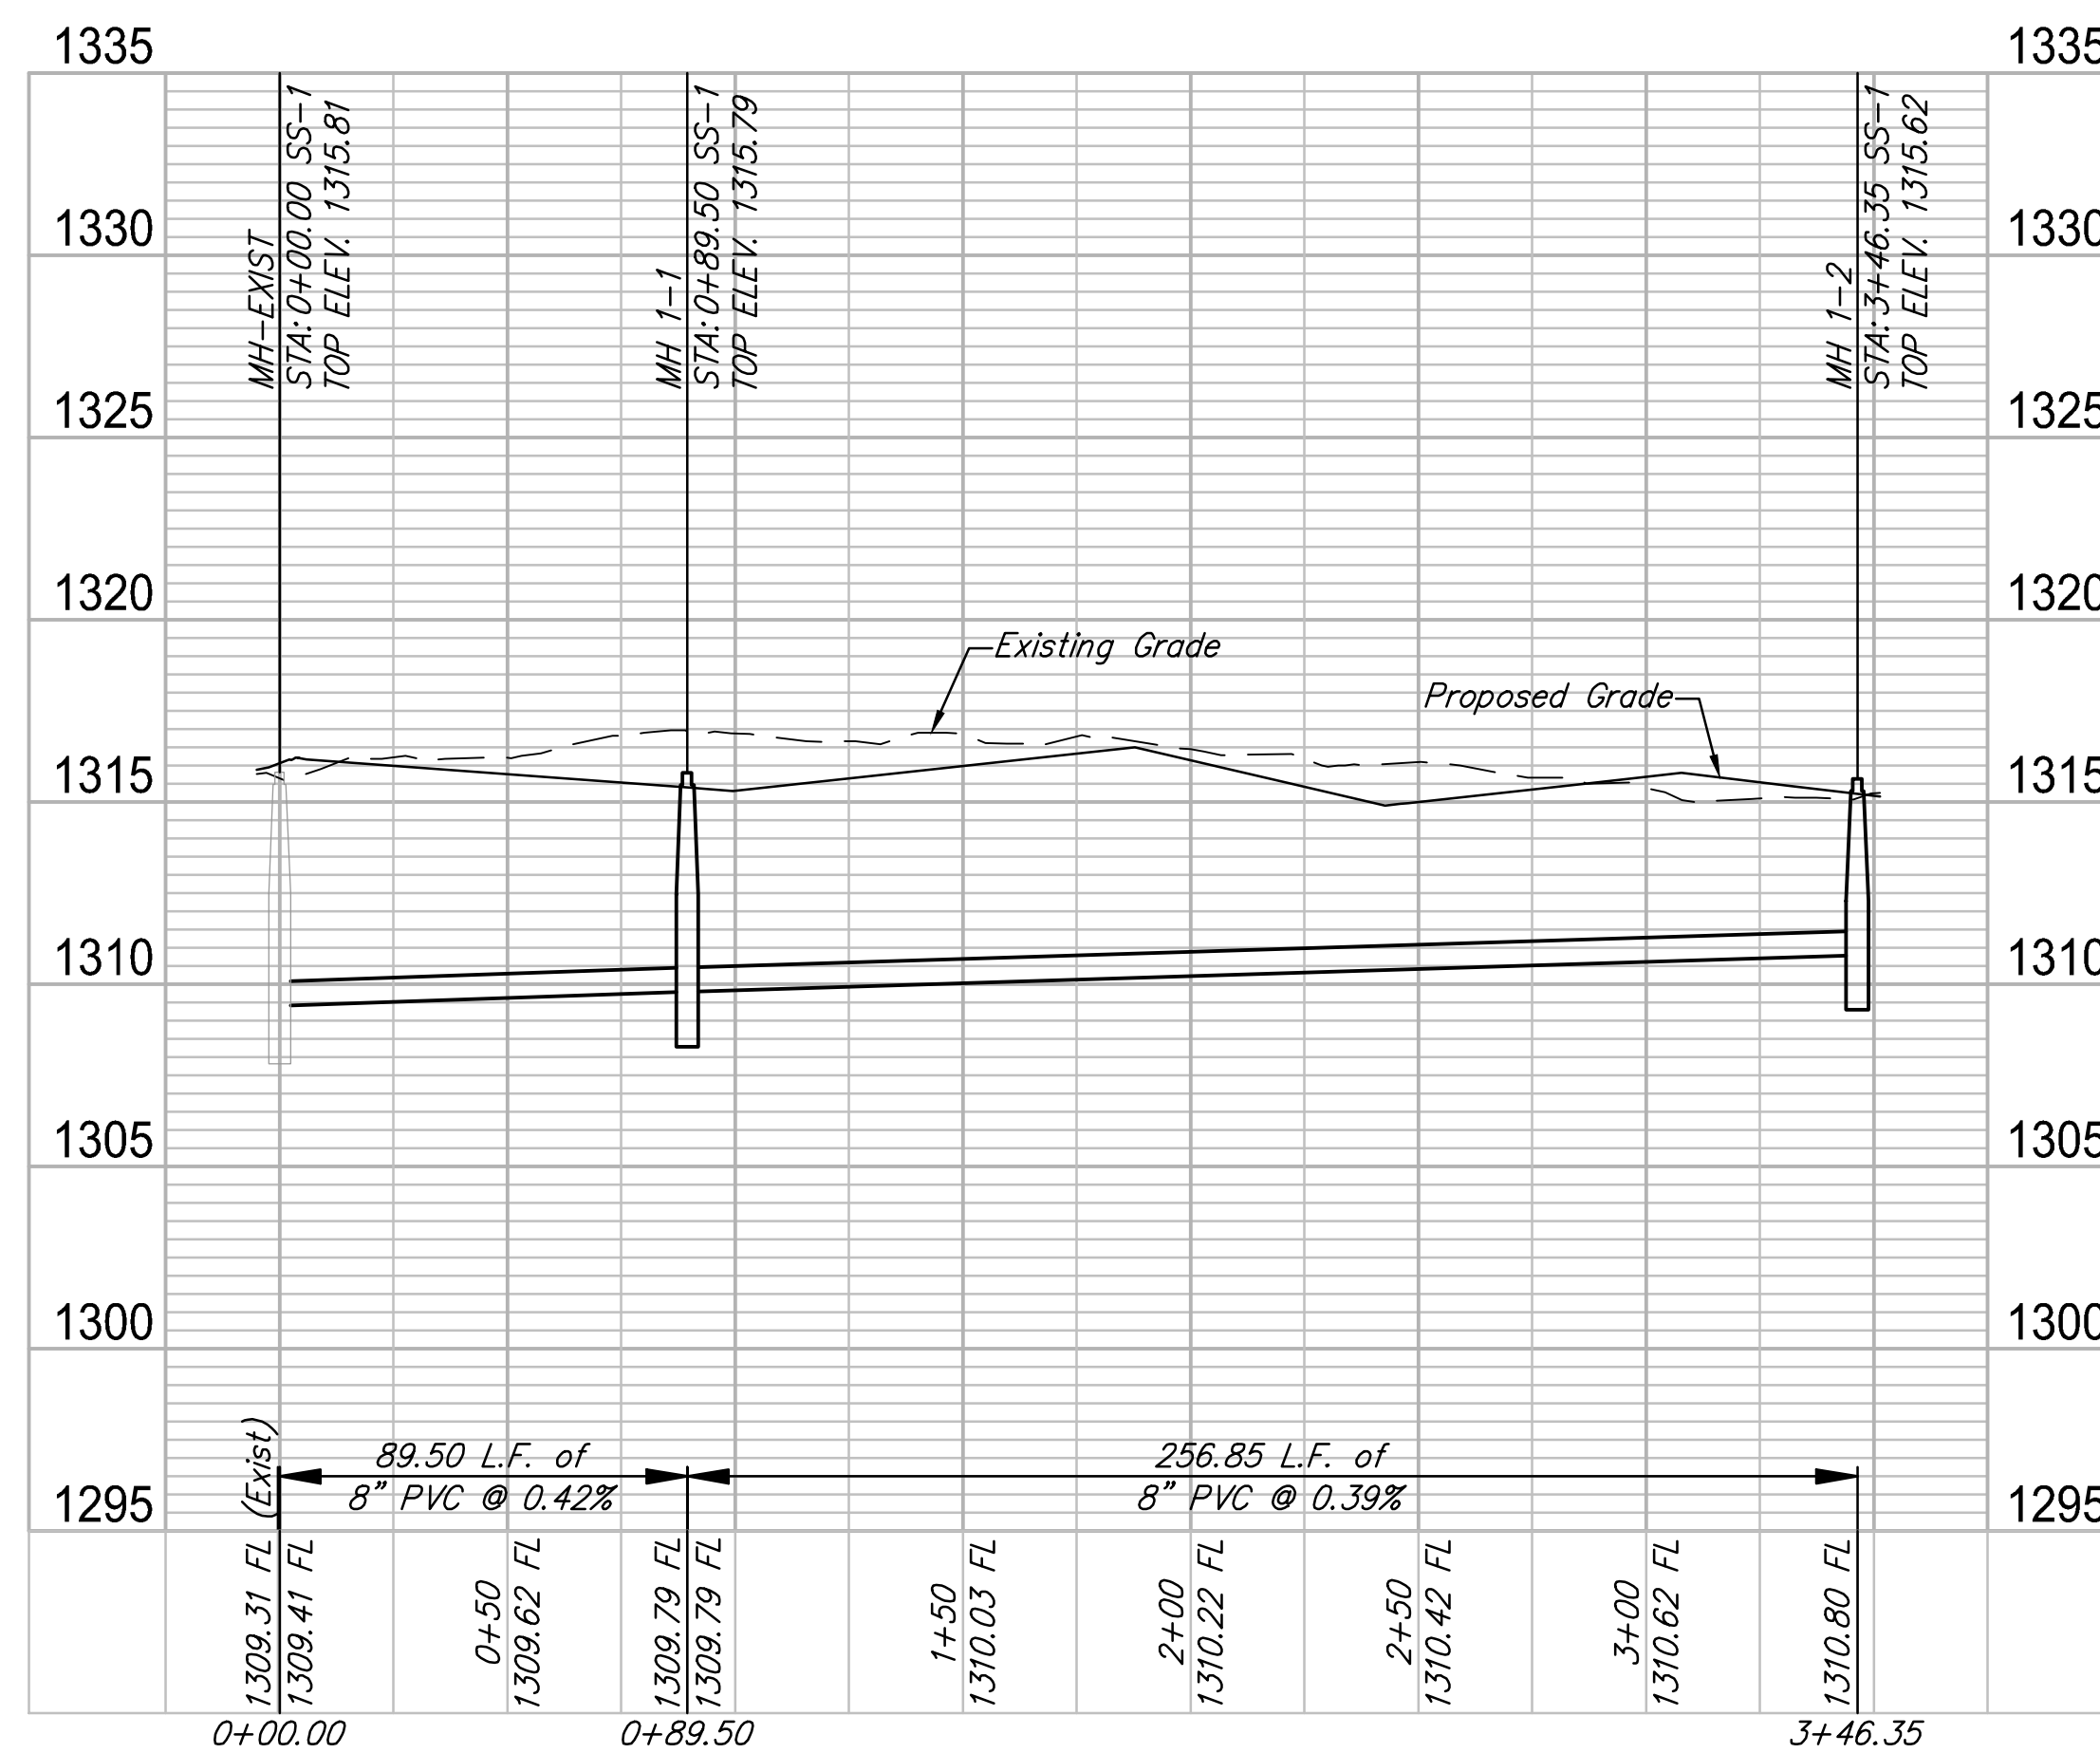

REVIEW	7-17-17
DATE	7-17-2017
DESIGN	KWL
DRAWN	KWL
PROJECT NUMBER	468-85199
DRAWING FILE	SS Line 1 [SS Line 1]
Chisholm Cove Addition SS Line 1 Wichita, Kansas	
REVISION	4866E
SHEET	2
OF	15