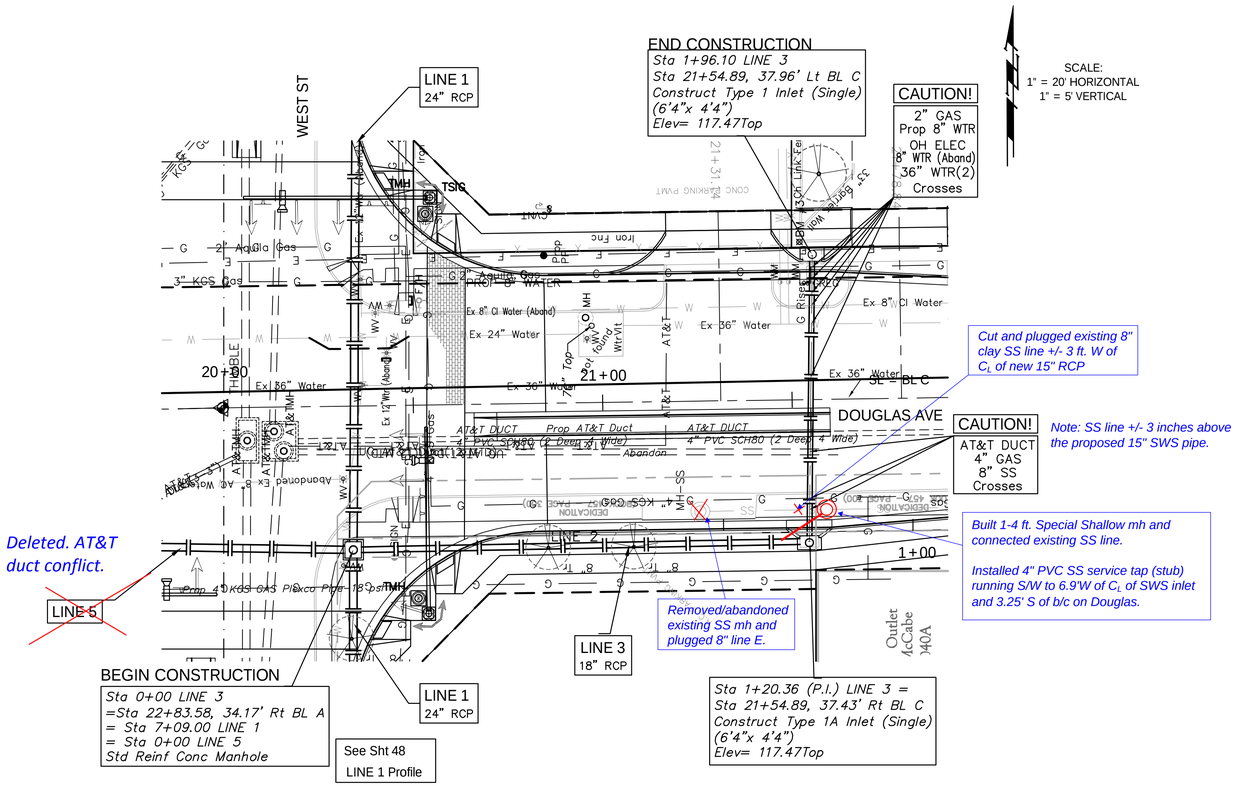

NOTE:
FOR LINE 4 LOCATION,
SEE KDOT PROJECT 87N-0459-01, SHEET 13.

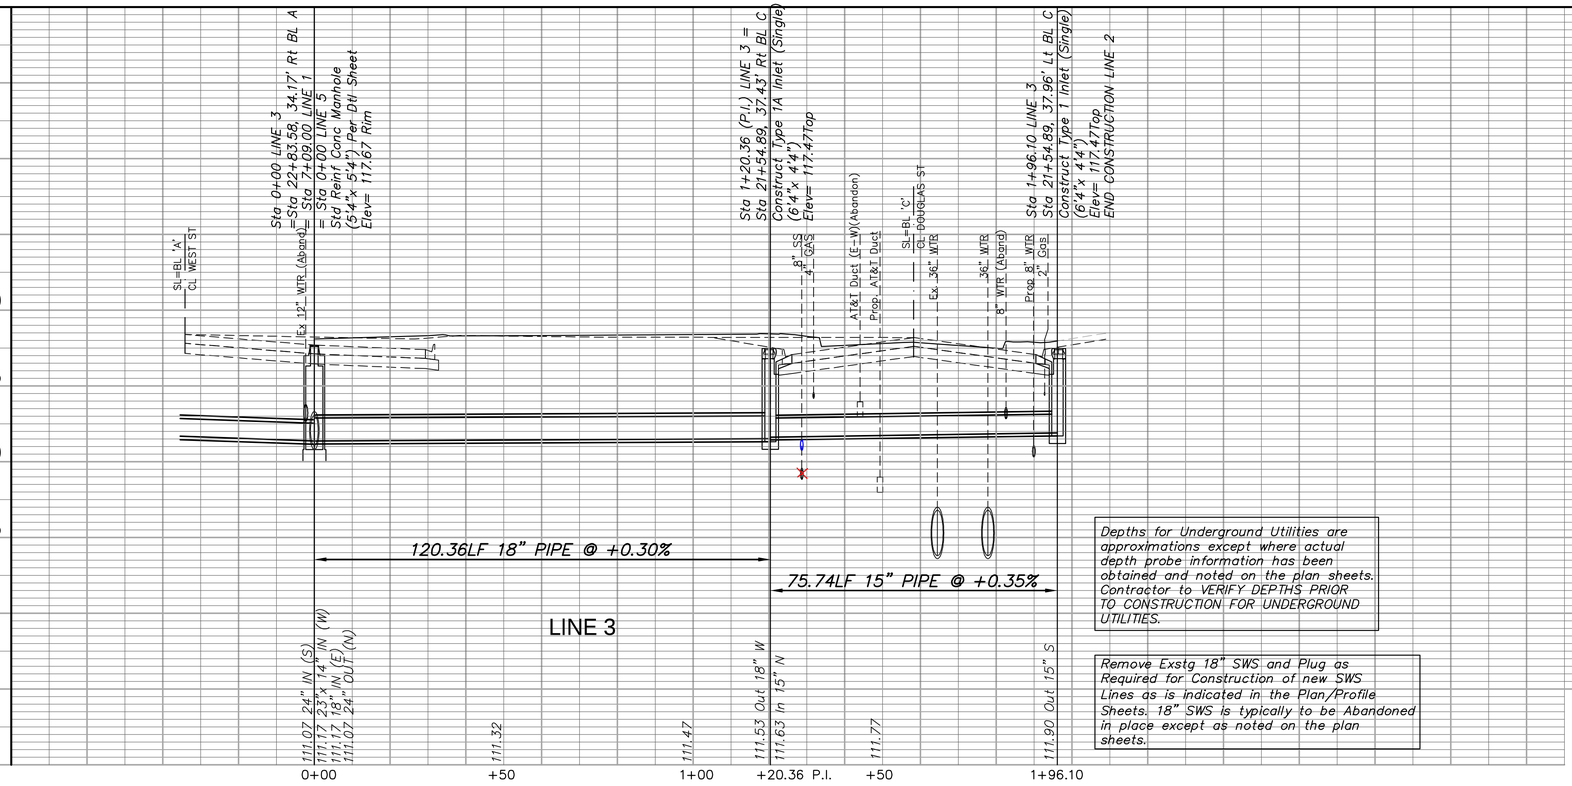

Depths for Underground Utilities are approximations except where actual depth probe information has been obtained and noted on the plan sheets. Contractor to VERIFY DEPTHS PRIOR TO CONSTRUCTION FOR UNDERGROUND UTILITIES.

Remove Exstg 18" SWS and Plug as Required for Construction of new SWS Lines as is indicated in the Plan/Profile Sheets. 18" SWS is typically to be Abandoned in place except as noted on the plan sheets.

Drawing File: E:\\West St.\Land\Dwg\swsBase — November 2008

Design:	T. Aziere
Drawn:	Sonny
Approved:	J. F. Bradley
Scale:	1:20

Project No. 0404-E859 CAPITAL IMPROVEMENT PROJECT

SWS LINE 3 - Sta 0+00 to Sta 1+96.10

STORM WATER SEWER IMPROVEMENTS

Baughman Company, P.A.
315 Ellis St. Wichita, KS 67211 P 316-262-7271 F 316-262-0149
ENGINEERING | SURVEYING | PLANNING | LANDSCAPE ARCHITECTURE