



FHWA REGION NO.	STATE	PROJECT NO.	YEAR	SHEET NO.	TOTAL SHEETS
7	KS.	87-U-1362-01	1993	7	149

Revised: See At Bottom of this Sheet.

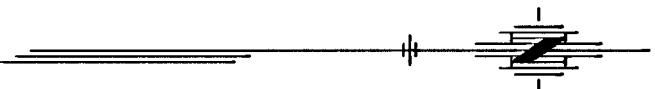

SCALE: 1"=20'

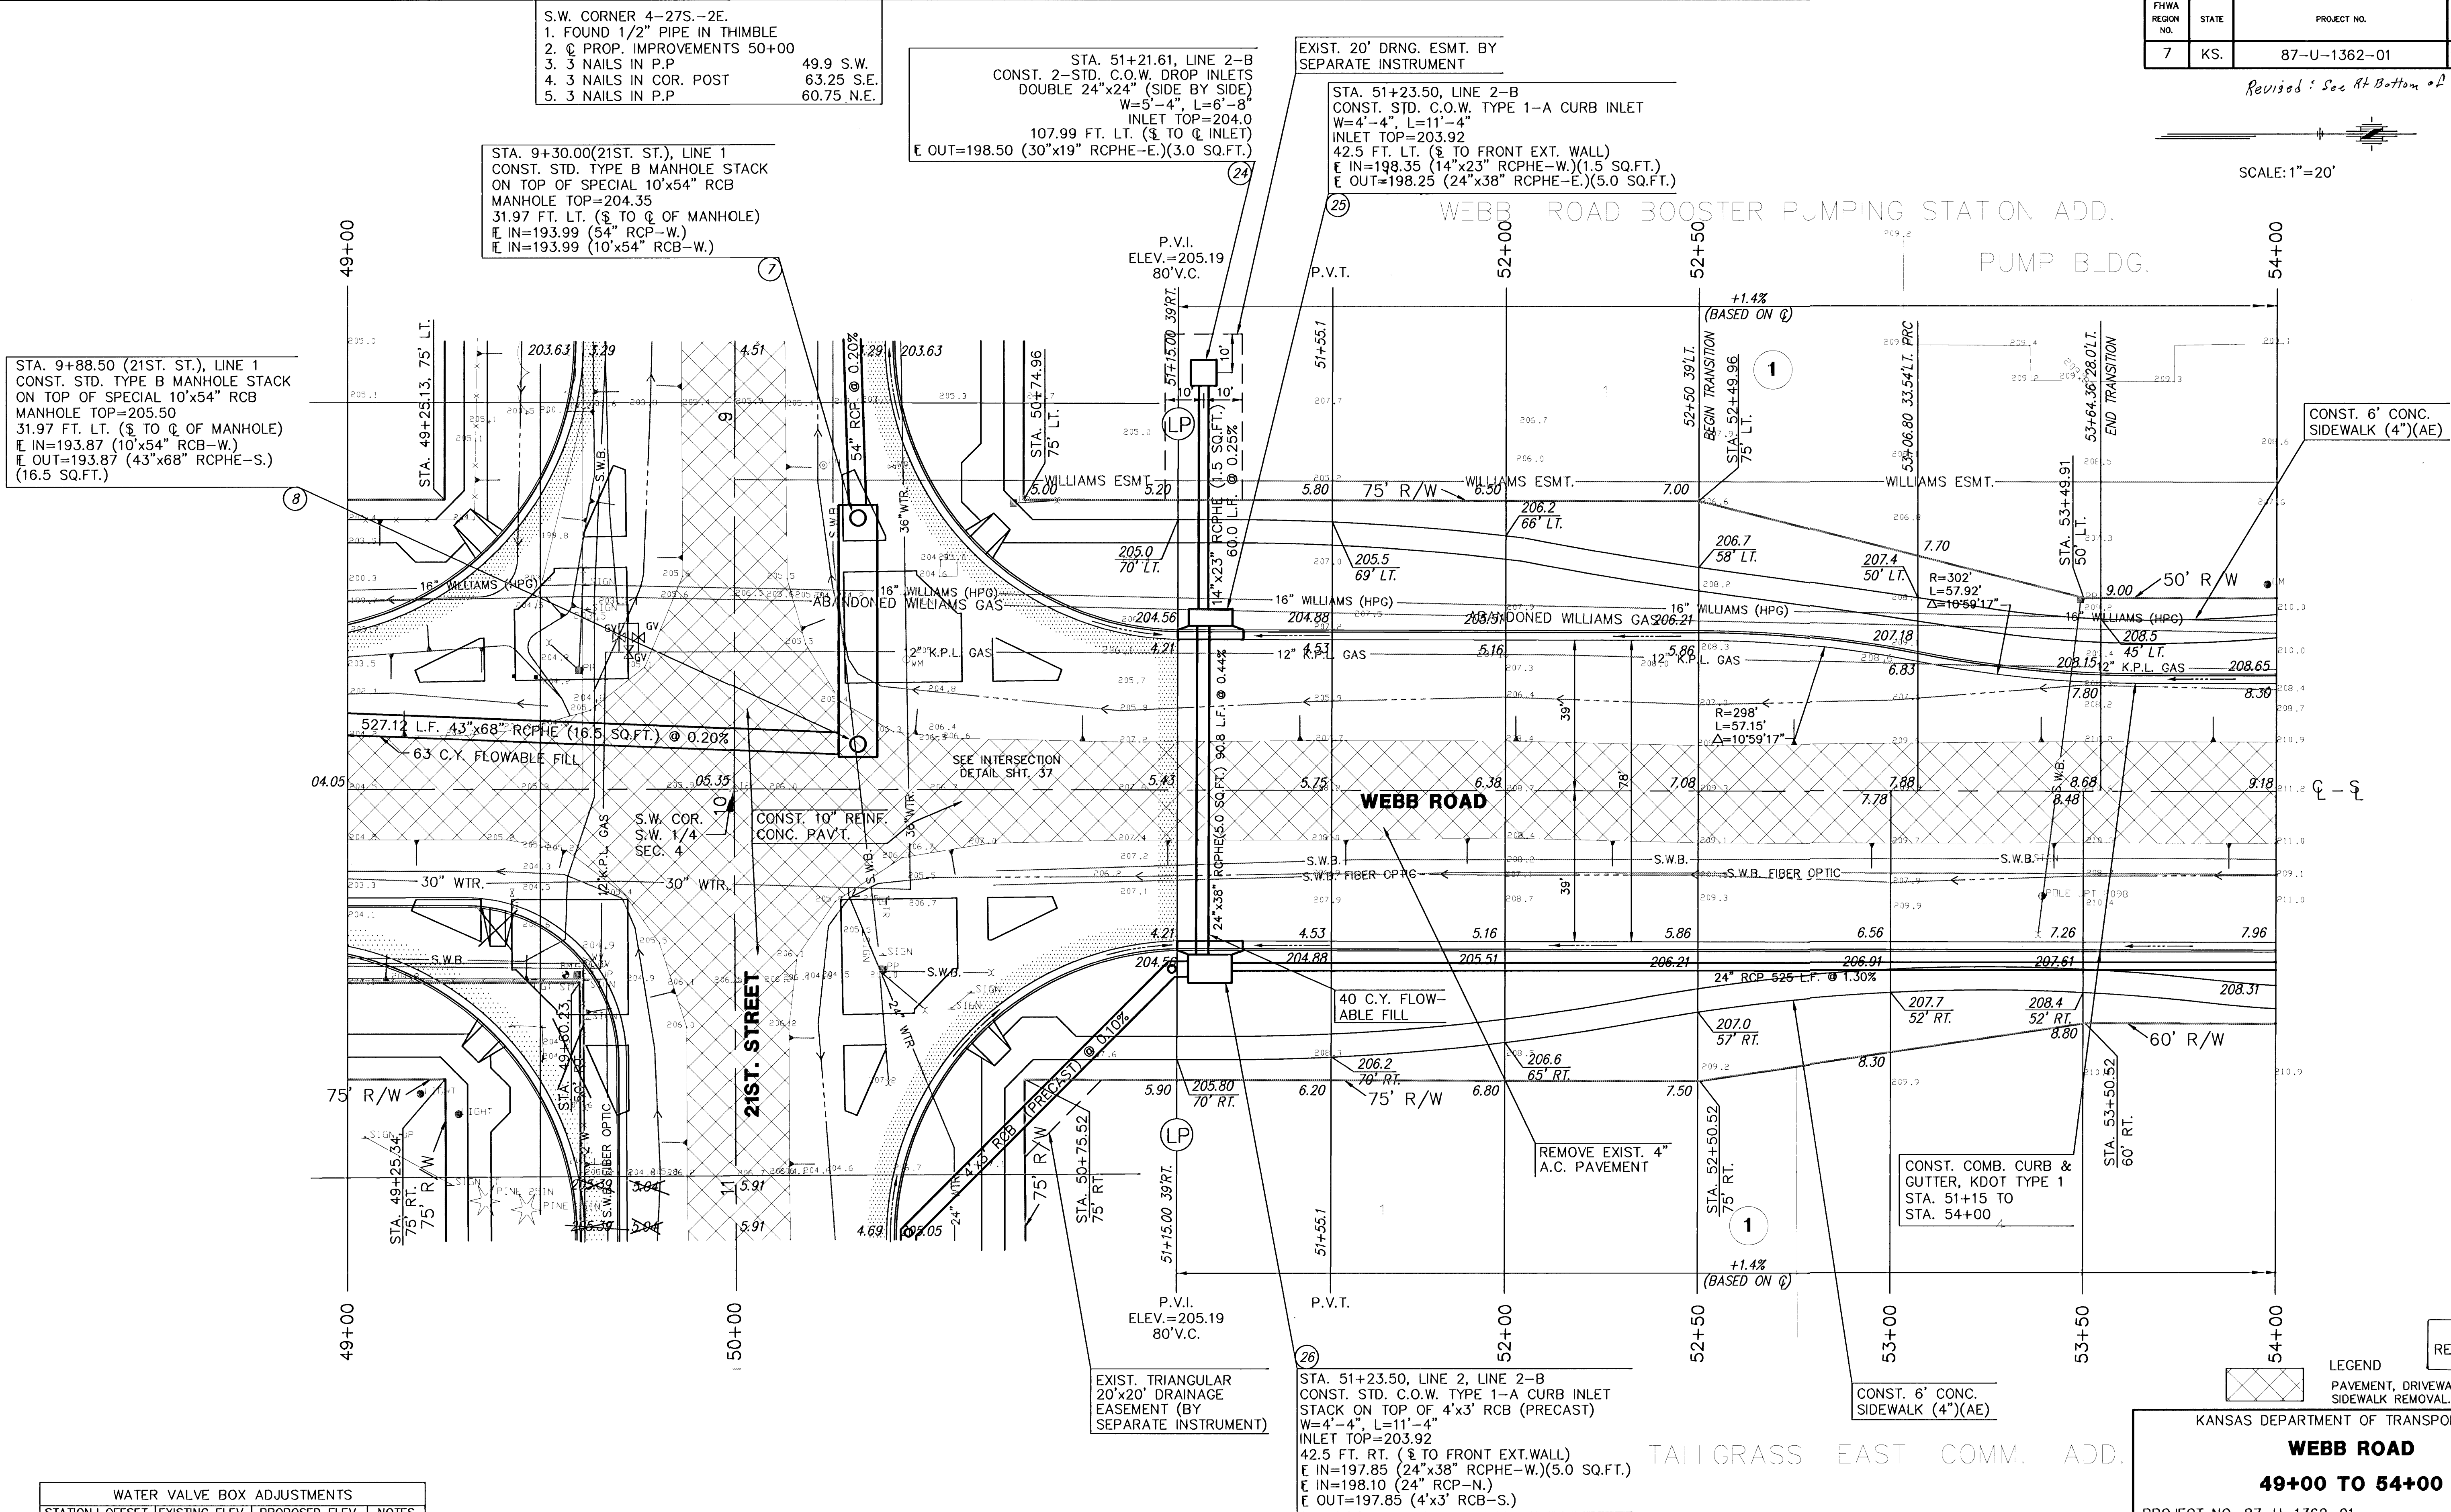

STA. 9+88.50 (21ST. ST.), LINE 1
CONST. STD. TYPE B MANHOLE STACK
ON TOP OF SPECIAL 10'x54" RCB
MANHOLE TOP=205.50
31.97 FT. LT. (\$ TO Q OF MANHOLE)
E IN=193.87 (10'x54" RCB-W.)
E OUT=193.87 (43"x68" RCPHE-S.)
(16.5 SQ.FT.)

STA. 9+30.00(21ST. ST.), LINE 1
CONST. STD. TYPE B MANHOLE STACK
ON TOP OF SPECIAL 10'x54" RCB
MANHOLE TOP=204.35
31.97 FT. LT. (\$ TO Q OF MANHOLE)
E IN=193.99 (54" RCP-W.)
E IN=193.99 (10'x54" RCB-W.)

STA. 51+21.61, LINE 2-B
CONST. 2-STD. C.O.W. DROP INLETS
DOUBLE 24"x24" (SIDE BY SIDE)
W=5'-4", L=6'-8"
INLET TOP=204.0
107.99 FT. LT. (\$ TO Q INLET)
E OUT=198.50 (30"x19" RCPHE-E.)(3.0 SQ.FT.)

EXIST. 20' DRNG. ESMT. BY
SEPARATE INSTRUMENT

STA. 51+23.50, LINE 2-B
CONST. STD. C.O.W. TYPE 1-A CURB INLET
W=4'-4", L=11'-4"
INLET TOP=203.92
42.5 FT. LT. (\$ TO FRONT EXT. WALL)
E IN=198.35 (14"x23" RCPHE-W.)(1.5 SQ.FT.)
E OUT=198.25 (24"x38" RCPHE-E.)(5.0 SQ.FT.)

CONST. 6' CONC.
SIDEWALK (4") (AE)

WEBB ROAD

CL-S

WATER VALVE BOX ADJUSTMENTS				
STATION	OFFSET	EXISTING ELEV.	PROPOSED ELEV.	NOTES
49+43	27'R	205.21	203.80	W.V.
49+62	45'R	206.78		R.W.D.W.V.
50+23	84'L	RELOCATED BY CITY		FH
50+40	84'L	RELOCATED BY CITY		W.V.
50+45	34'L	204.42	204.95	W.M.

CITY OF WICHITA WATER DEPARTMENT	268-4908
KANSAS GAS & ELECTRIC (K.G.&E.)	264-1141
KPL GAS SERVICE CO.	263-7511
RURAL WATER DISTRICT	832-0213
SOUTHWESTERN BELL TELEPHONE CO.	1-571-2611
WILLIAMS PIPELINE	524-4390

BM #2 STANDARD CITY OF WICHITA DISC, WEBB RD.
48' RT., STA. 49+56.5 ELEV.=205.238

REVISED 11/01/93

LEGEND
PAVEMENT, DRIVEWAY AND/OR
SIDEWALK REMOVAL.

KANSAS DEPARTMENT OF TRANSPORTATION			
WEBB ROAD			
49+00 TO 54+00			
PROJECT NO. 87-U-1362-01		SEDGWICK CO.	
MID-KANSAS ENGINEERING CONSULTANTS, INC.			
WICHITA, KANSAS			
DESIGNED BY:	GJA	CHECKED BY:	DLH & KJS
DRAWN BY:	DLM	DATE:	SHEET 7 OF 149