FHWA REGION NO.	STATE	PROJECT NO.	YEAR	SHEET NO.	TOTAL SHEETS
7	KS.	87-U-1362-01	1993	35	149

P.O.T.
1. P.K. NAIL & DISC ON SOUTH LINE S.W. 1/4 4-27S.-2E.
2. ℄ PROP. IMPROVEMENTS STA. 29+50.54
3. NAIL & DISC IN EAST SIDE P.P. 39.2 S.
4. NAIL & DISC IN EAST SIDE GATE POST 76.15 S.E.
5. P.K. NAIL IN NOSE OF MEDIAN CURB 66.85 N.E.
21ST. ST. NORTH & CLUBHOUSE

SOUTH 1/4 CORNER 4-27S.-2E.
1. FOUND 1/2" BAR
2. ℄ PROP. IMPROVEMENTS STA. 36+49.40
3. 3 NAILS IN COR. POST 39.9 S.
4. 3 NAILS IN FC POST 46.5 S.W.
5. 3 NAILS IN FC POST 63.55 S.E.

Revised: See Bottom Rt of this Sheet.

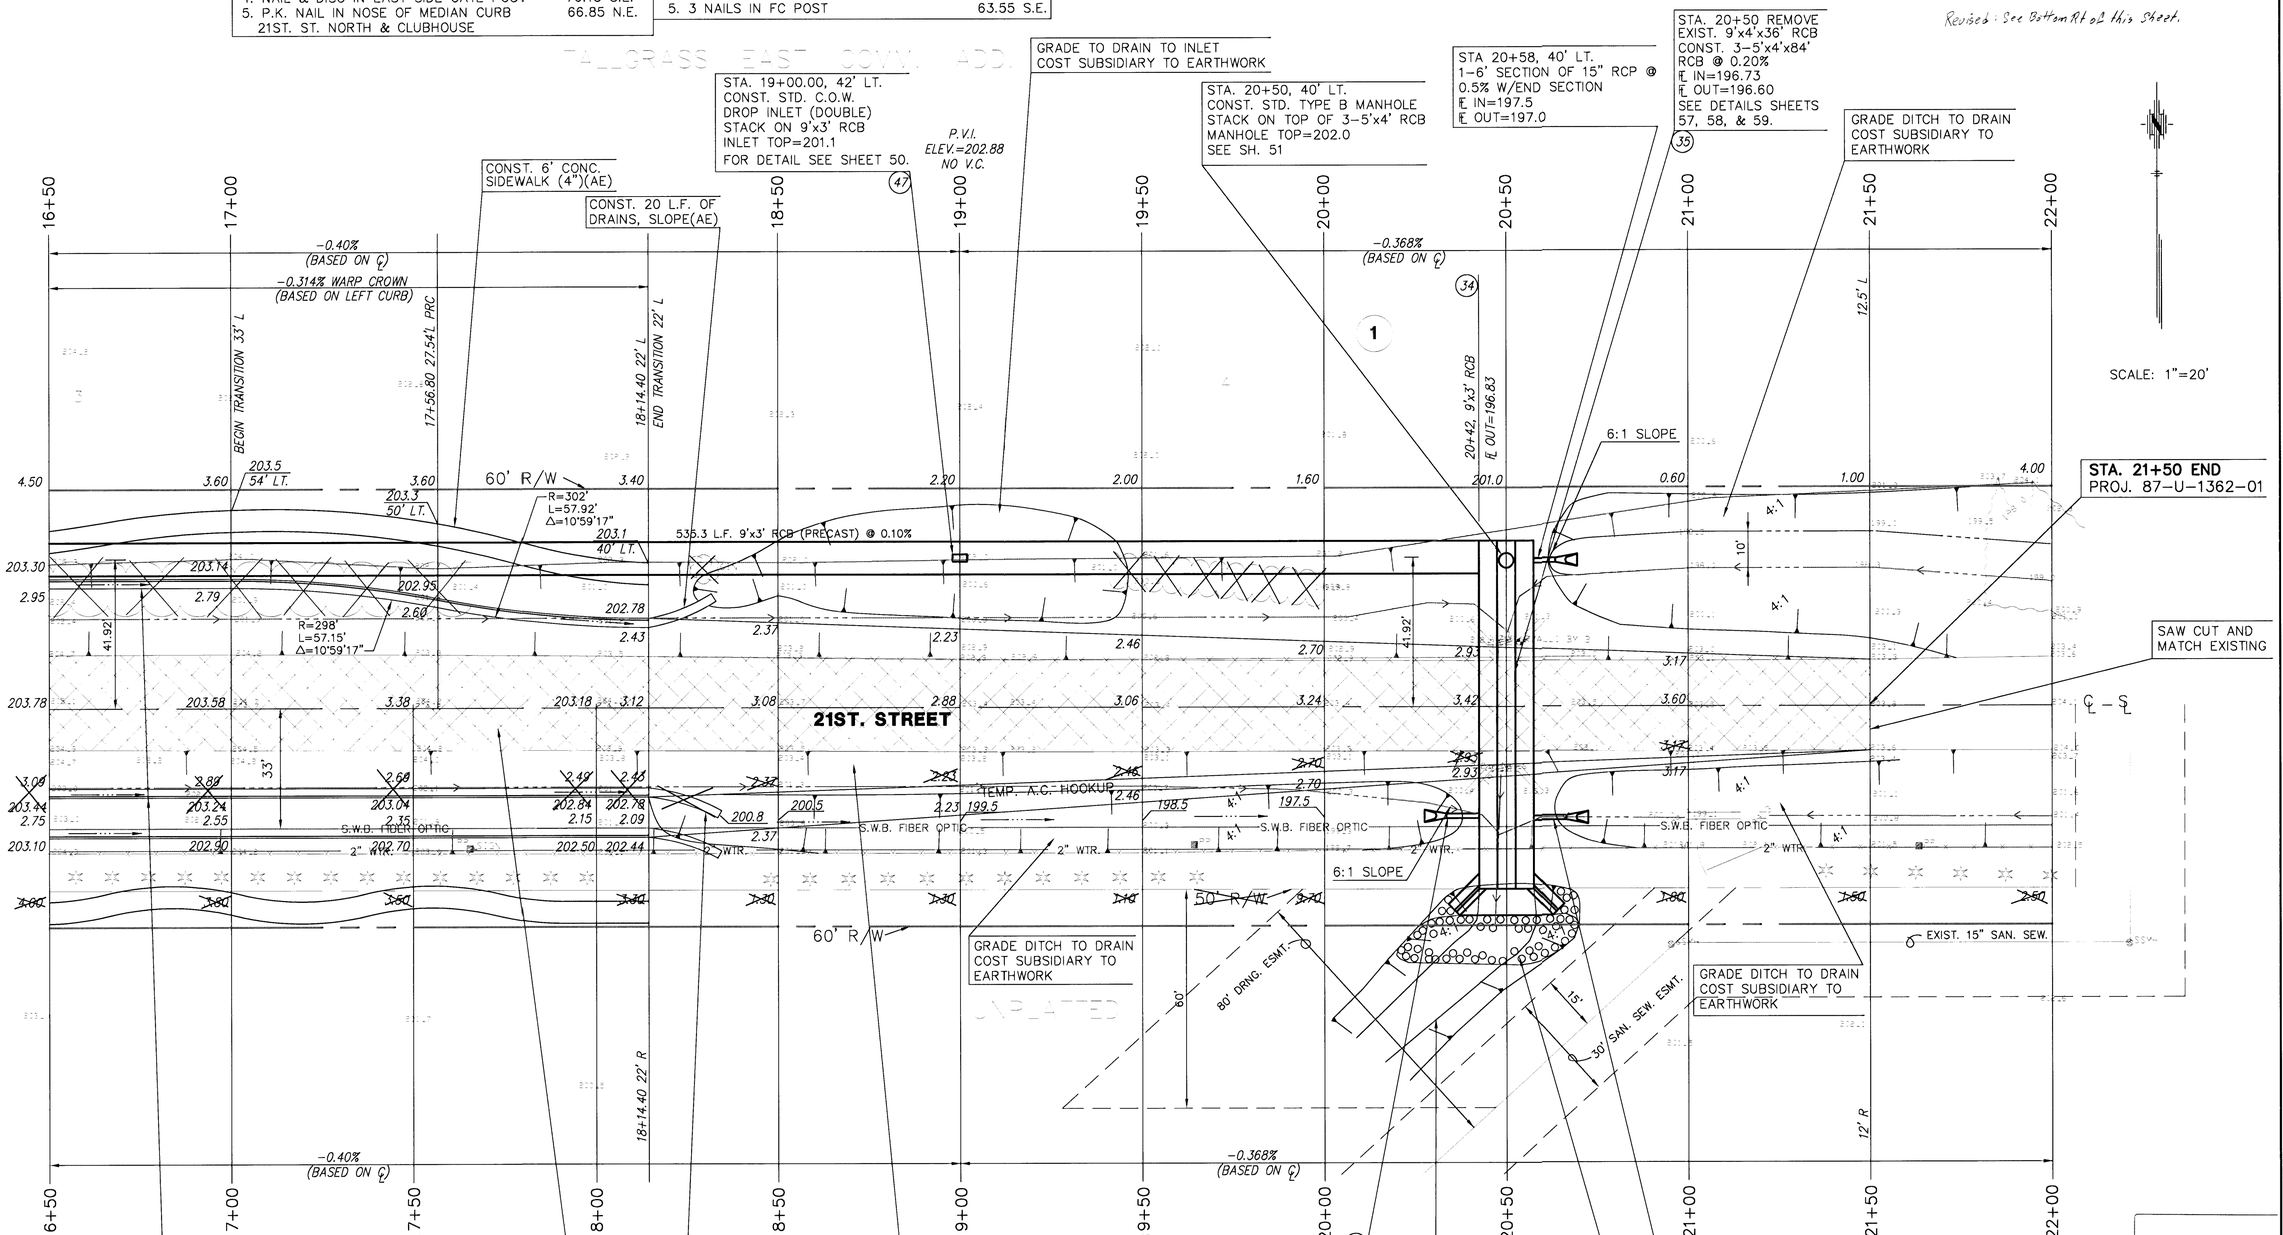

LEGEND
PAVEMENT, DRIVEWAY AND/OR SIDEWALK REMOVAL.

KANSAS GAS & ELECTRIC (K.G.&E.)	264-1141
RURAL WATER DISTRICT	832-0213
SOUTHWESTERN BELL TELEPHONE CO.	1-571-2611

B.M. #11 "□" CUT ON NORTHEAST CORNER OF R.C.B. UNDER 21ST. STREET NORTH, 18' RT., STATION 20+53.75 ELEV.=202.580

REVISED 11/01/93

KANSAS DEPARTMENT OF TRANSPORTATION

21ST. STREET NORTH
16+50 TO 22+00

PROJECT NO. 87-U-1362-01 SEDGWICK CO.

MID-KANSAS ENGINEERING CONSULTANTS, INC.
WICHITA, KANSAS

DESIGNED BY:	GJA	CHECKED BY:	DLH & KJS
DRAWN BY:	WNJ	DATE:	SHEET 35 OF 149

9156-17C