


FHWA REGION NO.	STATE	PROJECT NO.	YEAR	SHEET NO.	TOTAL SHEETS
7	KS.	87-U-1362-01	1993	33	149

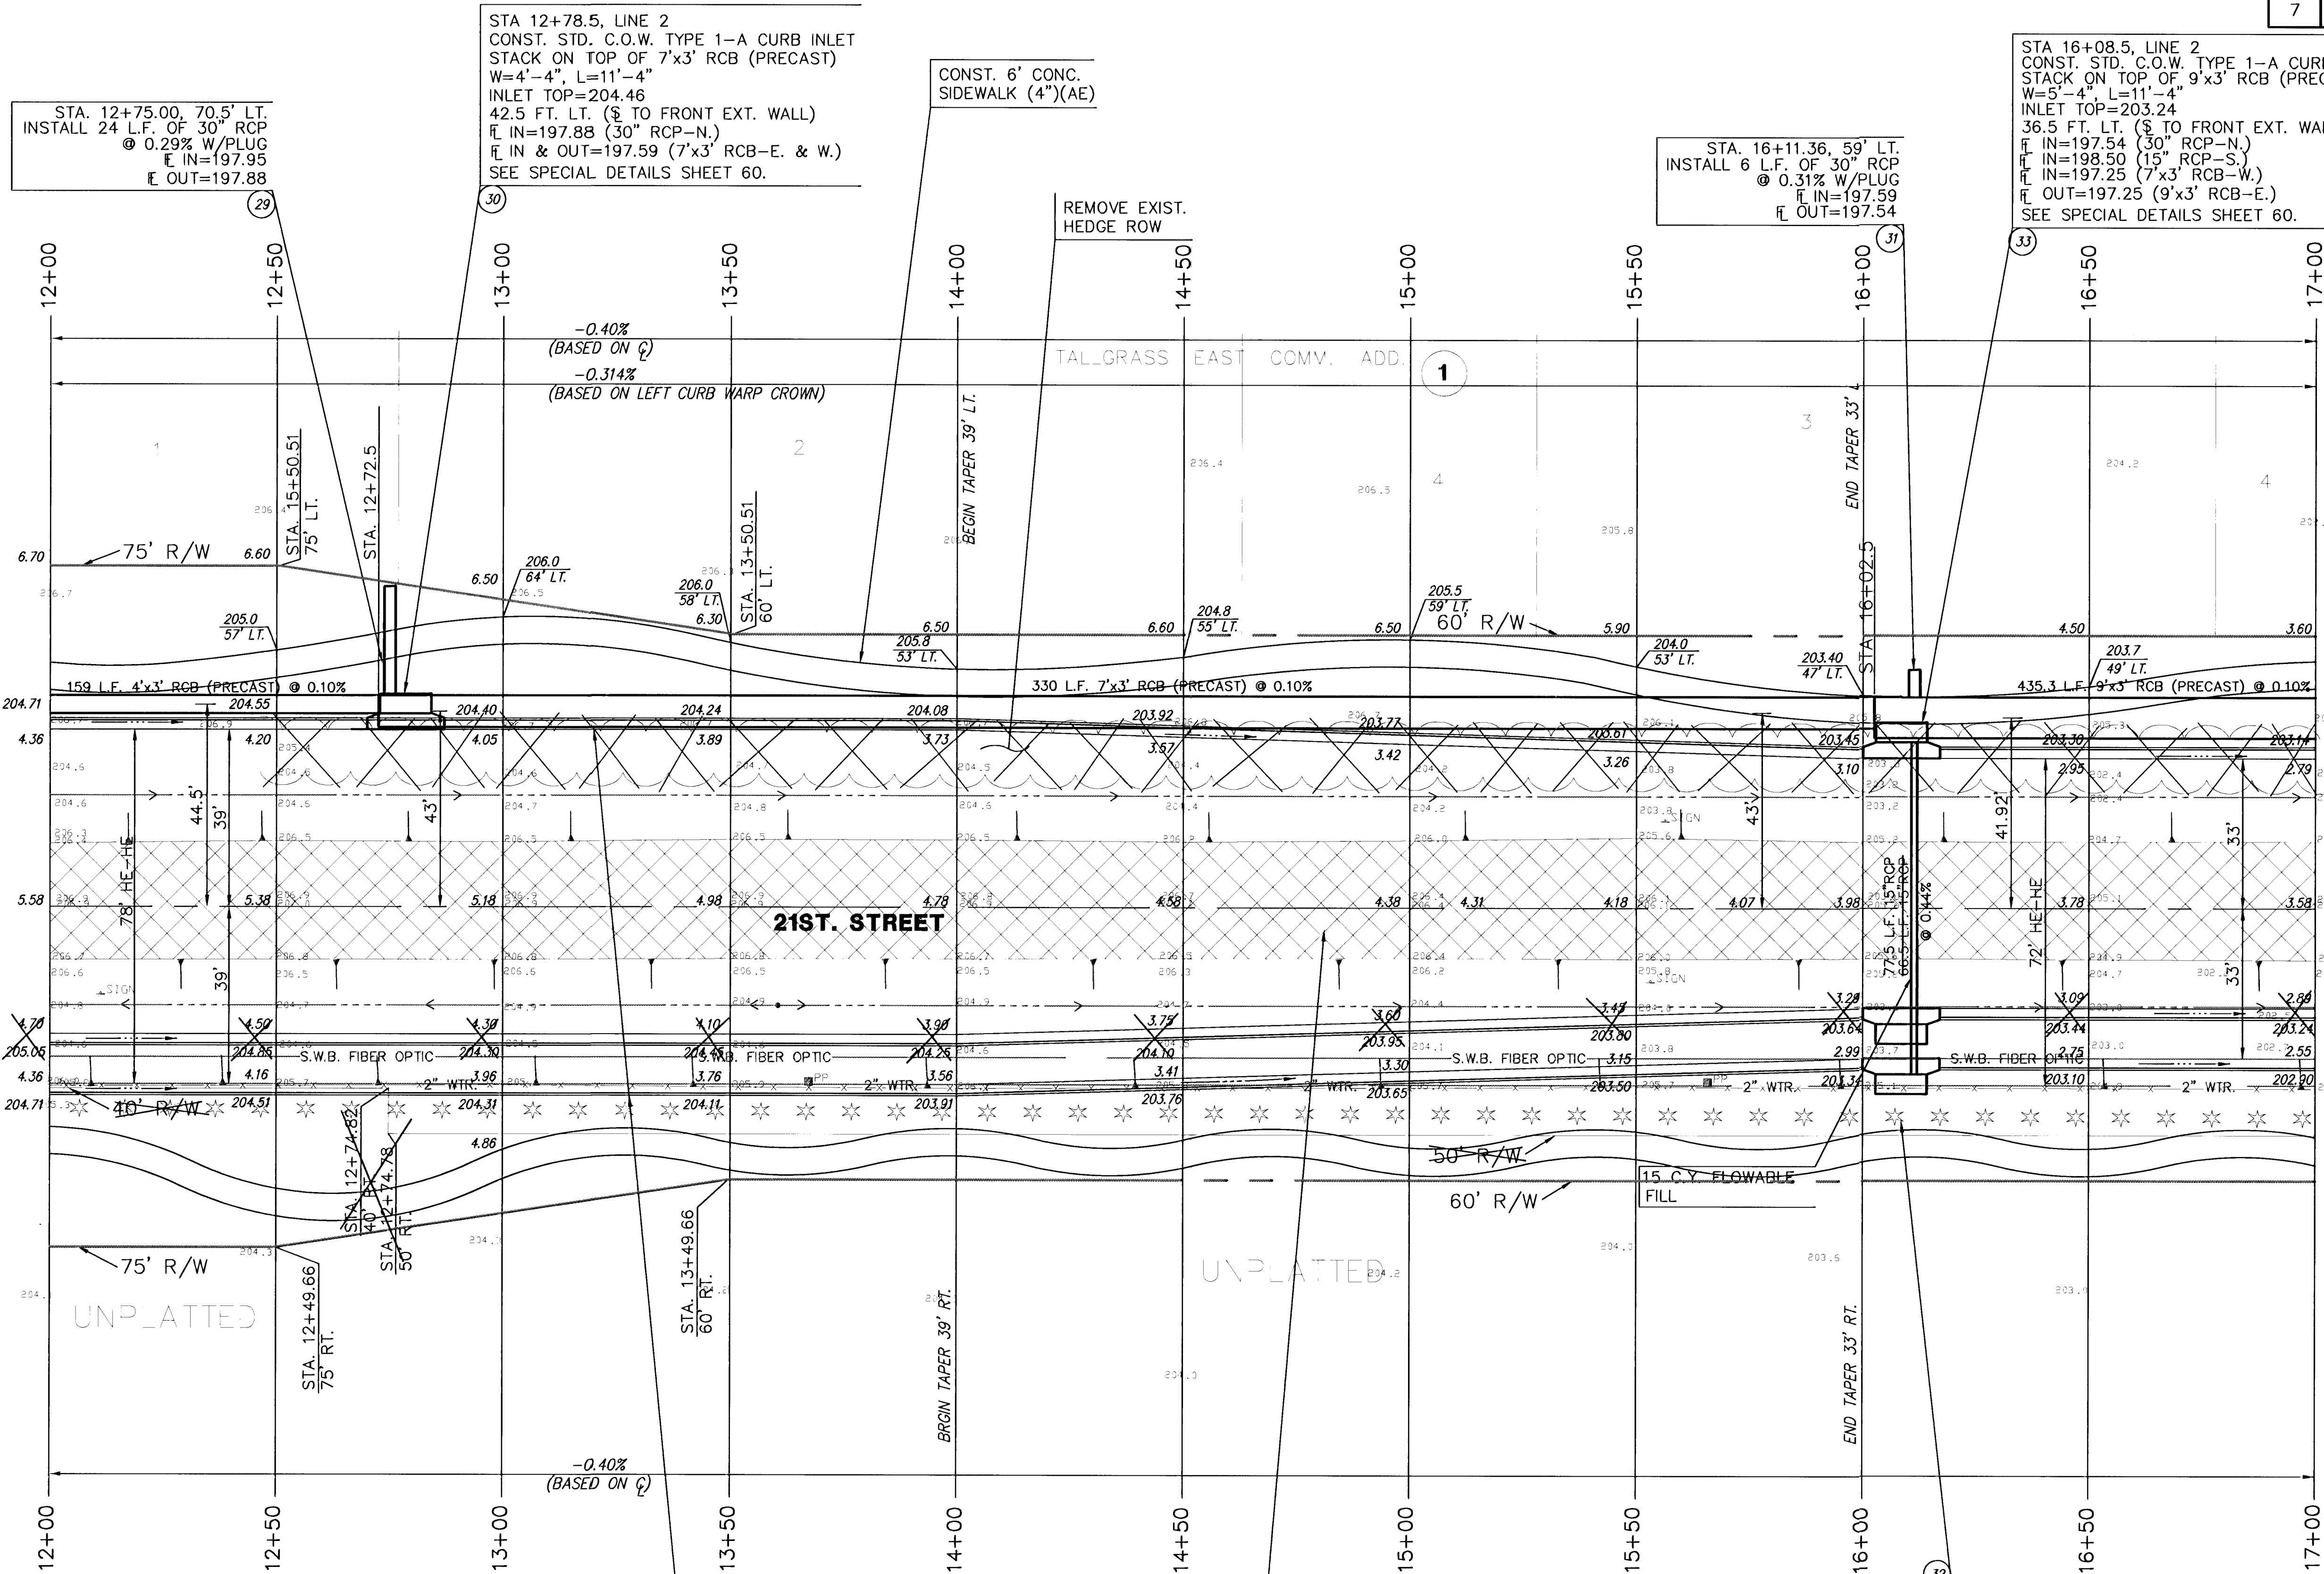


STA. 12+75.00, 70.5' LT.
INSTALL 24 L.F. OF 30" RCP
@ 0.29% W/PLUG
E IN=197.95
E OUT=197.88

STA 12+78.5, LINE 2
CONST. STD. C.O.W. TYPE 1-A CURB INLET
STACK ON TOP OF 7'x3' RCB (PRECAST)
W=4'-4", L=11'-4"
INLET TOP=204.46
42.5 FT. LT. (S TO FRONT EXT. WALL)
E IN=197.88 (30" RCP-N.)
E IN & OUT=197.59 (7'x3' RCB-E. & W.)
SEE SPECIAL DETAILS SHEET 60.

CONST. 6' CONC.
SIDEWALK (4") (AE)

STA. 16+11.36, 59' LT.
INSTALL 6 L.F. OF 30" RCP
@ 0.31% W/PLUG
E IN=197.59
E OUT=197.54

STA 16+08.5, LINE 2
CONST. STD. C.O.W. TYPE 1-A CURB INLET
STACK ON TOP OF 9'x3' RCB (PRECAST)
W=5'-4", L=11'-4"
INLET TOP=203.24
36.5 FT. LT. (S TO FRONT EXT. WALL)
E IN=197.54 (30" RCP-N.)
E IN=198.50 (15" RCP-S.)
E IN=197.25 (7'x3' RCB-W.)
E OUT=197.25 (9'x3' RCB-E.)
SEE SPECIAL DETAILS SHEET 60.

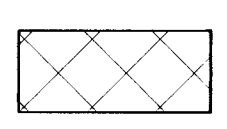

LEGEND
PAVEMENT, DRIVEWAY AND/OR
SIDEWALK REMOVAL.

REVISED 11/01/93

KANSAS DEPARTMENT OF TRANSPORTATION

21ST. STREET NORTH 12+00 TO 17+00

PROJECT NO. 87-U-1362-01 SEDGWICK CO.

MID-KANSAS ENGINEERING CONSULTANTS, INC.

WICHITA, KANSAS

DESIGNED BY:	GJA	CHECKED BY:	DLH & KJS
DRAWN BY:	WNJ	DATE:	SHEET 33 OF 149