


FHWA REGION NO.	STATE	PROJECT NO.	YEAR	SHEET NO.	TOTAL SHEETS
7	KANSAS	87-U-1362-01	1993	117	149

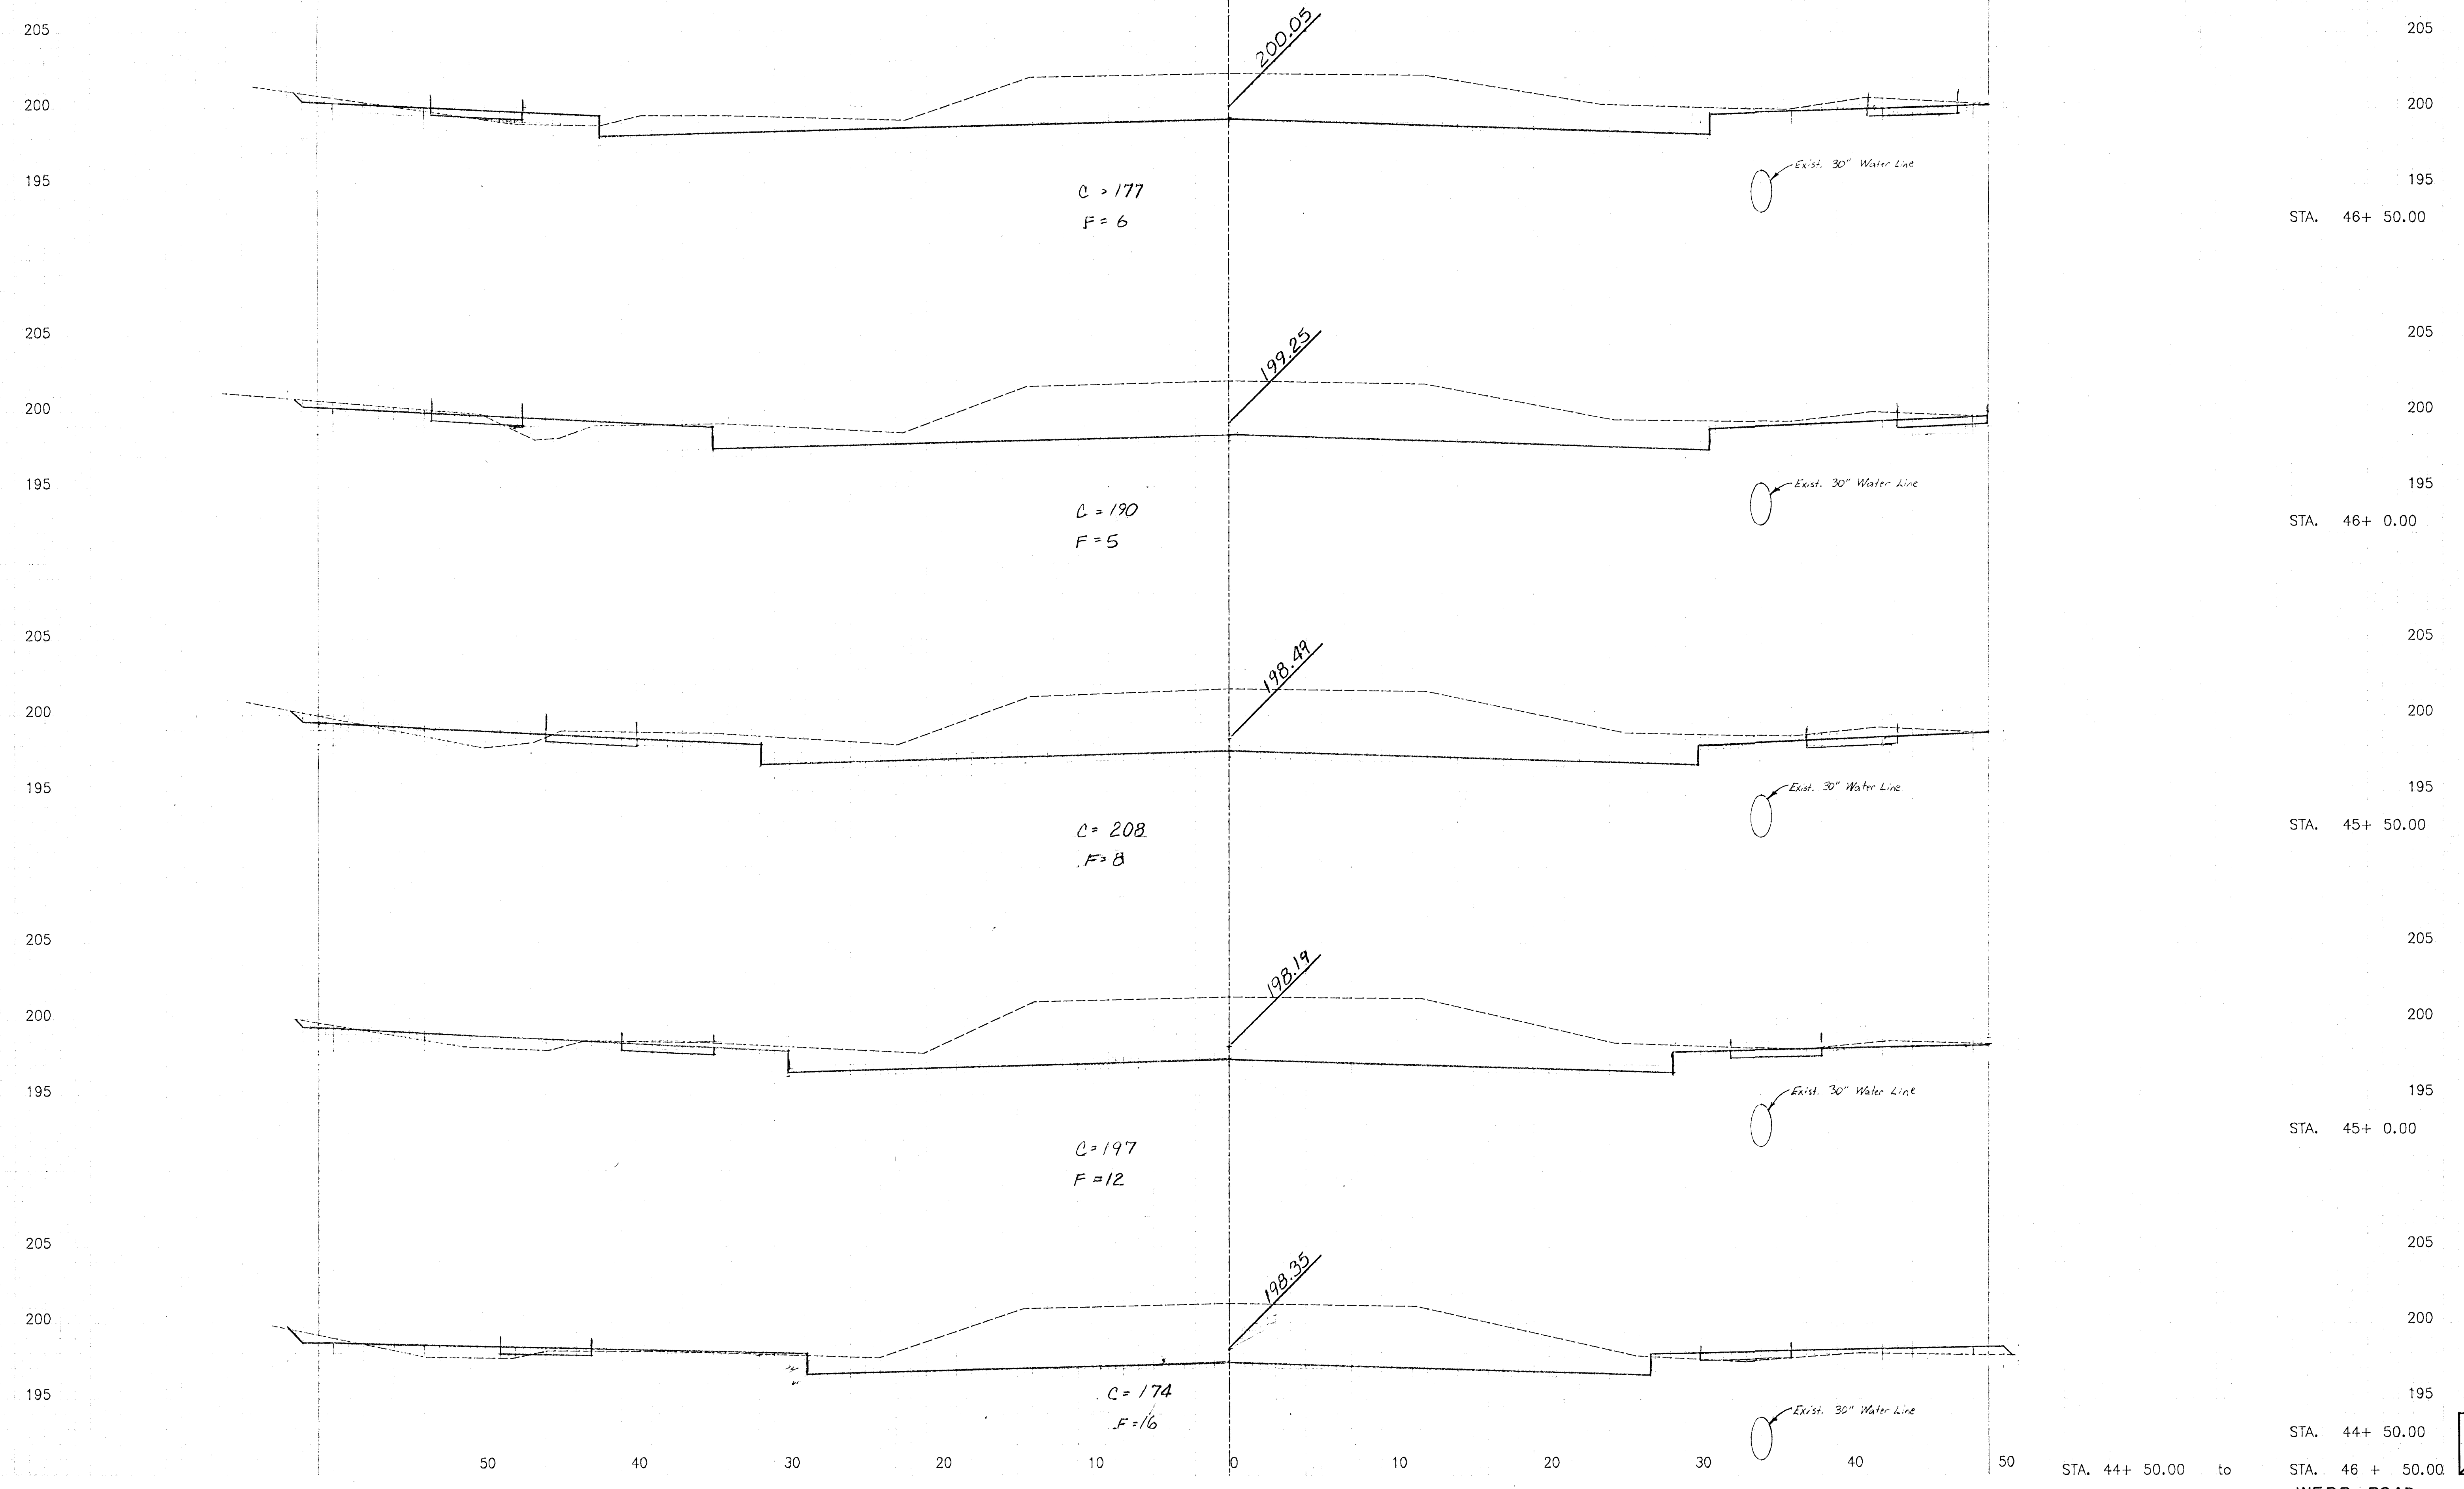

STA. 44+ 50.00 to STA. 46 + 50.00

WEBB ROAD

117
149