



PLOTTED: Wednesday, May 02, 2018 @ 02:01PM

J:\PROJECTS\2017\1701010567_COW_STRYKER_170567 CAD\SH1505 CIVIL\PAV\SIDEWALK AND FENCING\170567_05_1201.DWG

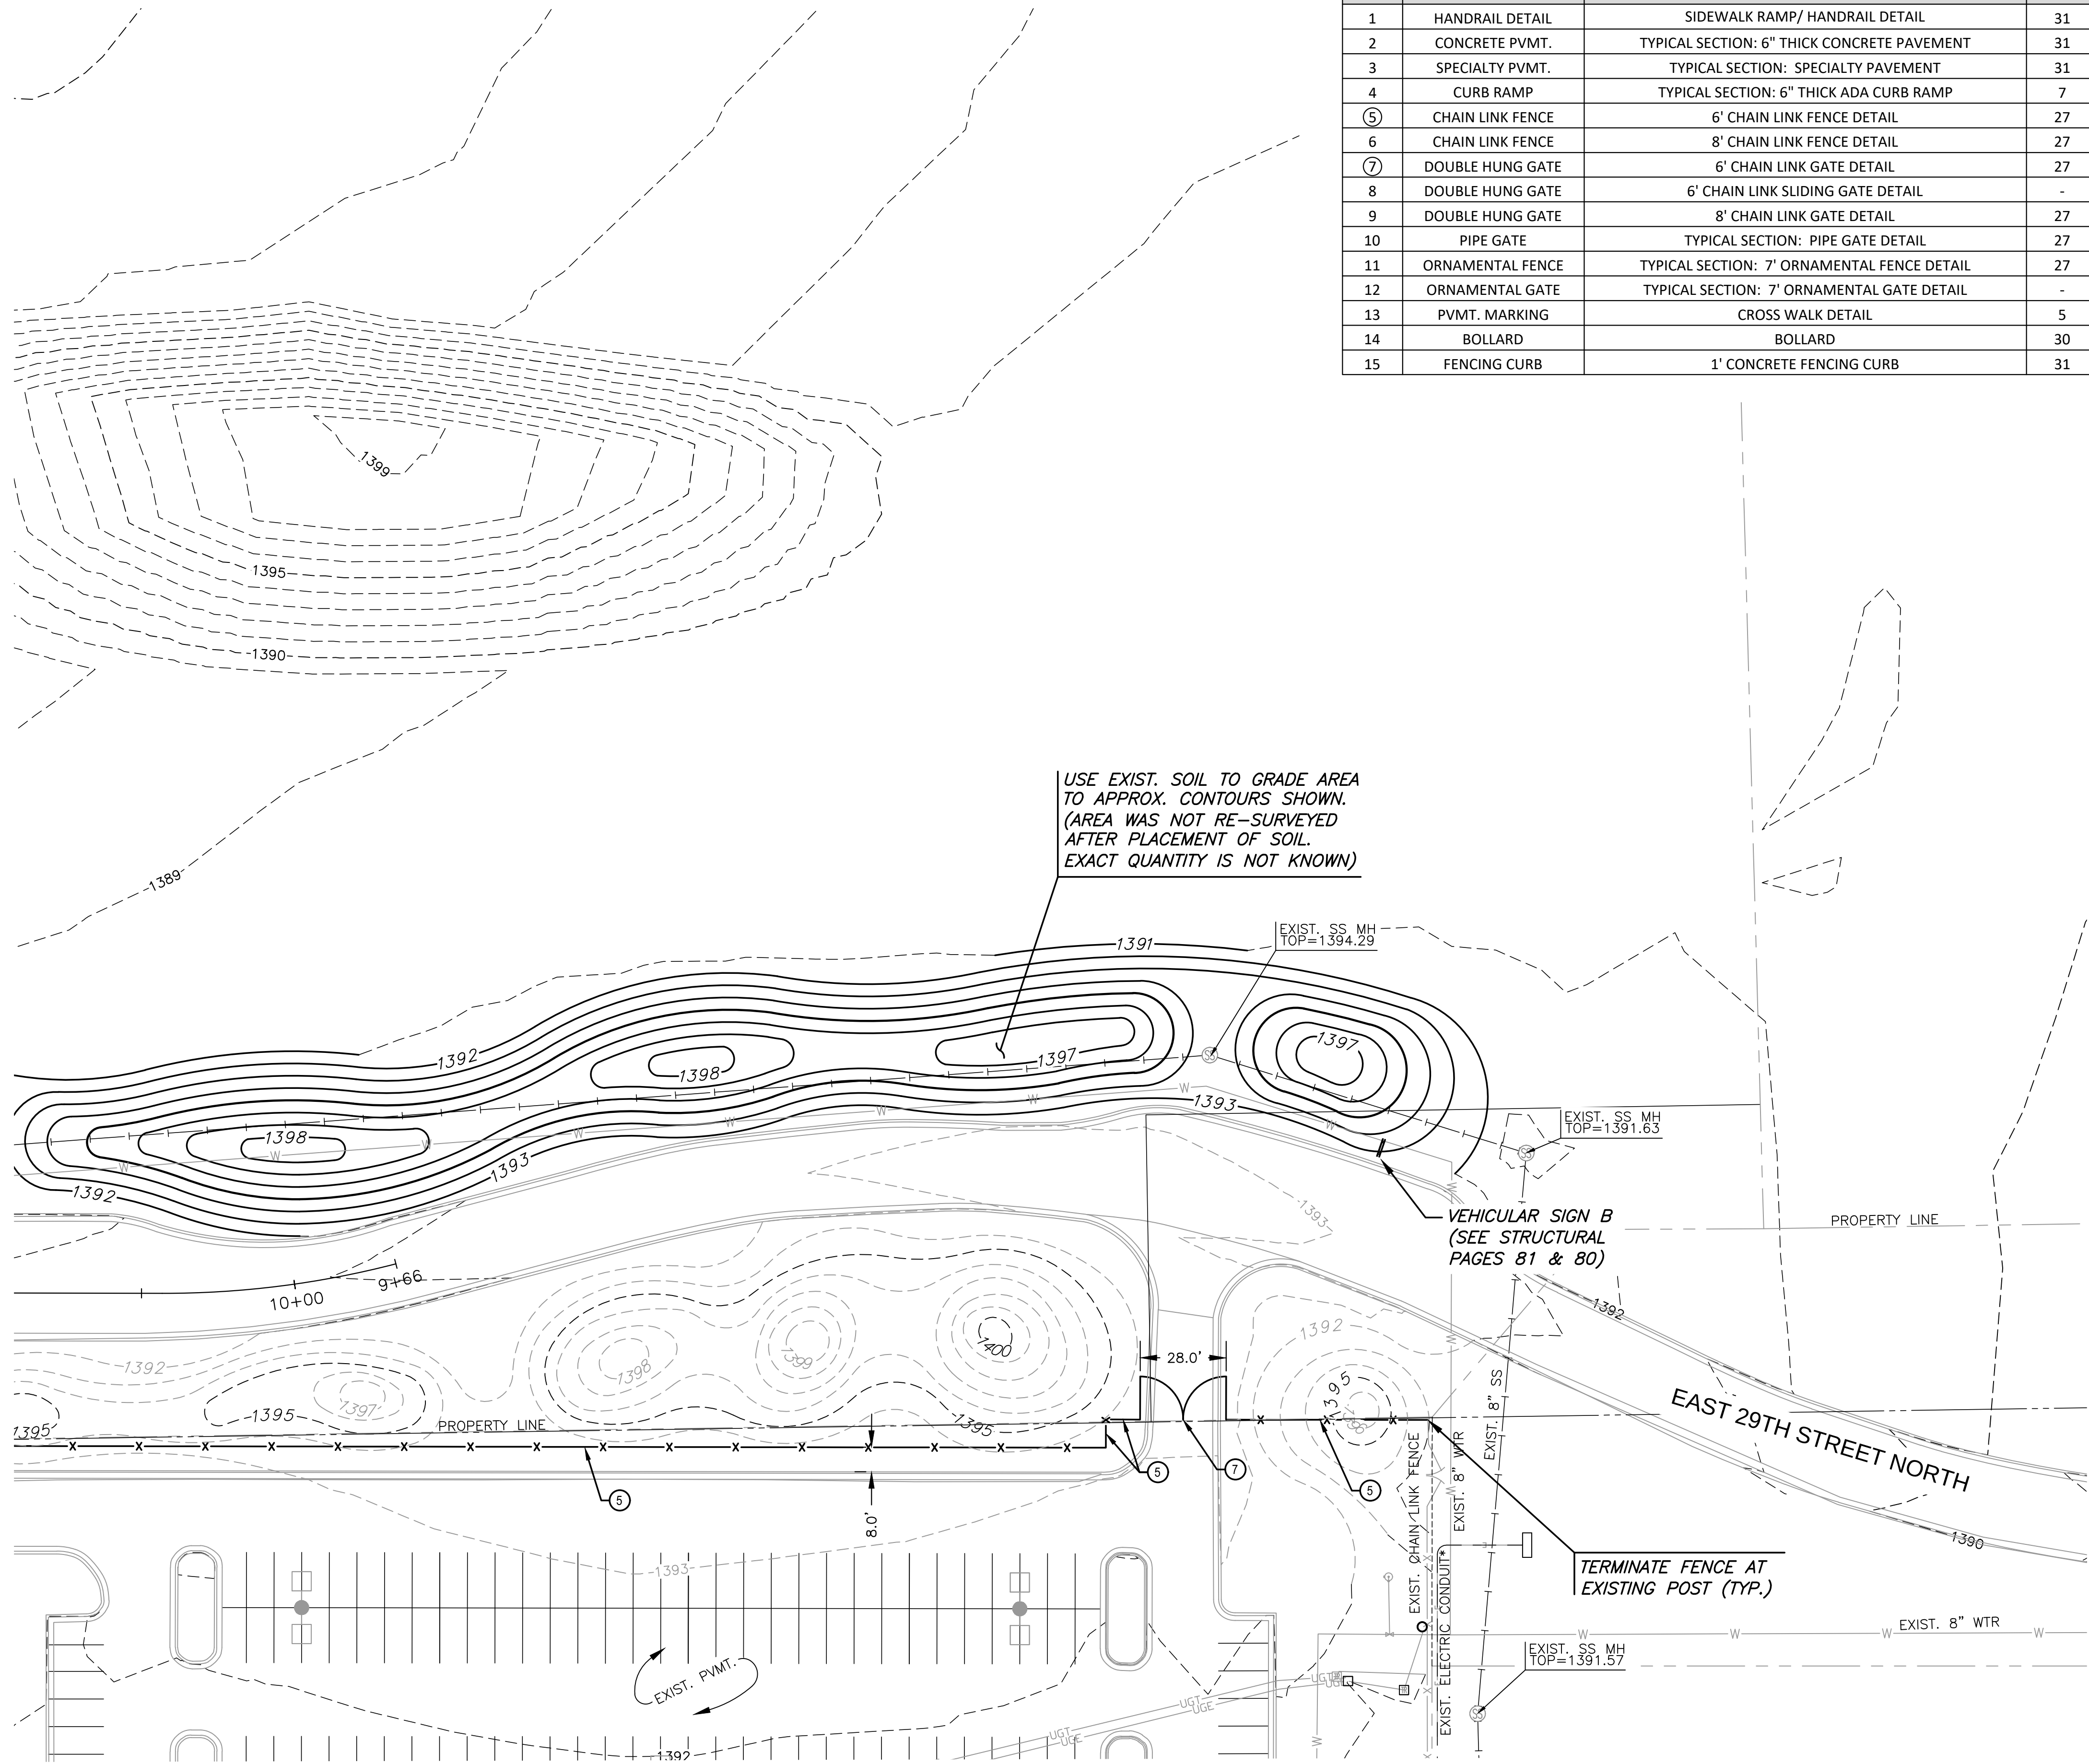


DETAIL LEGEND				
KEY	DETAIL	DESCRIPTION	SHEET	DETAIL NO.
1	HANDRAIL DETAIL	SIDEWALK RAMP/ HANDRAIL DETAIL	31	1
2	CONCRETE PVMT.	TYPICAL SECTION: 6" THICK CONCRETE PAVEMENT	31	3
3	SPECIALTY PVMT.	TYPICAL SECTION: SPECIALTY PAVEMENT	31	5
4	CURB RAMP	TYPICAL SECTION: 6" THICK ADA CURB RAMP	7	1
⑤	CHAIN LINK FENCE	6' CHAIN LINK FENCE DETAIL	27	4
6	CHAIN LINK FENCE	8' CHAIN LINK FENCE DETAIL	27	4
⑦	DOUBLE HUNG GATE	6' CHAIN LINK GATE DETAIL	27	3
8	DOUBLE HUNG GATE	6' CHAIN LINK SLIDING GATE DETAIL	-	-
9	DOUBLE HUNG GATE	8' CHAIN LINK GATE DETAIL	27	3
10	PIPE GATE	TYPICAL SECTION: PIPE GATE DETAIL	27	1
11	ORNAMENTAL FENCE	TYPICAL SECTION: 7' ORNAMENTAL FENCE DETAIL	27	2
12	ORNAMENTAL GATE	TYPICAL SECTION: 7' ORNAMENTAL GATE DETAIL	-	-
13	PVMT. MARKING	CROSS WALK DETAIL	5	1
14	BOLLARD	BOLLARD	30	1
15	FENCING CURB	1' CONCRETE FENCING CURB	31	4

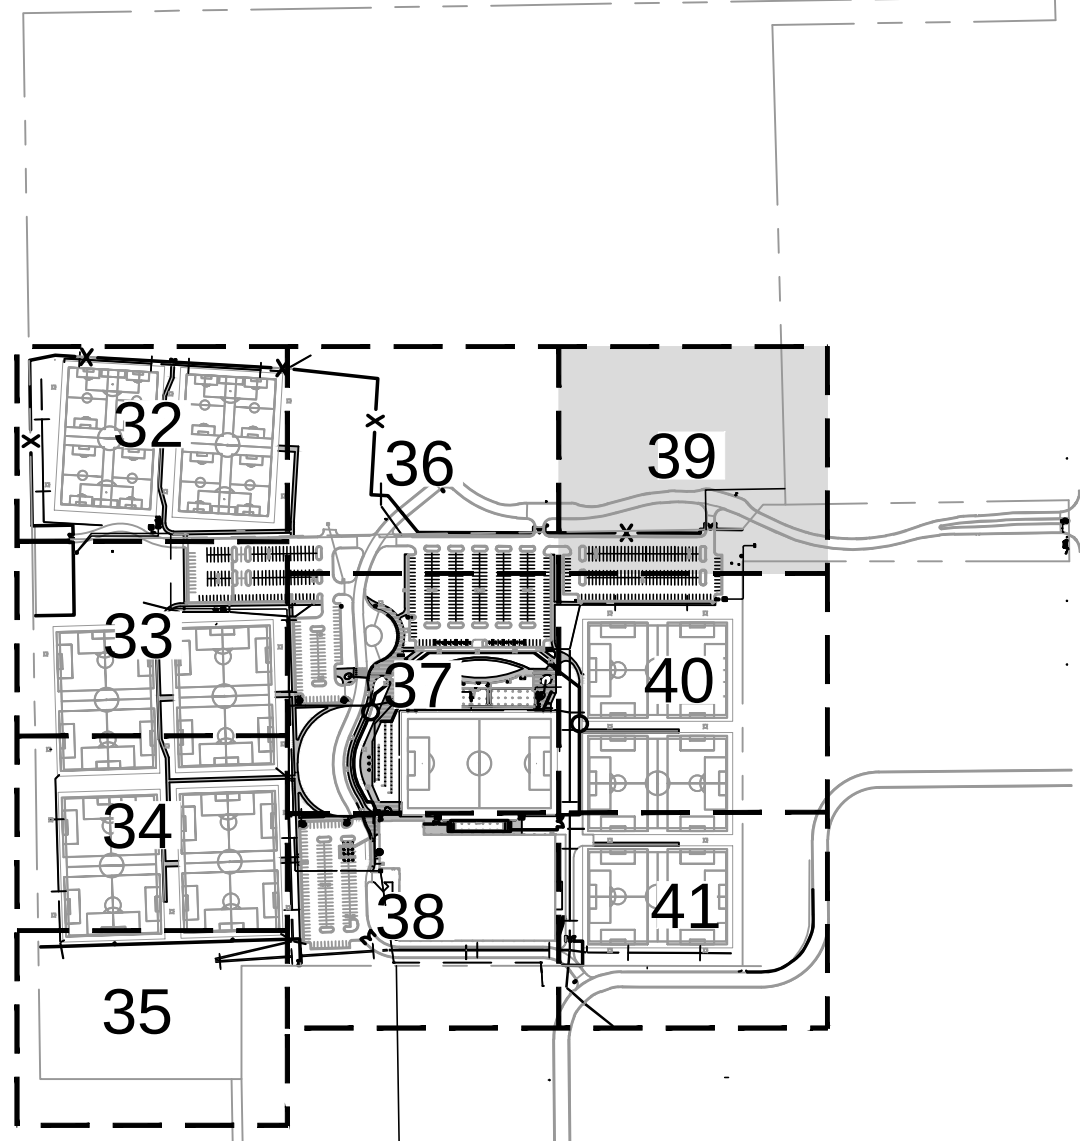

LOCATION MAP

LEGEND

- EXISTING SANITARY SEWER
- EXISTING GAS LINE
- EXISTING WATER LINE
- EXISTING STORM SEWER
- PROPOSED STORM SEWER
- PROPOSED UNDERDRAIN
- PROPOSED ELEC. CONDUIT (SCHEMATIC)
- PROPOSED GRADES
- EXISTING GRADES
- GRADING LIMITS
- ORNAMENTAL FENCE
- CHAINLINK FENCE
- SLOPE ARROW
- SPOT ELEVATION
- PROP. PICNIC TABLE
- PROP. TRASH RECEPTACLE
- PROP. FLAGPOLE

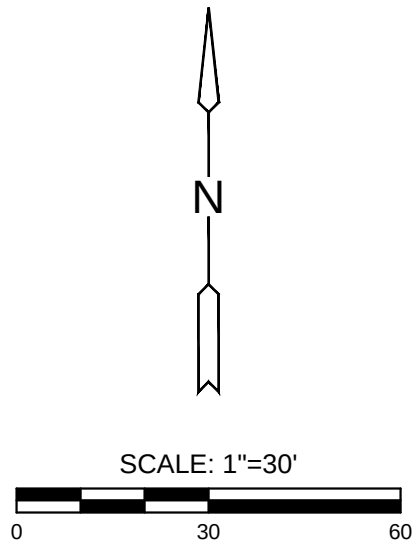

PAVING, LANDSCAPE & UTILITIES FOR
STRYKER SPORTS
WICHITA, KANSAS



©2018
MKEC Engineering
All Rights Reserved
www.mkec.com
These drawings and their contents, including, but not limited to, all concepts, designs, & ideas are the exclusive property of MKEC Engineering (MKEC), and may not be used or reproduced in any way without the express consent of MKEC.

SITE PLAN 39

PROJECT NO.	1701010567	
DATE	MAY 2, 2018	
SCALE	1" = 30'	
DESIGNED	DRAWN	CHECKED
JAG	CRM	MAB

0	ISSUED FOR CONST.	05-02-18
NO.	REVISION	DATE

SHEET NO.